

ROOF PLAN
SCALE: 1/8" = 1'-0"

AS-BUILT CONDITION
WASHINGTON METROPOLITAN AREA TRANSIT AUTHORITY
DATE: 11/11/93
BY: JAMES MADISON CUTTS

WASHINGTON METROPOLITAN AREA TRANSIT AUTHORITY
OPERATIONS CONTROL CENTER BUILDING
ROOF PLAN
DATE: 11/11/93
BY: JAMES MADISON CUTTS

WASHINGTON METROPOLITAN AREA TRANSIT AUTHORITY
OPERATIONS CONTROL CENTER BUILDING
ROOF PLAN
DATE: 11/11/93
BY: JAMES MADISON CUTTS


WASHINGTON METROPOLITAN AREA TRANSIT AUTHORITY
OPERATIONS CONTROL CENTER BUILDING
ROOF PLAN
DATE: 11/11/93
BY: JAMES MADISON CUTTS

NO.	DATE	BY	DESCRIPTION
1	11/11/93	JAMES MADISON CUTTS	AS-BUILT CONDITION


WASHINGTON METROPOLITAN AREA TRANSIT AUTHORITY
OPERATIONS CONTROL CENTER BUILDING
ROOF PLAN
DATE: 11/11/93
BY: JAMES MADISON CUTTS

WASHINGTON METROPOLITAN AREA TRANSIT AUTHORITY
OPERATIONS CONTROL CENTER BUILDING
ROOF PLAN
DATE: 11/11/93
BY: JAMES MADISON CUTTS


WASHINGTON METROPOLITAN AREA TRANSIT AUTHORITY
OPERATIONS CONTROL CENTER BUILDING
ROOF PLAN
DATE: 11/11/93
BY: JAMES MADISON CUTTS

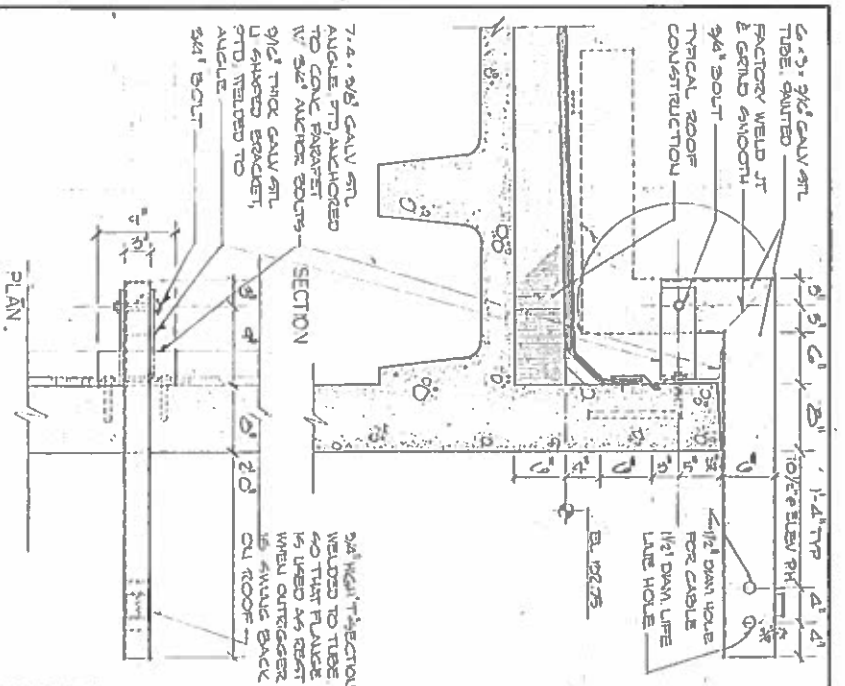





TYPICAL ROOF OUTRIGGER WHERE PARAPET IS ALIGNED WITH FACE OF SLAB
SCALE: 1/2"=1'-0"

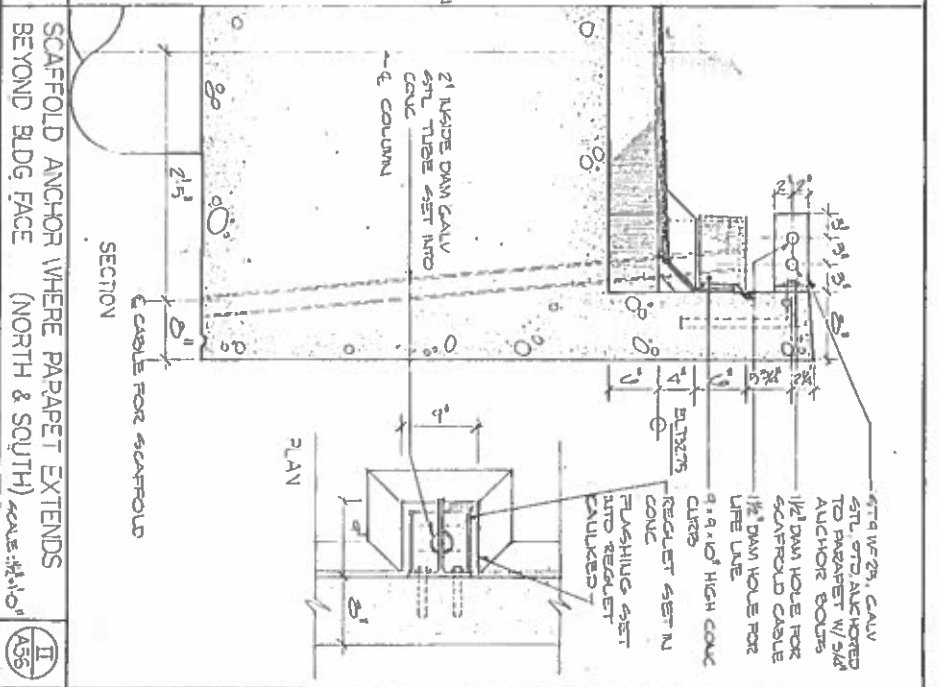

SCAFFOLD ANCHOR WHERE PARAPET EXTENDS BEYOND BLDG FACE (NORTH & SOUTH)
SCALE: 1/2"=1'-0"

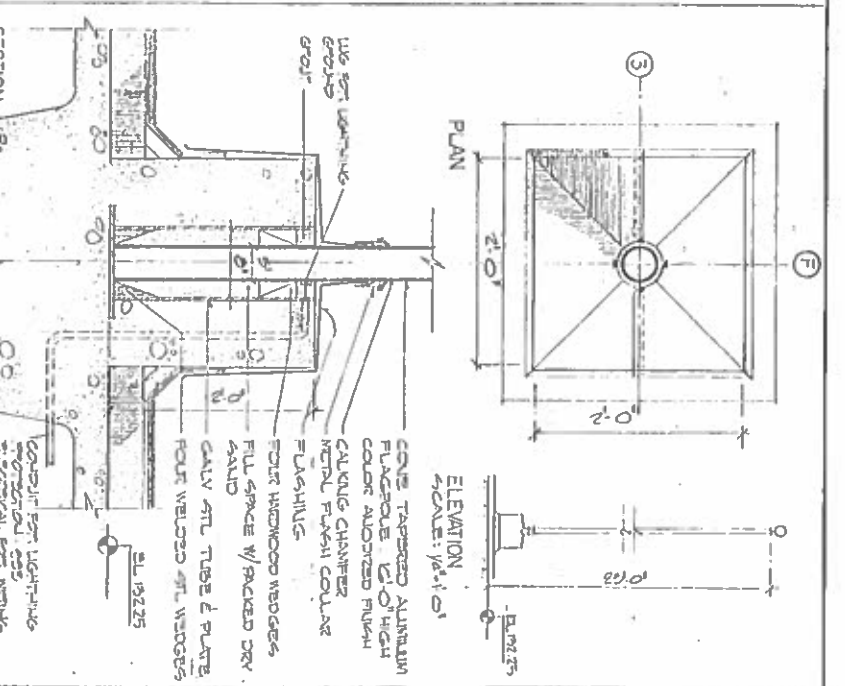

FLAG POLE DETAIL @ ROOF
SCALE: 1/2"=1'-0"

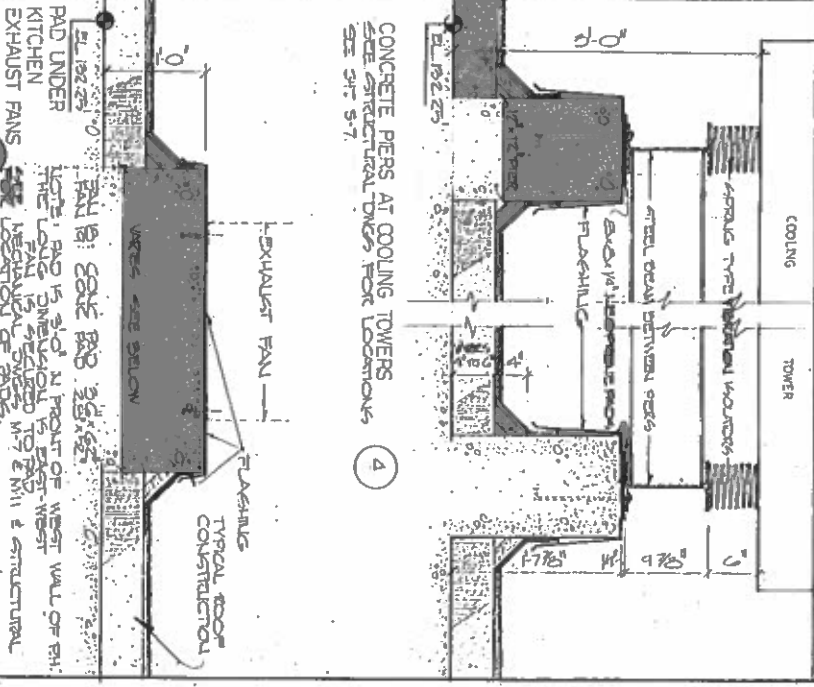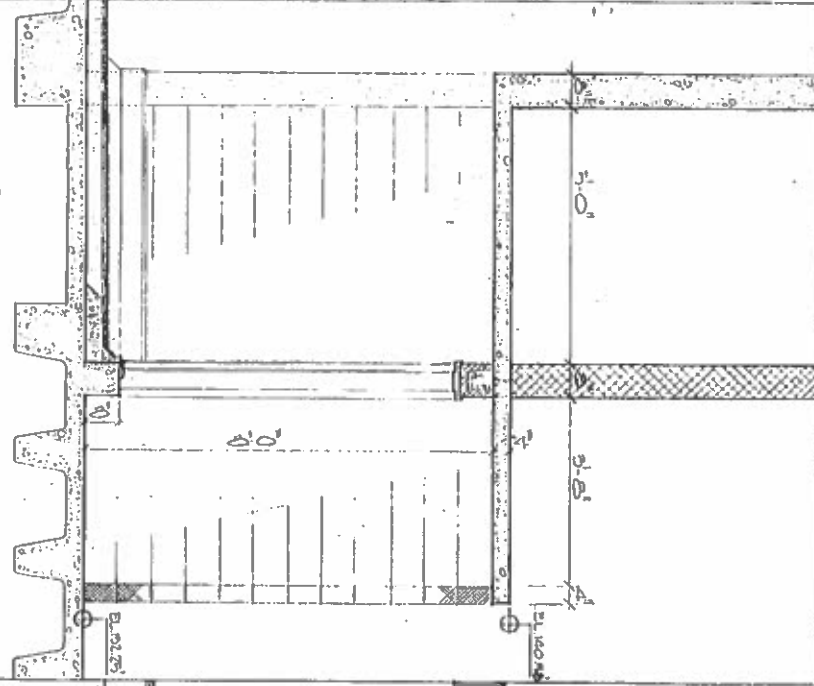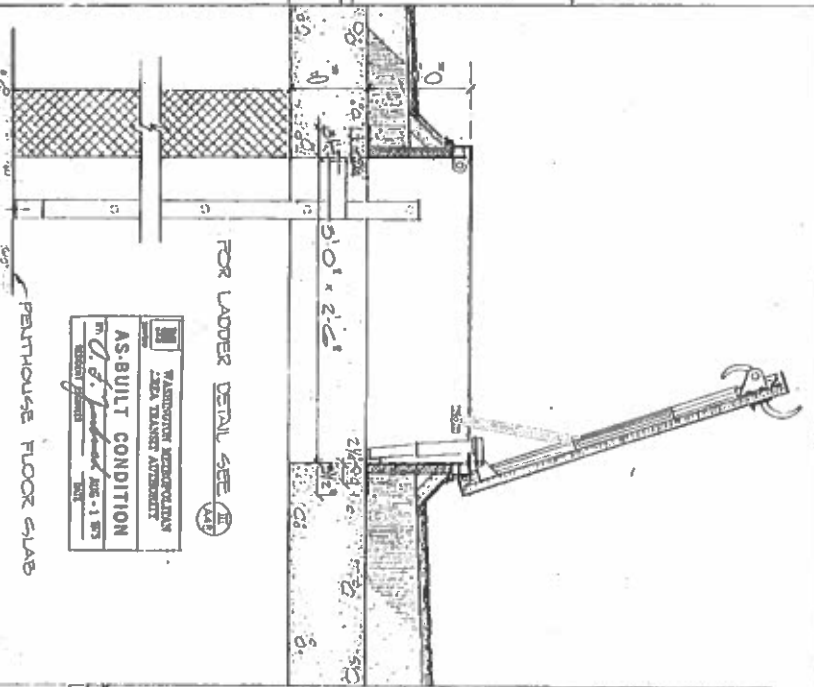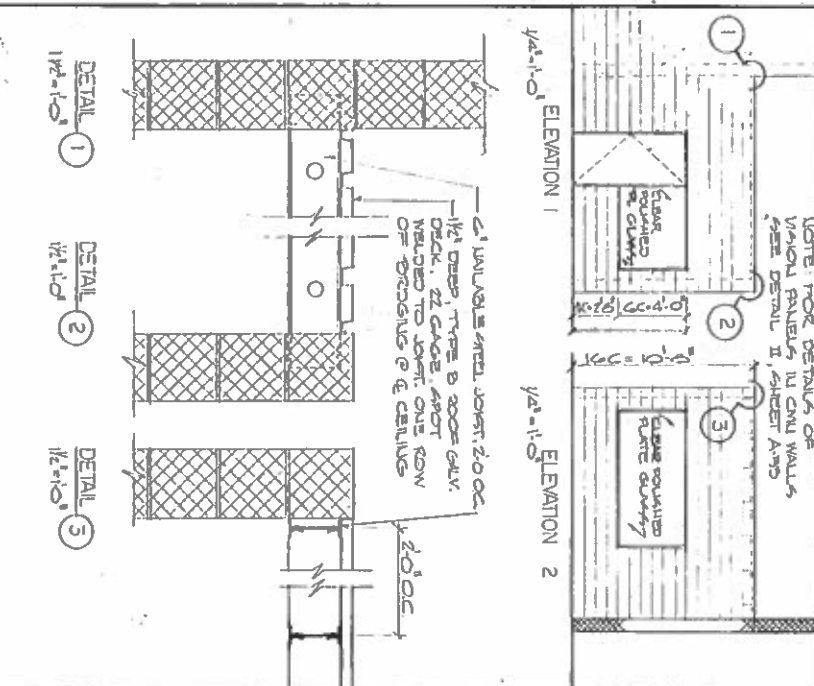

ROOF DRAIN DETAIL
SCALE: 1/2"=1'-0"

ENGINEERS OFFICE @ PENTHOUSE
SCALE: 1/2"=1'-0"

ROOF HATCH DETAIL @ PENTHOUSE ROOF
SCALE: 1/2"=1'-0"

SECTION @ EXTERIOR DOOR & CORRIDOR LEADING FROM STAR NO. 2 TO ROOF
SCALE: 3/4"=1'-0"

DETAILS: MECHANICAL EQUIPMENT SUPPORTS @ ROOF
SCALE: 1/2"=1'-0"


DESIGNED BY	DATE	BY	DESCRIPTION
4-27-71	7-22-71	AS	46 BUILT
CHECKED BY	DATE	BY	DESCRIPTION
5-1-71			
APPROVED BY	DATE	BY	DESCRIPTION

REVISIONS	NO.	DATE	DESCRIPTION


DESIGNED BY	DATE	BY	DESCRIPTION
4-27-71	7-22-71	AS	46 BUILT
CHECKED BY	DATE	BY	DESCRIPTION
5-1-71			
APPROVED BY	DATE	BY	DESCRIPTION

DESIGNED BY	DATE	BY	DESCRIPTION
4-27-71	7-22-71	AS	46 BUILT
CHECKED BY	DATE	BY	DESCRIPTION
5-1-71			
APPROVED BY	DATE	BY	DESCRIPTION


WASHINGTON METROPOLITAN AREA TRANSIT AUTHORITY
KEYES, LETHBRIDGE & CONDON - ARCHITECTS
200 ARCH BLDG
NO. A-282
APPROVED
DE LEMO, CARTER & COMPANY
GENERAL ENGINEERING CONSULTANTS
HARRY WEEBE & ASSOCIATES
GENERAL ARCHITECTURAL CONSULTANTS
SCALE: 1/2"=1'-0"
DRAWING NO. 00CB-A-36
M31-64

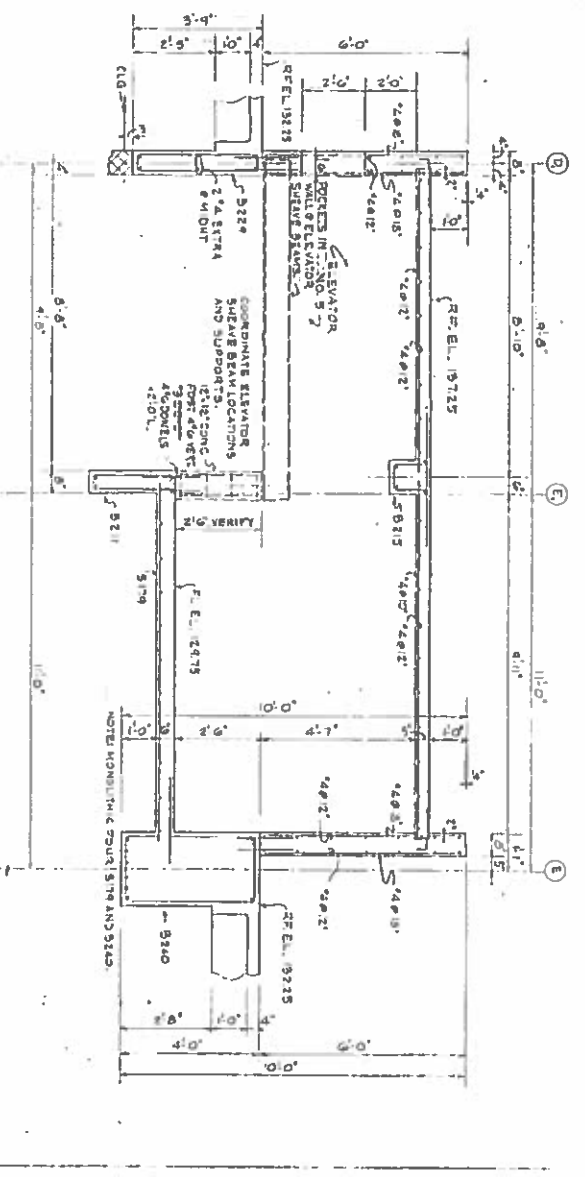


SECTION 1
SCALE: 1/4" = 1'-0"

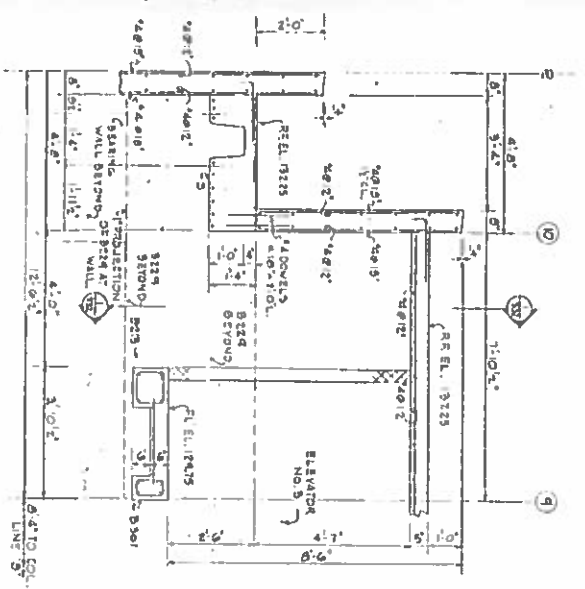


SECTION 2
SCALE: 1/4" = 1'-0"

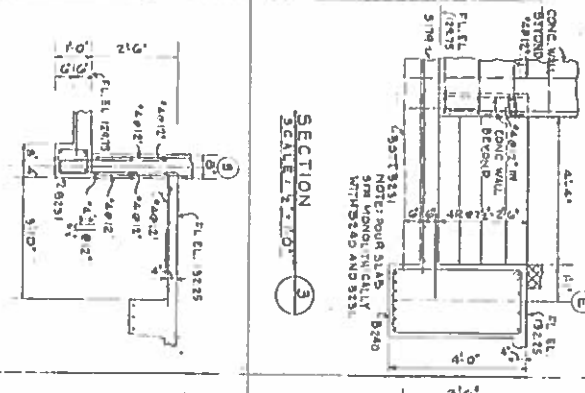


SECTION 3
SCALE: 1/4" = 1'-0"

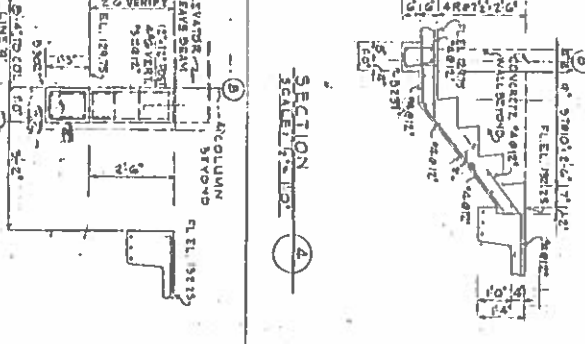


SECTION 4
SCALE: 1/4" = 1'-0"

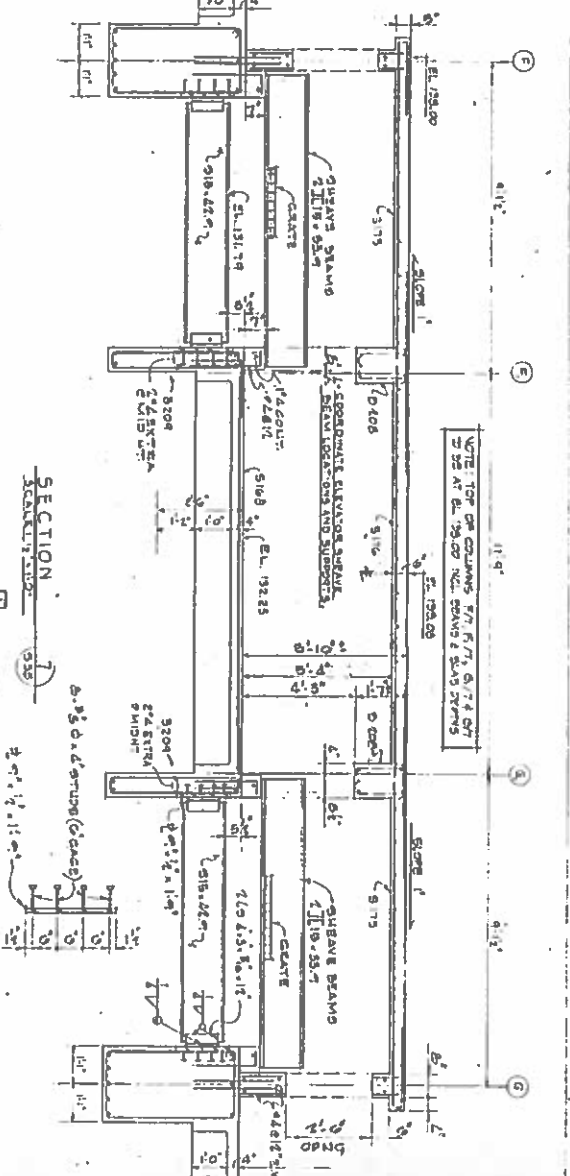


SECTION 5
SCALE: 1/4" = 1'-0"

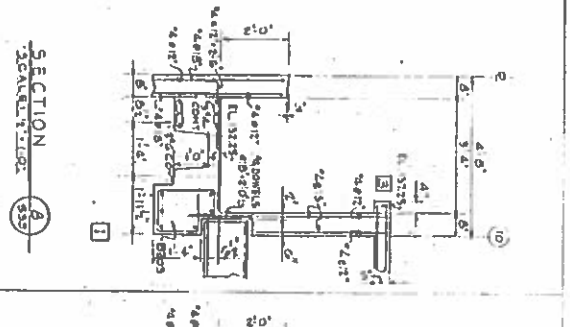


SECTION 6
SCALE: 1/4" = 1'-0"

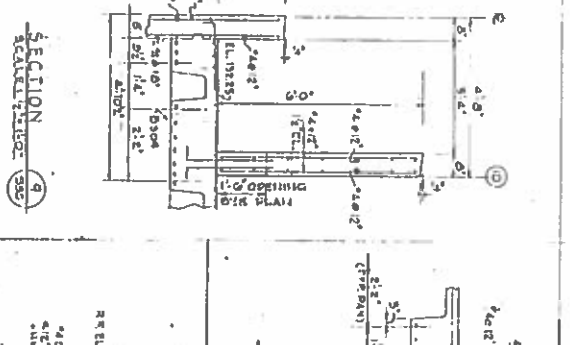


SECTION 7
SCALE: 1/4" = 1'-0"

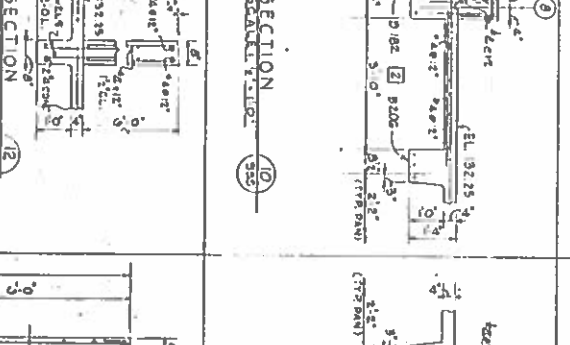


SECTION 8
SCALE: 1/4" = 1'-0"

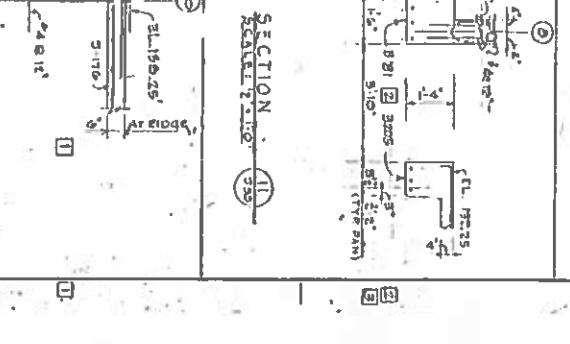


SECTION 9
SCALE: 1/4" = 1'-0"

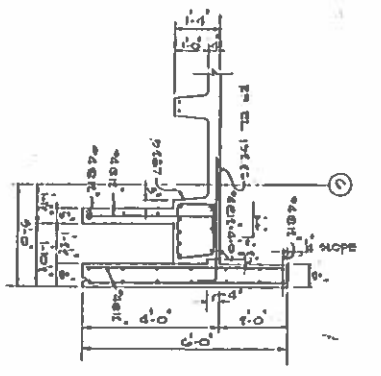


SECTION 10
SCALE: 1/4" = 1'-0"

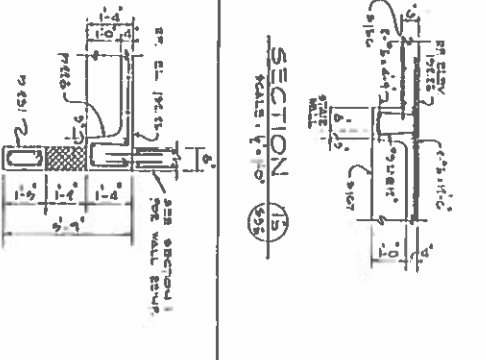


SECTION 11
SCALE: 1/4" = 1'-0"

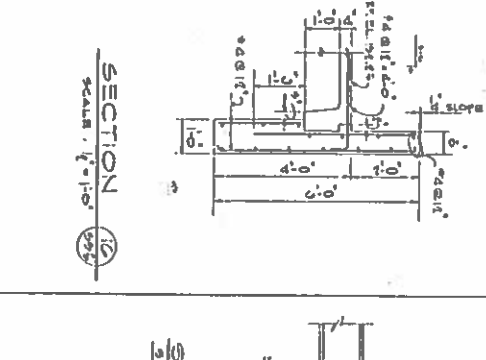


SECTION 12
SCALE: 1/4" = 1'-0"

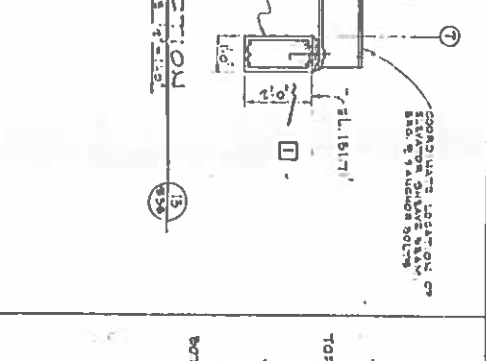


SECTION 13
SCALE: 1/4" = 1'-0"

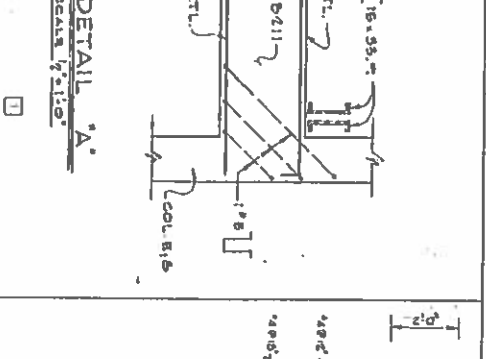


SECTION 14
SCALE: 1/4" = 1'-0"

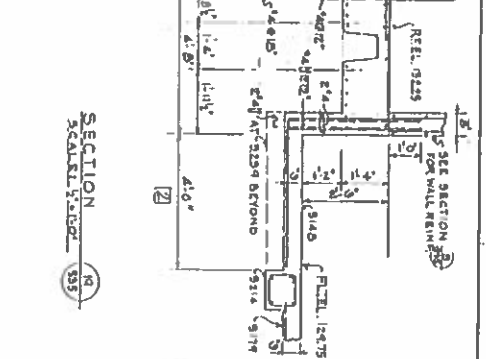

SECTION 15
SCALE: 1/4" = 1'-0"

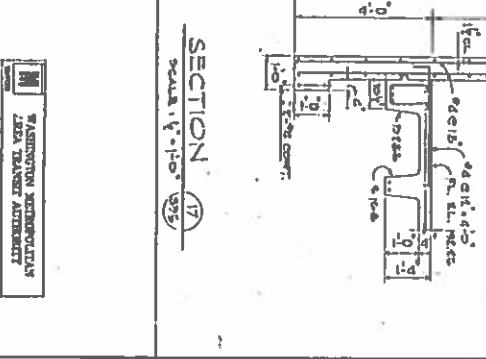

SECTION 16
SCALE: 1/4" = 1'-0"

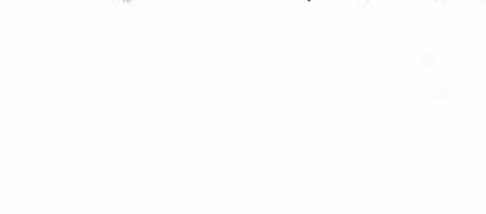


SECTION 17
SCALE: 1/4" = 1'-0"



DETAIL 'A'
SCALE: 1/2" = 1'-0"

WASHINGTON METROPOLITAN AREA TRANSIT AUTHORITY
AS-BUILT CONDITION


DESIGNED BY	DATE	REVISIONS	APPROVED BY
D. E. J. H.	4-23-53		J. C. HAY
CHECKED BY	DATE	DESCRIPTION	
D. E. J. H.	4-23-53	REVISED TO SHOW REVISIONS	
APPROVED BY	DATE	DESCRIPTION	
J. C. HAY	4-23-53	REVISED TO SHOW REVISIONS	

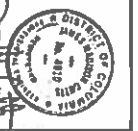

WASHINGTON METROPOLITAN AREA TRANSIT AUTHORITY
KEYES, LETHBRIDGE & CONDON - ARCHITECTS


DE LEW, CATYER & COMPANY
STRUCTURAL ENGINEERS

OPERATIONS CONTROL CENTER BUILDING
ROOF DETAILS
STRUCTURAL
DCCB-S-35-M31-108

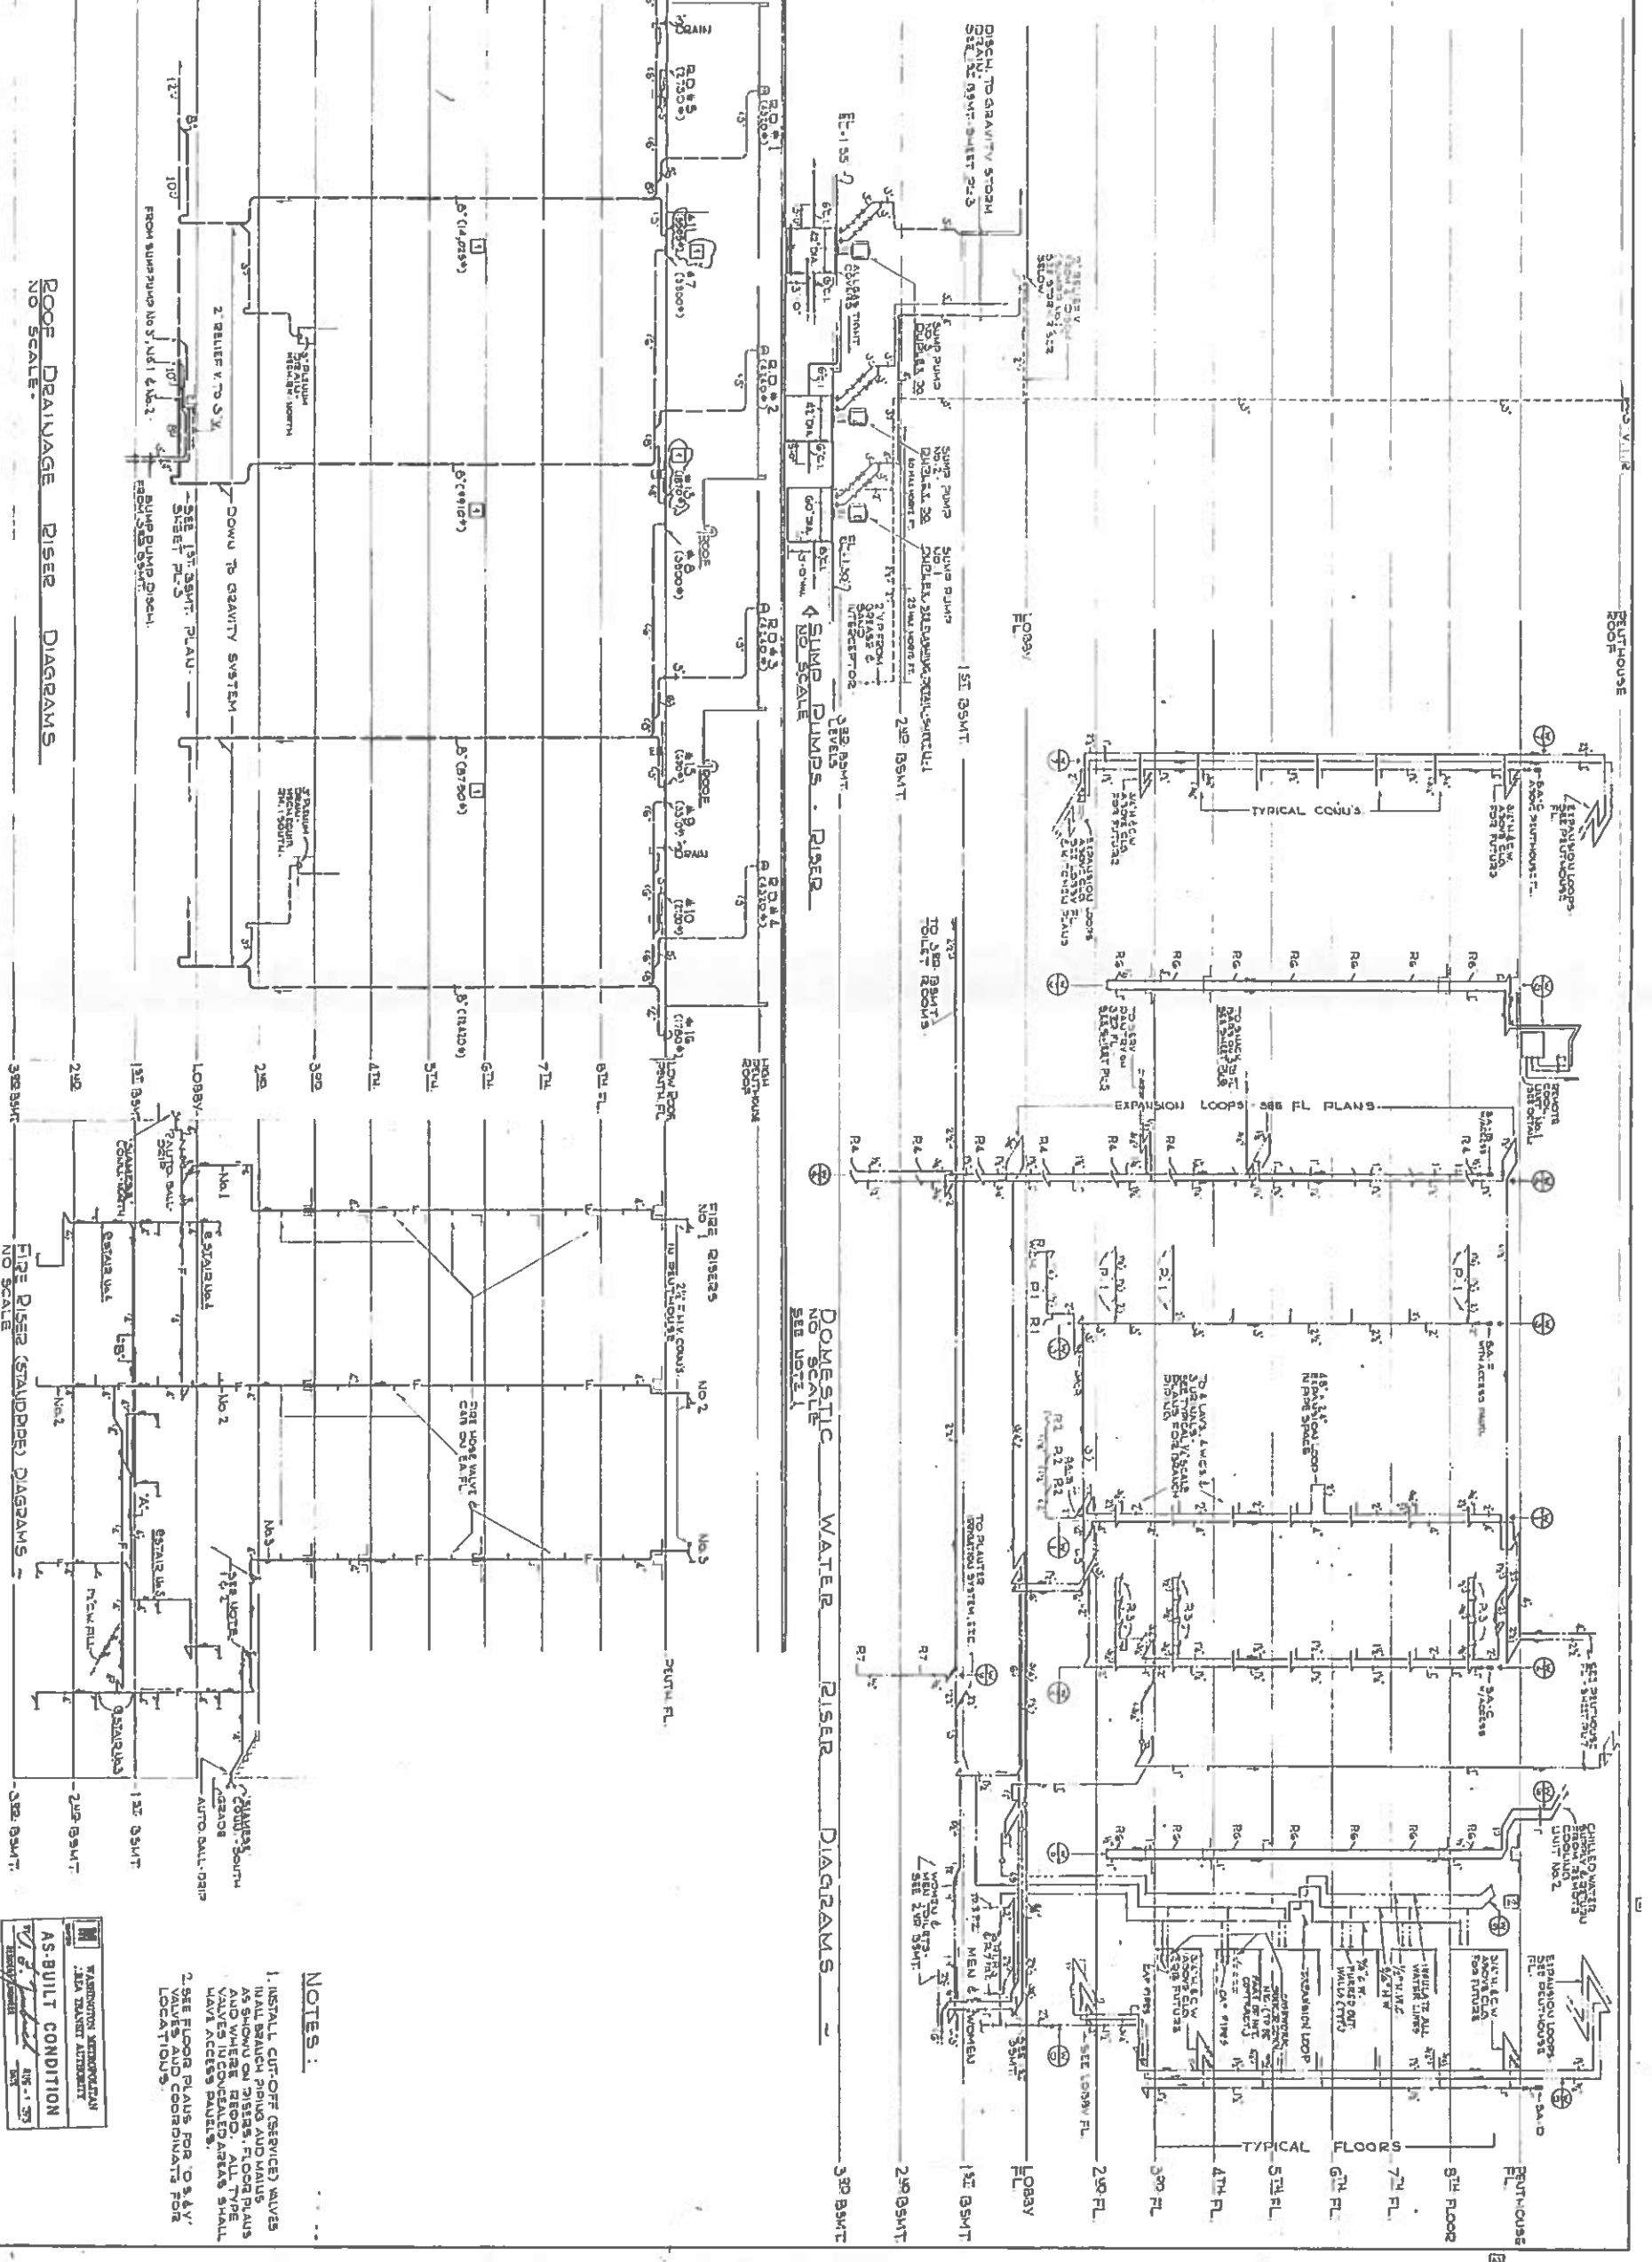

NOTES:

1. INSTALL CUT-OFF (SERVICED) VALVES IN ALL RAIN PIPES AND DOWNPIPES AND WHERE REISED. ALL TYPE VALVES IN CONCEALED AREAS SHALL HAVE ACCESS PANELS.
2. SEE FLOOR PLANS FOR 'O.A.Y.' VALVES AND COORDINATE FOR LOCATIONS.

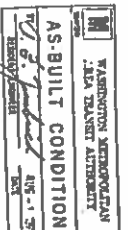

NO.	DATE	BY	DESCRIPTION
1	7/20/77	WALTON	ISSUE FOR PERMITS
2	8/1/77	WALTON	REVISED PER PERMITS
3	8/1/77	WALTON	REVISED PER PERMITS
4	8/1/77	WALTON	REVISED PER PERMITS
5	8/1/77	WALTON	REVISED PER PERMITS
6	8/1/77	WALTON	REVISED PER PERMITS
7	8/1/77	WALTON	REVISED PER PERMITS
8	8/1/77	WALTON	REVISED PER PERMITS
9	8/1/77	WALTON	REVISED PER PERMITS
10	8/1/77	WALTON	REVISED PER PERMITS



NO.	DATE	BY	DESCRIPTION
1	7/20/77	WALTON	ISSUE FOR PERMITS
2	8/1/77	WALTON	REVISED PER PERMITS
3	8/1/77	WALTON	REVISED PER PERMITS
4	8/1/77	WALTON	REVISED PER PERMITS
5	8/1/77	WALTON	REVISED PER PERMITS
6	8/1/77	WALTON	REVISED PER PERMITS
7	8/1/77	WALTON	REVISED PER PERMITS
8	8/1/77	WALTON	REVISED PER PERMITS
9	8/1/77	WALTON	REVISED PER PERMITS
10	8/1/77	WALTON	REVISED PER PERMITS

WASHINGTON METROPOLITAN AREA TRANSIT AUTHORITY
OPERATIONS CONTROL CENTER STAND BUILDING
RISER DIAGRAMS - WATER, STORM & STAND PIPE PLUMBING

NO.	DATE	BY	DESCRIPTION
1	7/20/77	WALTON	ISSUE FOR PERMITS
2	8/1/77	WALTON	REVISED PER PERMITS
3	8/1/77	WALTON	REVISED PER PERMITS
4	8/1/77	WALTON	REVISED PER PERMITS
5	8/1/77	WALTON	REVISED PER PERMITS
6	8/1/77	WALTON	REVISED PER PERMITS
7	8/1/77	WALTON	REVISED PER PERMITS
8	8/1/77	WALTON	REVISED PER PERMITS
9	8/1/77	WALTON	REVISED PER PERMITS
10	8/1/77	WALTON	REVISED PER PERMITS

DATE: 8/1/77
 DRAWING NO: OCCB-PL-10
 SHEET NO: M31-127