

Pre-Inspection Mezzanine Walkthrough Checklist

Date: 10/30/2014	Station Name: New Carrollton - D13	Mezzanine #: 068	Completed By: Meghan Powell	
Check	Task	Equipment	Room ID	Notes
<input checked="" type="checkbox"/>	Verify that electrical power design matches the field/record. Identify locations of the electrical equipment.	Electrical Source Panel Name/Number: DP-NE Source Breaker Name/Number: Breaker #3 Electrical AFC Panel Name/Number: LP-F	Rm 211 Rm 211 Rm C106	Rm C106 is inside of Rm C105 (Mezzanine level). Rm 211 is on wayside of track 2.
<input checked="" type="checkbox"/>	Verify if disconnect switch is connected to the AFC electrical power panel. Low or High voltage SMNT/POWR escorts requirements?	Disconnect Name/Number: N/A SMNT/POWR escorts: HIGH and LOW Voltage		
<input checked="" type="checkbox"/>	Check if there is a shared raceway between AFC Panel and Kiosk and identify additional source panels to be de-energized.	Do AFC Panel loads feed into a shared raceway e.g. trench or trough? If Yes, specify source panels in notes. YES (see notes)		LP-EM; LP-E turned off from main breaker on LP-E.
<input checked="" type="checkbox"/>	Identify the assumed pathway of duct / conduit, the location of the handholes, manholes and boxes and accessibility or special escort requirement?	PLNT <input checked="" type="checkbox"/> COMM / IT <input type="checkbox"/> ELES <input type="checkbox"/> RAIL <input type="checkbox"/> CMNT <input type="checkbox"/> Other Access/Support:		
<input checked="" type="checkbox"/>	Identify handhole or manhole access requirement.	Required PLNT Mason for handhole/manhole access? YES (see notes) Identified Conduit/Duct Transition to mezzanine level? YES		Run layout: Ducts from bottom of AFC panel into floor; 1 plate cover; 1 manhole to kiosk (3 part run).

Emergency Power Verification

Check	Task	Equipment	Room ID	Notes
<input type="checkbox"/>	Verify if AFC electrical panel is connected to an Automatic Transfer Switch (ATS).	ATS Name/Number:		
<input checked="" type="checkbox"/>	Verification of Kiosk Emergency Panel(s) (KE, KES, KESS, etc)	Source Panel Name/Number: LP-E Source Breaker Name/Number: Main breaker from LP-EM Panel Name/Number: No name on panel	Rm C106 Rm C106 Kiosk	Breaker #7 can also be used to shut off emergency power to Kiosk, but main breaker from LP-EM is still required for shared trough.

Notes and Discrepancies: Disconnect switch below LP-EM is not connected to Panel LP-F, LP-EM, or LP-E.

Sign Off	GFP Representative	WMATA PRGM
Name:		
Signature:		
Date:		

Picture 1: D13 New Carrollton – Handholes in Mezzanine



Picture 2: D13 New Carrollton – Steel plate on floor in Room C105



Picture 3: D13 New Carrollton – Emergency Panel in Kiosk



Picture 4: D13 New Carrollton – Source Panel DP-NE in Room 211



Picture 5: D13 New Carrollton – Source Panel DP-NE Breaker #3 in Room 211



Picture 6: D13 New Carrollton – Panel LP-E in Room C106



Picture 7: D13 New Carrollton – Panel LP-EM in Room C106



Picture 8: D13 New Carrollton – Common trough for Panels LP-F, LP-E and LP-EM in Room C106



Picture 9: D13 New Carrollton – Panel LP-F in Room C106



Picture 10: D13 New Carrollton – Panel LP-F in Room C106



Picture 11: D13 New Carrollton – Panel LP-F Schedule in Room C106

LOADCENTER CIRCUIT DIRECTORY

1	VENDOR 34	2	_____ <i>K10 SK</i>
3	VENDOR 31		_____ <i>A/C</i>
5	?		_____
7	?	4	VENDOR 38
9	TRANS TRANSFER 1	6	GATE 17
11	VENDOR 36	8	VENDOR 33
13	SPACE	10	GATE 14
15	?	12	GATE 15
17	VENDOR 35	14	SMART TRIP
19	VENDOR 32	16	GATE 20
21	SPACE	18	VENDOR 30
23	SPACE	20	EXIT FARE 51
25	SPACE	22	EXIT FARE 50
27	? SMART TRIP	24	GATE 18
29	TRANSFER BY ELEV	26	GATE 16
31	TRANSFER BY ESC	28	GATE 21+22
33	GATE 15 _____	30	VENDOR 39
35	SPACE	32	LITE OVER VENDOR
37	GATE VENDOR 37	34	LITE OVER ESC
39	?	36	?
41	?	38	_____ <i>Ad. No 22</i>

INSTALLED BY:

30-17438

Pre-Inspection Field
Verification 10/30/2014

Room layout appears to have modified from what is shown on this installation plan.

NOTE: SEE 1/4" SCALE PLAN OF SERVICE ROOMS - SHEET A


AFC
Panel in
Rm C106

Metal
plate
cover on
floor

SERVICE ROOMS

- 102 CORRIDOR
- 103 FIRE EQUIPMENT ROOM
- 104 BELL SYSTEM ROOM
- 105 WOMEN'S WASHROOM
- 106 MEN'S WASHROOM AND BUS DRIVERS WASHROOM
- 107 WATER SERVICE, CLEANERS AND MECHANICAL EQUIPMENT ROOM
- 108 ELECTRICAL ROOM

MEZZANINE FLOOR PLAN
1/8" = 1'-0"

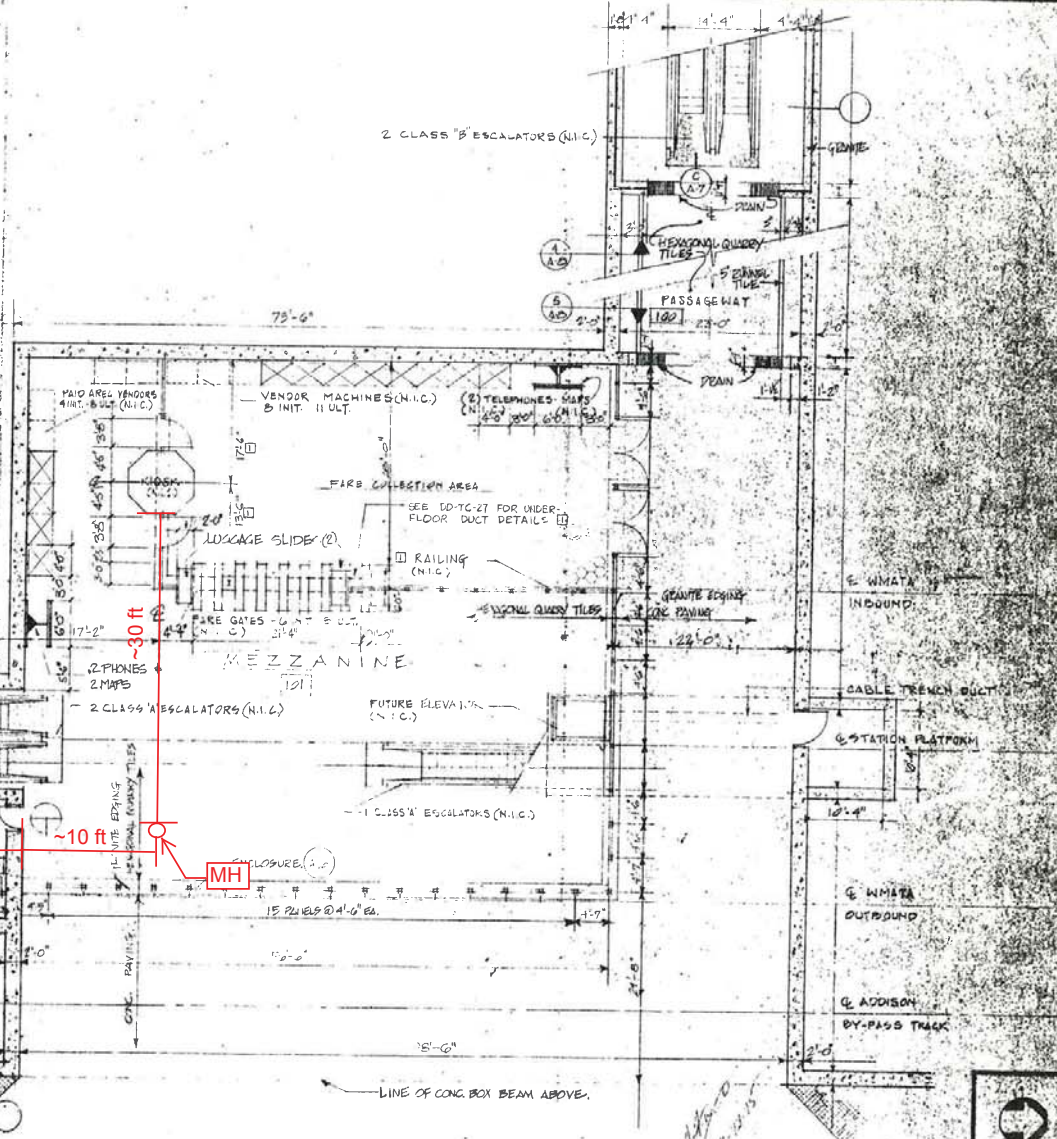

NO	DATE	NUMBER	REFERENCE DRAWINGS	DESCRIPTION	DATE	BY	REVISIONS	WASHINGTON METROPOLITAN AREA TRANSIT AUTHORITY		NEW CARROLLTON STATION - MEZZANINE	
RMS	6/1/74	10-7-27	LINE OF UNDERLOOR DUCT UNDER FARE COLLECTION CONSOLES	CORRECT 28'-0" DIMENSION FROM WALL TO CASE GATES, SEE DIMENSIONS TO MATCH FARE UNDERLOOR DUCT NOTES	1/11/74			APPROVED	George Thurman 6/12/74	DE LEWA, CALDER & COMPANY GENERAL ENGINEERING CONSULTANT	NEW CARROLLTON STATION - MEZZANINE FARE MACHINES, PHONES, MATS
W. L. L. S. C.	5/1/74						APPROVED		HARVEY WEISS & ASSOCIATES ARCHITECTURAL CONSULTANT	SCALE 1/8" = 1'-0"	DRAWING NO. SK-987

✓ (68)

Pre-Inspection Field
Verification 10/30/2014

Rm C106 inside
Rm C105

EXISTING PANEL "LP-F"										
AMPERES: 225			VOLTS: 120/208			MOUNTING: SURFACE				
WIRING: 225/AMCB			PHASE: 3			LOCATION: ELEC EQUIPMENT ROOM C105				
RATING: 10K AIC			WIRE: 4			SECTION: 1 OF 1				
LOAD DESCRIPTION	KVA	AMP	POLE	NO.	NO.	POLE	AMP	KVA	LOAD DESCRIPTION	
EXISTING VENDOR	0.8	20	1	1	A	2	30	2.9	EXIST. LOAD CENTER KES	
EXISTING VENDOR	0.8	20	1	3	B	4	-	2.5		
EXISTING VENDOR	0.8	20	1	5	C	5	-	2.5		
EXISTING VENDOR	0.8	20	1	7	A	8	1	0.8	EXISTING VENDOR	
SPARE	0.0	20	1	9	B	10	1	0.8	EXISTING VENDOR	
EXISTING VENDOR	0.8	20	1	11	C	12	1	0.8	EXISTING VENDOR	
SPARE	0.0	20	1	13	A	14	1	0.8	EXISTING VENDOR	
EXISTING VENDOR	0.8	20	1	15	B	16	1	0.8	EXISTING VENDOR	
EXISTING VENDOR	0.8	20	1	17	C	18	1	0.8	EXISTING VENDOR	
EXISTING VENDOR	0.8	20	1	19	A	20	1	0.8	EXISTING VENDOR	
NEW KIOSK RECEIPT. (T & NEPP)	0.8	20	1	21	B	22	1	0.8	EXISTING VENDOR	
SPARE (KIOSK)	0.0	20	1	23	C	24	1	0.8	EXISTING VENDOR	
SPARE	0.0	20	1	25	A	26	1	0.8	EXISTING VENDOR	
EXISTING VENDOR	0.8	20	1	27	B	28	1	0.8	EXISTING VENDOR	
EXISTING VENDOR	0.8	20	1	29	C	30	1	0.8	EXISTING VENDOR	
EXISTING VENDOR	0.8	20	1	31	A	32	1	0.8	EXISTING VENDOR	
EXISTING VENDOR	0.8	20	1	33	B	34	1	0.8	EXISTING VENDOR	
SPARE	0.0	20	1	35	C	36	1	0.8	EXISTING VENDOR	
EXISTING VENDOR	0.8	20	1	37	A	38	1	0.8	EXISTING VENDOR	
EXISTING VENDOR	0.8	20	1	39	B	40	1	0.8	EXISTING VENDOR	
EXISTING VENDOR	0.8	20	1	41	C	42	1	0.8	EXISTING VENDOR	

NOTES: 1. CONNECT NEW FEEDER TO EXISTING SPARE 20A, UP CB
2. CB TO BE RESERVED FOR FUTURE AFC

LOAD SUMMARY		
LIGHTS	0.0 x 125%	0.0 KVA
RECEPTACLES, FIRST 10 KVA	10.0 x 100%	10.0 KVA
RECEPTACLES	17.8 x 50%	8.8 KVA
MISC. APPLIANCES	0.0 x 100%	0.0 KVA
LARGEST MOTOR	0.0 x 125%	0.0 KVA
MOTORS	0.0 x 100%	0.0 KVA
HEAT	3.0 x 125%	3.8 KVA
AC	4.5 x 100%	4.5 KVA
WATER HEATING	0.0 x 125%	0.0 KVA
TOTAL CONNECTED LOAD	36.1 KVA	TOTAL DEMAND KVA 27.1 KVA
		TOTAL DEMAND AMPS 71.1 AMP

CONNECTED LOAD PHASE SUMMARY	
PHASE A	11.7 KVA
PHASE B	12.1 KVA
PHASE C	11.3 KVA

NOTES: A. EXISTING PANEL "LP-F" IS FED FROM 277/480V, 3Ø, 4W EXISTING PANEL "DP-NE" LOCATED IN AC SWBD BATTERY RM. 211, CIRCUIT #3-225/3P VIA 150KVA TRANSFORMER.
B. EXISTING WIRING FED FROM BOTTOM OF PANEL BY:
• 1-8" x 8" WIRE TROUGH (WIRING FILL >40%).
EXISTING WIRING FED FROM TOP OF PANEL BY:
• 2-1 1/2" C. (WIRING FILL >40%).
• 2-3/4" C. (WIRING FILL >40%).

CONTRACT NO.
14-FQ10060-CENI-24

DESIGNED <u>C. MO</u>	DATE <u>08-14</u>	REFERENCE DRAWINGS		REVISIONS	
		NUMBER	DESCRIPTION	DATE	BY
DRAWN <u>C. MO</u>	DATE <u>08-14</u>				
CHECKED <u>B. OLS</u>	DATE <u>08-14</u>				
APPROVED <u>NA</u>	DATE				


WASHINGTON METROPOLITAN AREA TRANSIT AUTHORITY
DEPARTMENT OF TRANSIT INFRASTRUCTURE AND ENGINEERING SERVICES
OFFICE OF INFRASTRUCTURE RENEWAL PROGRAM

GFP A Connell Ferries/Parsons JOINT VENTURE

APPROVED _____ SUBMITTED _____ PROJECT MANAGER _____

NEW ELECTRONIC PAY PROGRAM (NEPP) IN METRO RAIL STATIONS
NEW CARROLLTON
PANEL SCHEDULE

SCALE: NOT TO SCALE
DRAWING NO: D13-E-102

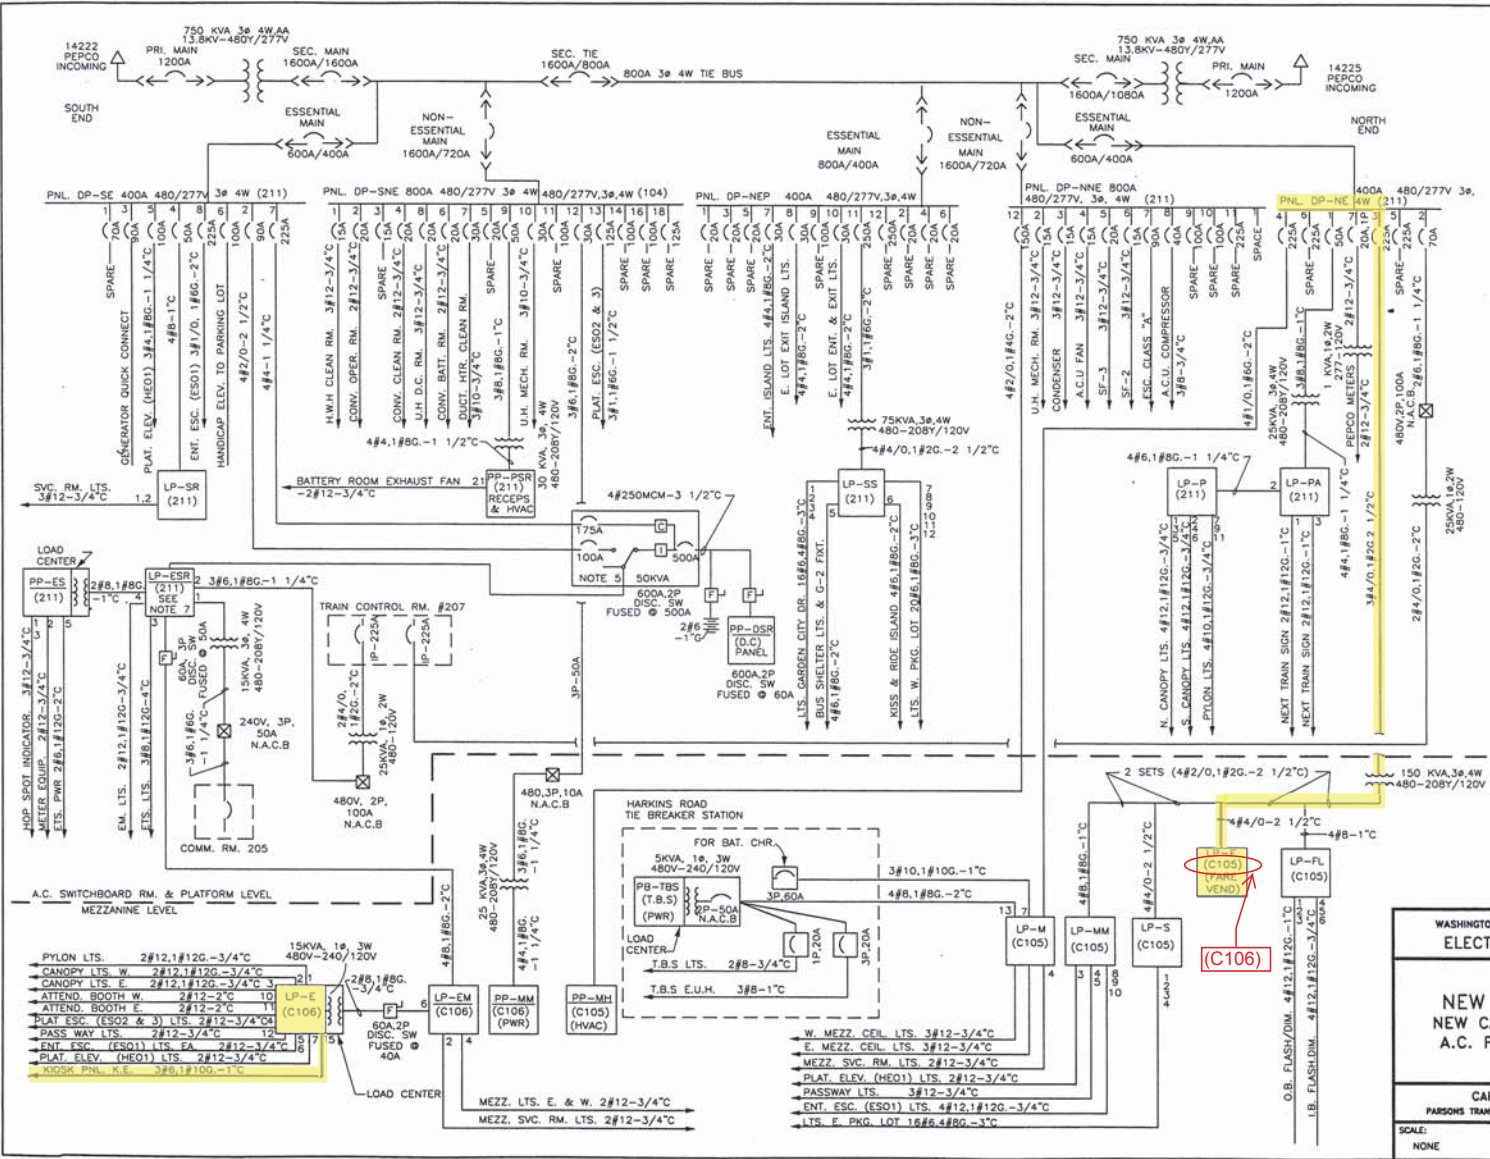

- NOTES:
1. PANEL DESIGNATION
HEA (205)
(LIGHTING)
ROOM NUMBER
TYPE OF DISTRIBUTION
B (CIRCUIT NUMBER)
* WHEN NO CKTS SHOWN
 2. 3#2, 2" C
CONDUIT SIZE
AWG OR KCMIL CIRCUIT WIRES
* AS TAKEN FROM AS-BUILT DWGS.
 3. CIRCUIT BREAKERS
DRAW OUT
MOLDED CASE
FRAME SIZE
CONTINUOUS CURRENT SETTING
 4. 4/C # 4/0
INDICATES MULTICONDUCTOR CABLE WITH 4 CONDUCTORS AND SIZE OF EACH 4/0
 5. RATING AS SHOWN FOR UNINTERRUPTIBLE POWER SUPPLY CONSISTING OF RECTIFIER/CHARGER, INVERTER, POWER TRANSFER SWITCH, ASSOCIATED BATTERIES AND D.C. PANELBOARD.
 6. SWITCHGEAR MANUFACTURER
WESTINGHOUSE
 7. EMERGENCY PANEL LABELLED LP-ESR ON THE AS-BUILT DWGS, IS LABELLED LP-EM IN THE FIELD.
 8. UPS MANUFACTURER
IPM

Pre-Inspection Field Verification 10/30/2014

REVISIONS		
DATE	BY	DESCRIPTION

WASHINGTON METROPOLITAN AREA TRANSIT AUTHORITY
ELECTRICAL MAINTENANCE MAP


NEW CARROLLTON ROUTE
NEW CARROLLTON STATION (D13)
A.C. POWER ONE LINE DIAGRAM

CAPITAL IMPROVEMENT PROGRAM
PARSONS TRANSPORTATION GROUP - CAPITAL TRANSIT CONSULTANTS

SCALE: NONE	DRAWING NO. MM-D-E27
----------------	-------------------------

(C105)
(C106)
(C106)

Pre-Inspection Mezzanine Walkthrough Checklist

Date: 11/06/2014		Station Name: Benning Road - G01		Mezzanine #: 090		Completed By: Tino Sahoo	
Check	Task	Equipment	Room ID	Notes			
<input checked="" type="checkbox"/>	Verify that electrical power design matches the field/record. Identify locations of the electrical equipment.	Electrical Source Panel Name/Number: West AC Substation SWBD/WA Source Breaker Name/Number: "Panel F 200A" (Breaker #9) Electrical AFC Panel Name/Number: Panel F	Rm 203 Rm 203 Rm 102	AC SWBD Room 203 is Track 2 wayside. SWBD is listed on as-built as WA, but in field as West AC Substation SWBD.			
<input checked="" type="checkbox"/>	Verify if disconnect switch is connected to the AFC electrical power panel. Low or High voltage SMNT/POWR escorts requirements?	Disconnect Name/Number: SMNT/POWR escorts: HIGH and LOW Voltage					
<input checked="" type="checkbox"/>	Check if there is a shared raceway between AFC Panel and Kiosk and identify additional source panels to be de-energized.	Do AFC Panel loads feed into a shared raceway e.g. trench or trough? If Yes, specify source panels in notes. NO					
<input checked="" type="checkbox"/>	Identify the assumed pathway of duct / conduit, the location of the handholes, manholes and boxes and accessibility or special escort requirement?	PLNT <input checked="" type="checkbox"/> COMM / IT <input type="checkbox"/> ELES <input type="checkbox"/> RAIL <input type="checkbox"/> CMNT <input type="checkbox"/> Other Access/Support:					
<input checked="" type="checkbox"/>	Identify handhole or manhole access requirement.	Required PLNT Mason for handhole/manhole access? YES (see notes) Identified Conduit/Duct Transition to mezzanine level? YES		Conduit/ducts on two levels. Run is overhead conduit. Power run from Kiosk to AFC Panel is approx. 80'.			
Emergency Power Verification							
Check	Task	Equipment	Room ID	Notes			
<input checked="" type="checkbox"/>	Verify if AFC electrical panel is connected to an Automatic Transfer Switch (ATS).	ATS Name/Number:					
<input checked="" type="checkbox"/>	Verification of Kiosk Emergency Panel(s) (KE, KES, KESS, etc)	Source Panel Name/Number: EER Source Breaker Name/Number: Breaker #8 Panel Name/Number: Kiosk Emergency Panel	Rm 112 Rm 112 Kiosk				
Notes and Discrepancies:							
Sign Off		GFP Representative			WMATA PRGM		
Name:		Tino Sahoo					
Signature:							
Date:		11/06/2014					

Picture 1: G01 Benning Road – Manhole & handhole in Mezzanine





Picture 2: G01 Benning Road – Manhole in Mezzanine



Picture 3: G01 Benning Road – Emergency panels in Kiosk




Pictures 4 & 5: G01 Benning Road – Emergency panel in Kiosk

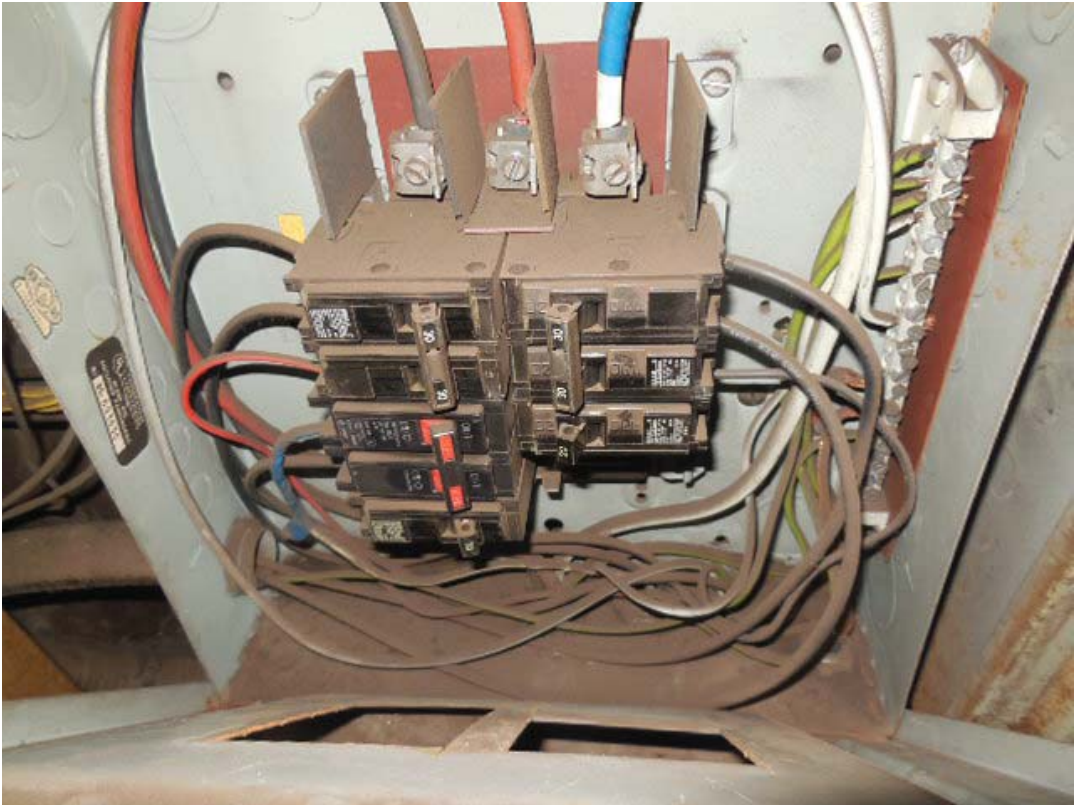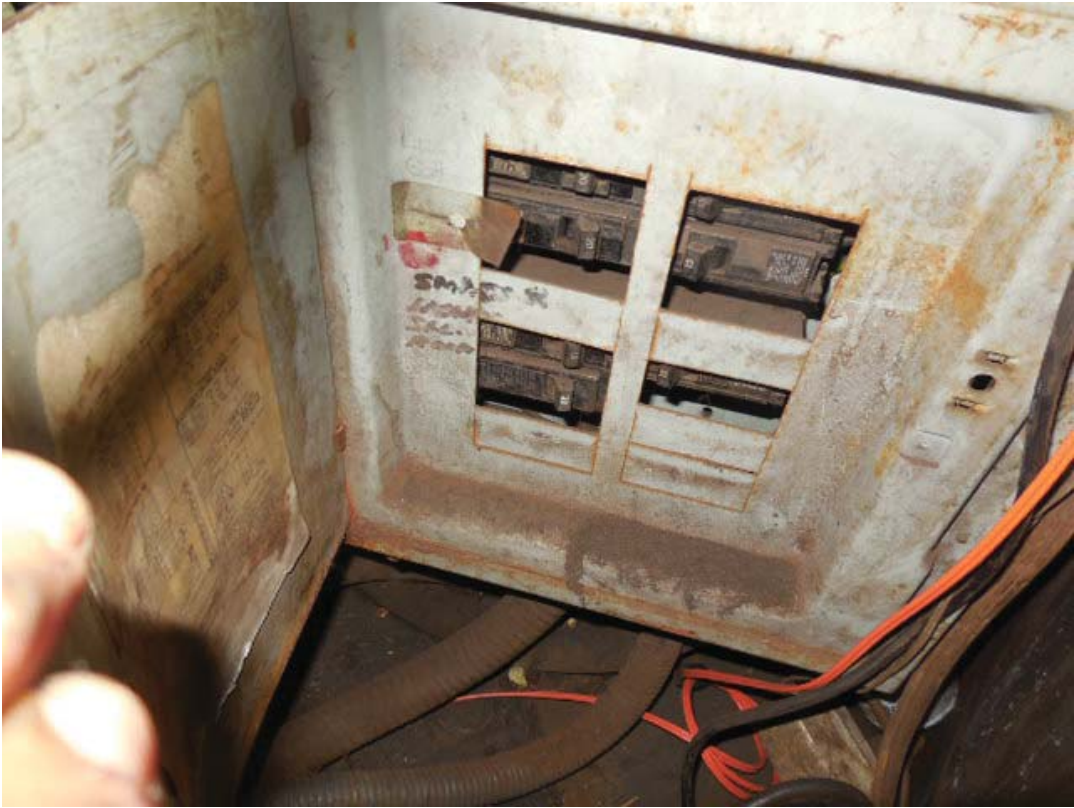


Picture 6: G01 Benning Road – AFC Panel F in Room 102



Picture 7: G01 Benning Road – AFC Panel F in Room 102

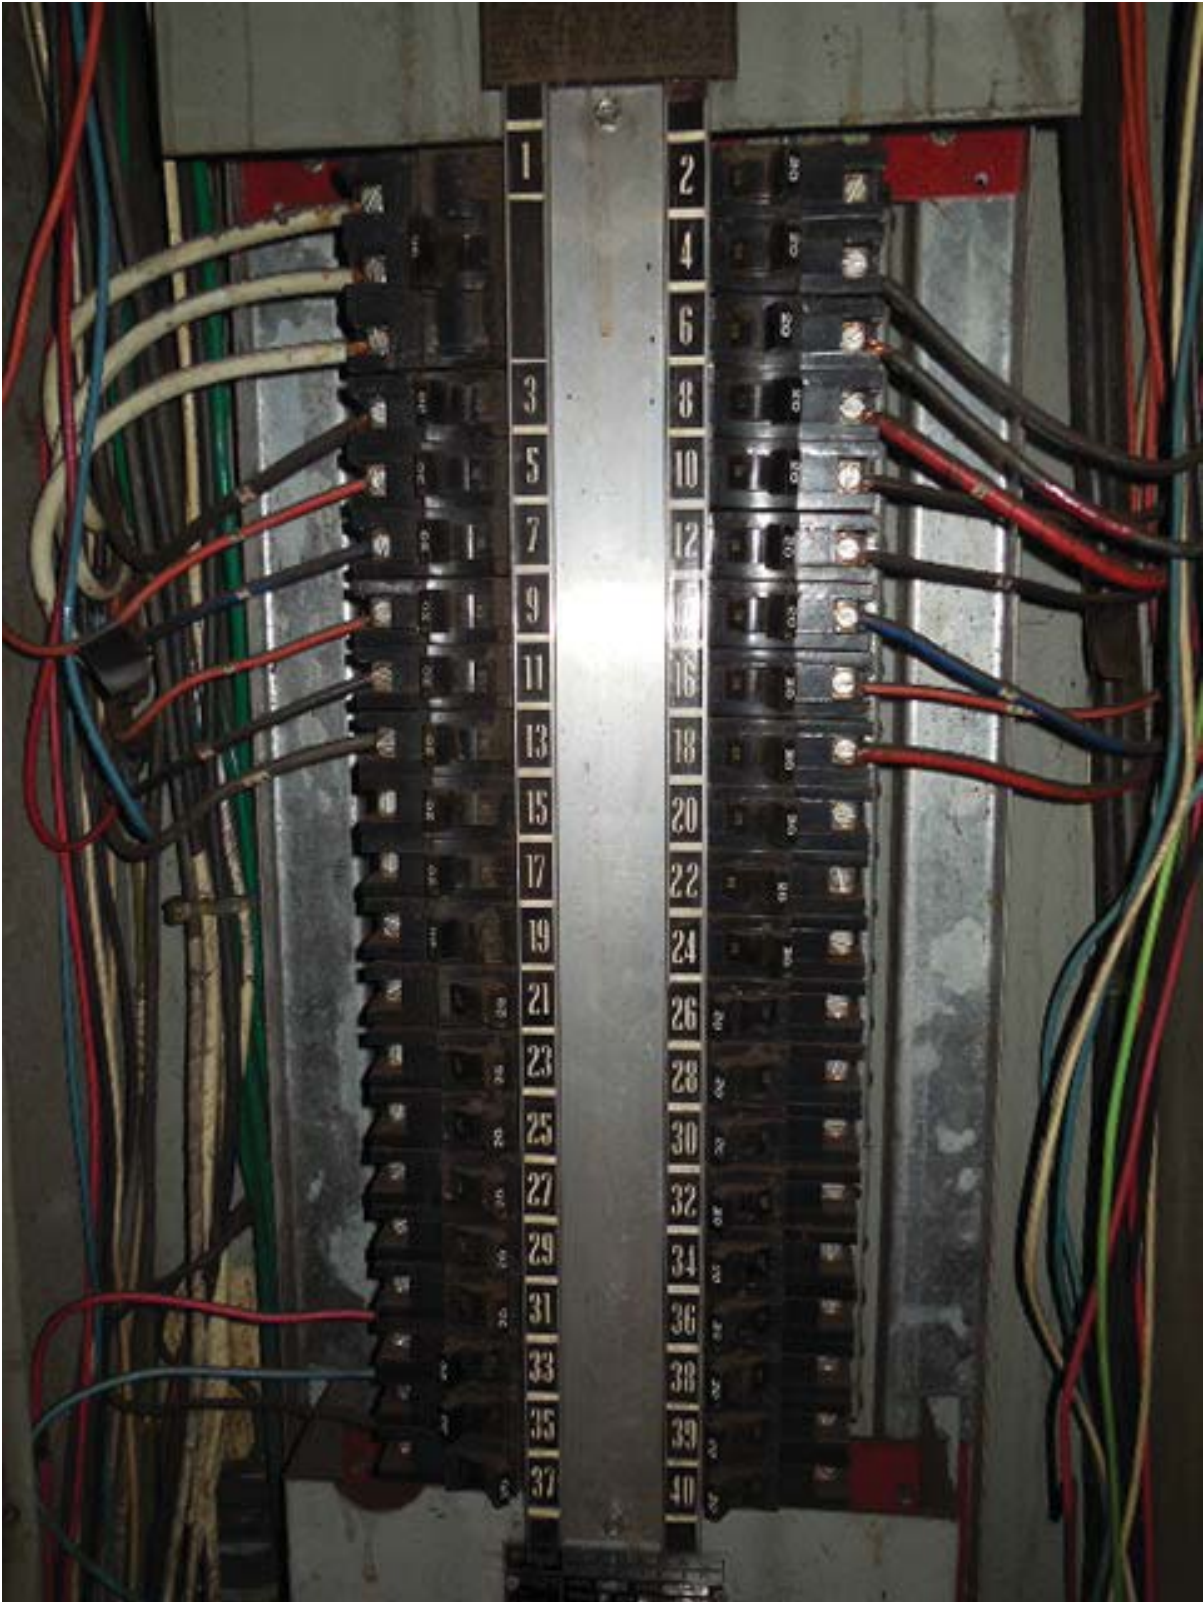

Picture 8: G01 Benning Road – AFC Panel F in Room 102 – Panel schedule

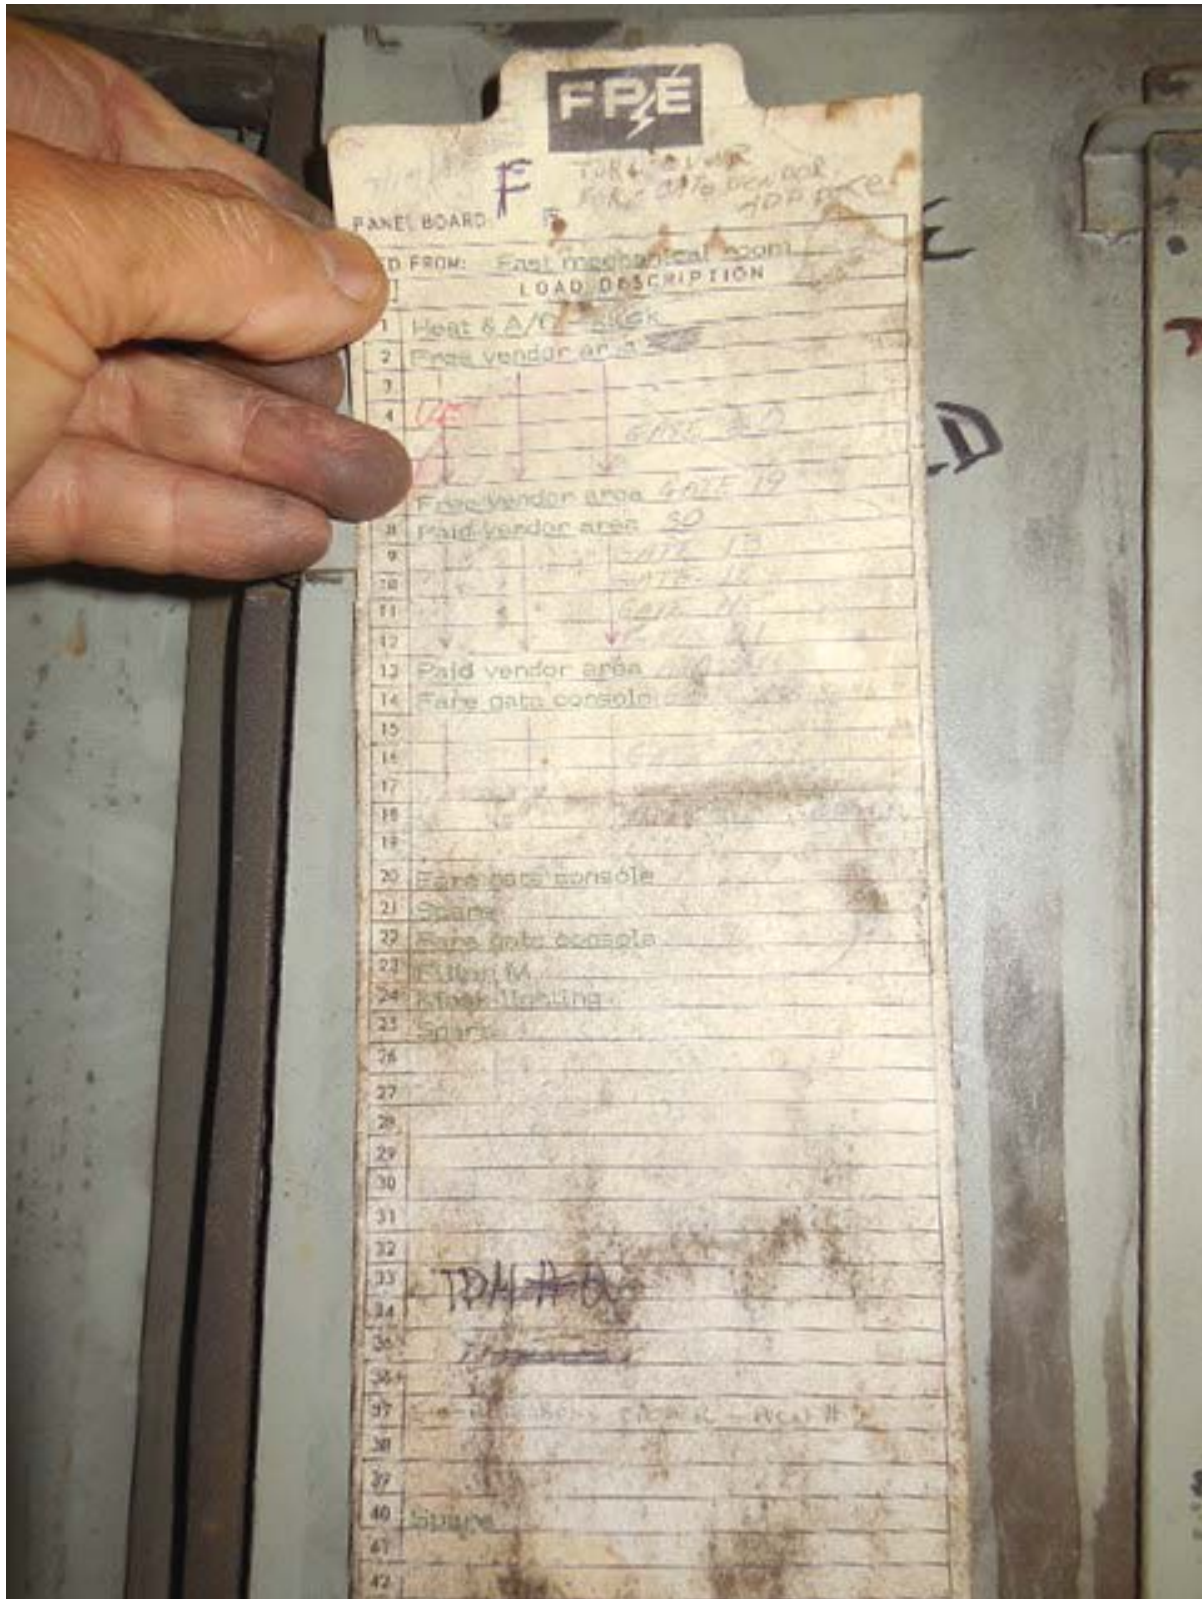

Picture 9: G01 Benning Road – AFC Panel F in Room 102 – Conduits above panel



Picture 10: G01 Benning Road – AFC Panel F in Room 102 – Conduits above panel



Picture 11: G01 Benning Road – West AC Substation Switchboard in Room 203



Picture 12: G01 Benning Road – West AC Substation Switchboard in Room 203 – Circuit 9 for AFC Panel F



Pre-Inspection Field
Verification 11/06/2014

EXISTING PANEL "F" ✓										
AMPERES: 400			VOLTS: 120/208			MOUNTING: SURFACE				
MAINS: 300A MCB			PHASE: 3			LOCATION: MECHANICAL EQUIPMENT ROOM 102 ✓				
RATING: 10KAIC			WIRE: 4			SECTION: 1 OF 1				
LOAD DESCRIPTION	KVA	AMP	POLE	NO.	CTK BKRS	CTK NO.	POLE	AMP	KVA	LOAD DESCRIPTION
EXIST. KIOSK LOAD CENTER "KES"	3.3	30	3	1	A - -	2	1	20	0.0	SPARE
	2.5	-	-	3	- B -	4	1	20	0.8	EXISTING VENDOR
	2.5	-	-	5	- - C	6	1	20	0.8	EXISTING VENDOR
EXISTING VENDOR	0.8	20	1	7	A - -	8	1	20	0.8	EXISTING VENDOR
EXISTING VENDOR	0.8	20	1	9	- B -	10	1	20	0.8	EXISTING VENDOR
EXISTING VENDOR	0.8	20	1	11	- - C	12	1	20	0.8	EXISTING VENDOR
EXISTING VENDOR	0.8	20	1	13	A - -	14	1	20	0.8	EXISTING VENDOR
EXISTING VENDOR	0.8	20	1	15	- B -	16	1	20	0.8	EXISTING VENDOR
EXISTING VENDOR	0.8	20	1	17	- - C	18	1	20	0.8	EXISTING VENDOR
NEW KIOSK RECEPT. (IT & NEPP)	0.8	20	1	19	A - -	20	1	20	0.8	EXISTING VENDOR
SPARE (KIOSK)	0.0	20	1	21	- B -	22	1	20	0.0	SPARE
SPARE	0.0	20	1	23	- - C	24	1	20	0.0	SPARE
SPARE	0.0	20	1	25	A - -	26	1	20	0.0	SPARE
SPARE	0.0	20	1	27	- B -	28	1	20	0.0	SPARE
SPARE	0.0	20	1	29	- - C	30	1	20	0.0	SPARE
SPARE	0.0	20	1	31	A - -	32	1	20	0.0	SPARE
SPARE	0.0	20	1	33	- B -	34	1	20	0.0	SPARE
SPARE	0.0	20	1	35	- - C	36	1	20	0.0	SPARE
EXISTING VENDOR	0.8	20	1	37	A - -	38	1	20	0.0	SPARE
EXISTING VENDOR	0.8	20	1	39	- B -	40	1	20	0.0	SPARE
EXISTING VENDOR	0.8	20	1	41	- - C	42	1	20	0.0	SPARE

NOTES: 1. CONNECT NEW FEEDER TO EXISTING SPARE 20A, 1P CB
2. CB TO BE RESERVED FOR FUTURE AFC

✓ 1
✓ 1&2

LOAD SUMMARY

LIGHTS	0.0 x 125%	0.0 KVA
RECEPTACLES FIRST 10 KVA	10.0 x 100%	10.0 KVA
RECEPTACLES	6.0 x 50%	3.0 KVA
MISC APPLIANCES	0.0 x 100%	0.0 KVA
LARGEST MOTOR	0.0 x 125%	0.0 KVA
MOTORS	0.0 x 100%	0.0 KVA
HEAT	3.0 x 125%	3.8 KVA
AC	4.5 x 100%	4.5 KVA
WATER HEATING	0.0 x 125%	0.0 KVA
TOTAL CONNECTED LOAD	23.5 KVA	TOTAL DEMAND KVA 21.3 KVA
		TOTAL DEMAND AMPS 59.0 AMPS
CONNECTED LOAD PHASE SUMMARY		
PHASE A	8.9 KVA	
PHASE B	7.3 KVA	
PHASE C	6.5 KVA	

- NOTES: A. EXISTING PANEL "F" IS FED FROM 277/480V, 3ø, 4W EXISTING WEST AC SWBD "WA" LOCATED IN AC SWBD BATTERY RM. 203, CIRCUIT #9-200/3P VIA 75KVA TRANSFORMER (SEE ATTACHED MN-G-ED6).
- B. EXISTING WIRING FED FROM TOP OF PANEL BY:
 * 14-3/4" C. (3-EMPTY CONDUIT & 11-WIRING FILL >40%).
 EXISTING WIRING FED FROM RIGHT SIDE OF PANEL BY:
 * 1-4" C. TO TRANSFORMER (WIRING FILL >40%).

CONTRACT NO.
14-FQ10060-CENI-24

DESIGNED C. 160	DATE 08-14	REFERENCE DRAWINGS		REVISIONS	
		NUMBER	DESCRIPTION	DATE	BY
DRAWN C. 160	DATE 08-14				
CHECKED B. 1000	DATE 08-14				
APPROVED J.A.	DATE				


WASHINGTON METROPOLITAN AREA TRANSIT AUTHORITY
 DEPARTMENT OF TRANSIT INFRASTRUCTURE AND ENGINEERING SERVICES
 OFFICE OF INFRASTRUCTURE RENEWAL PROGRAM

APPROVED _____

GFP A Goodell Fleming/Parsons JOINT VENTURE
 SUBMITTED _____
 PROJECT MANAGER


NEW ELECTRONIC PAY PROGRAM (NEPP)
 IN METRORAIL STATIONS
 BENNING ROAD
 PANEL SCHEDULE

SCALE: NOT TO SCALE
 DRAWING NO. G01-E-102

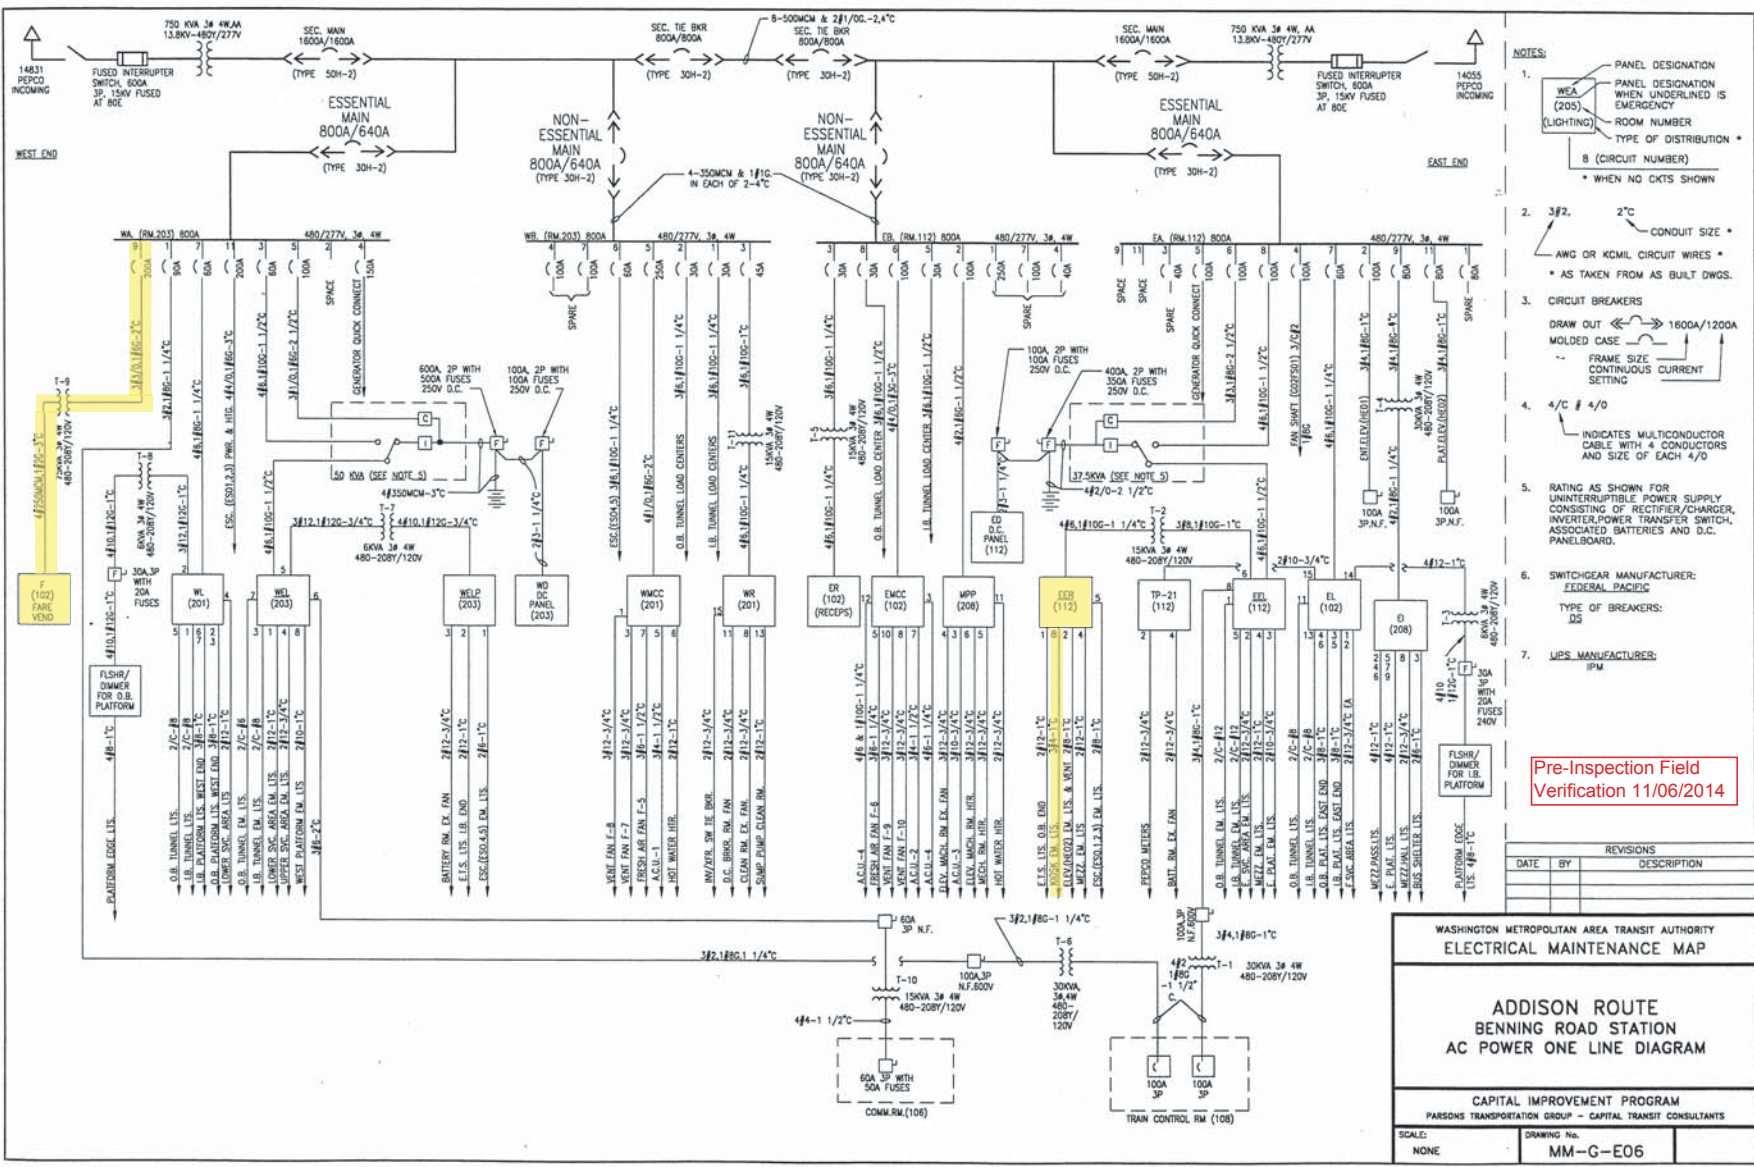

Pre-Inspection Field Verification 11/06/2014

Pre-Inspection Mezzanine Walkthrough Checklist

Date: 11/06/2014	Station Name: Capitol Heights - G02	Mezzanine #: 091	Completed By: Tino Sahoo	
Check	Task	Equipment	Room ID	Notes
<input checked="" type="checkbox"/>	Verify that electrical power design matches the field/record. Identify locations of the electrical equipment.	Electrical Source Panel Name/Number: MPOE Source Breaker Name/Number: Breaker #10 Electrical AFC Panel Name/Number: MF	Rm 206 Rm 206 Rm 206	S.O. Request: Breaker #10 on Panel MPOE Breaker #6 on Panel MPONE Breaker #6 on Panel M Breaker #14 on Panel WE
<input checked="" type="checkbox"/>	Verify if disconnect switch is connected to the AFC electrical power panel. Low or High voltage SMNT/POWR escorts requirements?	Disconnect Name/Number: SMNT/POWR escorts: HIGH and LOW Voltage		
<input checked="" type="checkbox"/>	Check if there is a shared raceway between AFC Panel and Kiosk and identify additional source panels to be de-energized.	Do AFC Panel loads feed into a shared raceway e.g. trench or trough? If Yes, specify source panels in notes. YES (see notes)		Panels MF, MM, MA, MEA Emergency power share common under floor trench.
<input checked="" type="checkbox"/>	Identify the assumed pathway of duct / conduit, the location of the handholes, manholes and boxes and accessibility or special escort requirement?	PLNT <input checked="" type="checkbox"/> COMM / IT <input type="checkbox"/> ELES <input type="checkbox"/> RAIL <input type="checkbox"/> CMNT <input type="checkbox"/> Other Access/Support:		
<input checked="" type="checkbox"/>	Identify handhole or manhole access requirement.	Required PLNT Mason for handhole/manhole access? YES (see notes) Identified Conduit/Duct Transition to mezzanine level? YES		All conduit/ducts on one level. Power run from Kiosk to AFC Panel is approx. 90'. Two pairs of handholes on mezzanine.
Emergency Power Verification				
Check	Task	Equipment	Room ID	Notes
<input checked="" type="checkbox"/>	Verify if AFC electrical panel is connected to an Automatic Transfer Switch (ATS).	ATS Name/Number:		
<input checked="" type="checkbox"/>	Verification of Kiosk Emergency Panel(s) (KE, KES, KESS, etc)	Source Panel Name/Number: MM; MEA Emergency Power Source Breaker Name/Number: Breaker #6; Breaker #9,11 Panel Name/Number: KE (Kiosk Emergency Panel)	Rm 206 Rm 206 Kiosk	Breaker #6 on Panel MM de-energizes Kiosk Panel; Breaker #9,11 on Panel MEA Emergency Power de-energizes Kiosk Panel KE (Emergency Power).
Notes and Discrepancies: Panel KE (Kiosk Emergency Panel) located in Kiosk, Breaker #8 de-energizes emergency power to faregates.				
Sign Off	GFP Representative	WMATA PRGM		
Name:	Tino Sahoo			
Signature:				
Date:	11/06/2014			

Pictures 1&2: G02 Capitol Heights – Handholes in mezzanine



Picture 3: G02 Capitol Heights – Emergency panels in Kiosk



Pictures 4&5: G02 Capitol Heights – Emergency panel in Kiosk



Picture 6: G02 Capitol Heights – AFC Panel MF in room 206



Picture 7: G02 Capitol Heights – AFC Panel MF in room 206



Picture 8: G02 Capitol Heights – AFC Panel MF in room 206 – Bottom conduits



Picture 9: G02 Capitol Heights – Emergency power Panel MEA in room 206



Picture 10: G02 Capitol Heights – Emergency power Panel MEA in room 206



Picture 11: G02 Capitol Heights – Emergency power Panel MEA in room 206 – Panel schedule

MEA

PANEL	
1	Passageway Emergency Ltg.
2	PASSAGEWAY EMERGENCY LTG.
3	SURFACE ELEVATOR CAR LTG.
4	SURFACE ESCALATOR LTG.
5	Platform Escalator Ltg.
6	SURFACE ESCALATOR LTG.
7	PLATFORM ESCALATOR LTG.
8	SURFACE ESCALATOR LTG.
9	KIOSK PANEL K.E.
10	SURFACE ESCALATOR CONTROLS
11	KIOSK PANEL K.E.
12	
13	
14	DIMMER PANEL
15	
16	
17	Surface Elevator Car L.T.C.
18	
19	
20	


Picture 12: G02 Capitol Heights – Panel MM in room 206



Picture 13: G02 Capitol Heights – Panel MM in room 206 – Panel schedule




Picture 14: G02 Capitol Heights – Panel MPOE in room 206

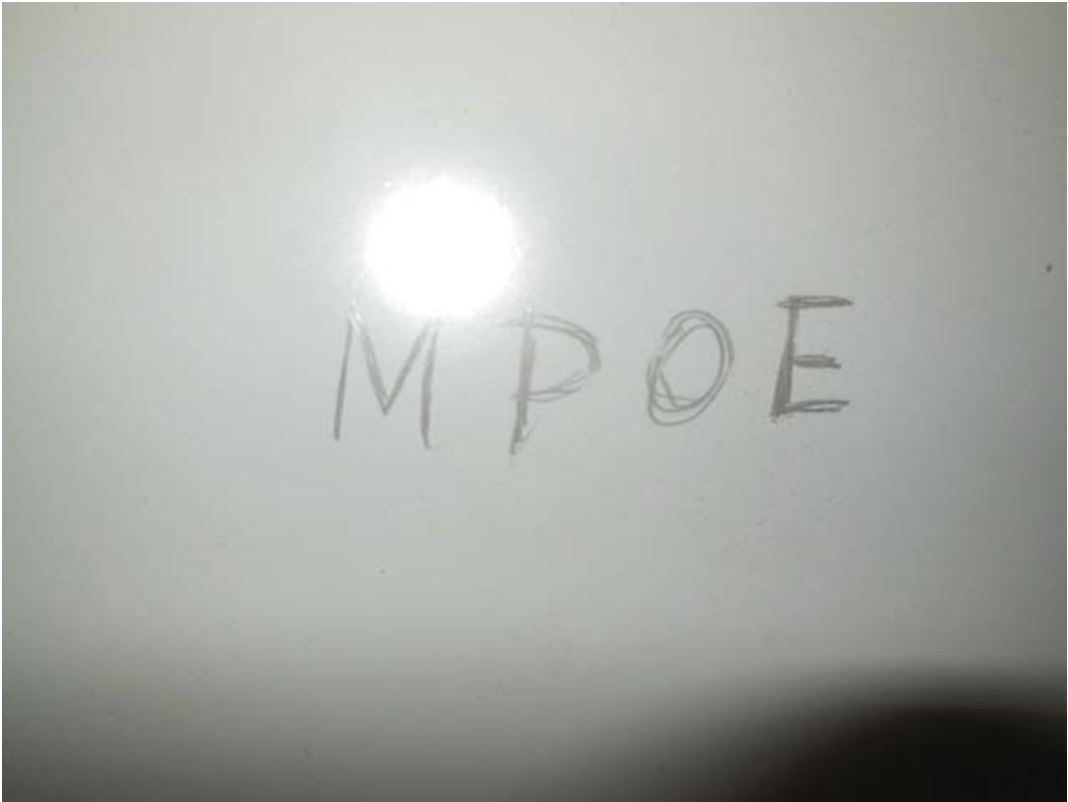

Picture 15: G02 Capitol Heights – Panel MPOE in room 206 – Circuit #4



Picture 16: G02 Capitol Heights – Panel MPOE in room 206 – Panel schedule

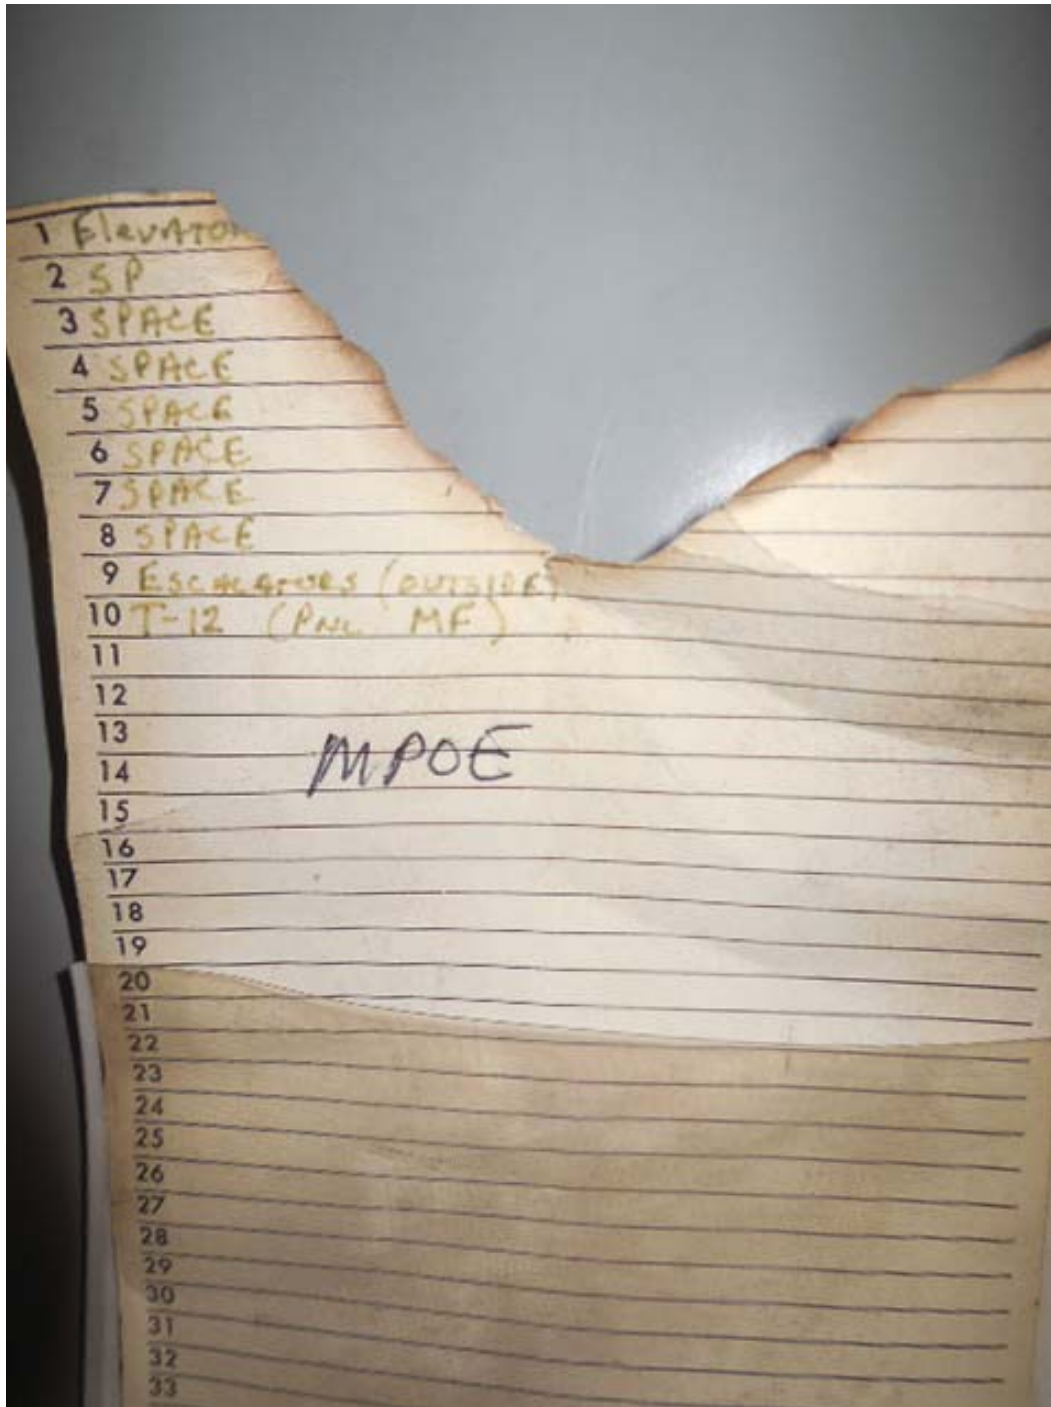

Picture 17: G02 Capitol Heights – Common trench in room 206




Picture 18: G02 Capitol Heights – Common trench in room 206



Picture 19: G02 Capitol Heights – Common trench in room 206



Pre-Inspection Field
Verification 11/06/2014

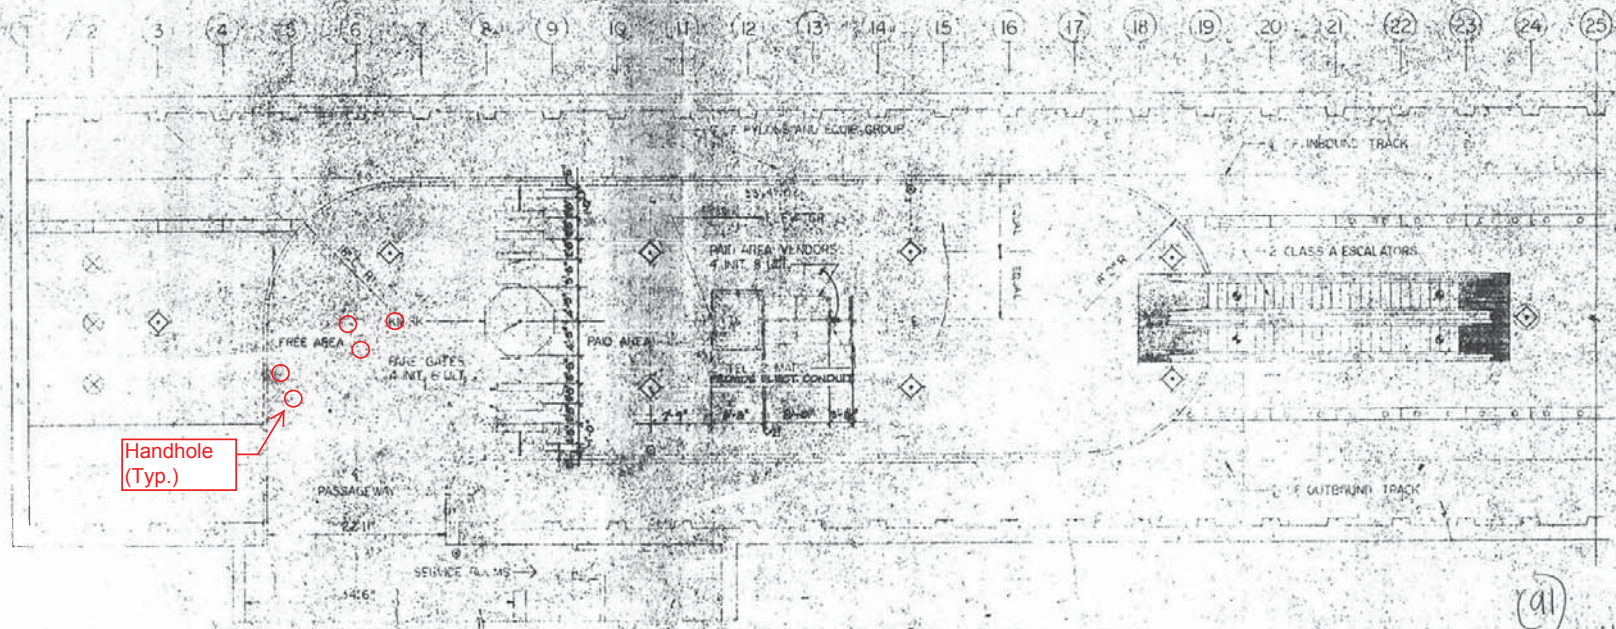

(a1)
[Handwritten signature]

DESIGNED	DATE 12-1-74	REFERENCE DRAWINGS		REVISIONS		WASHINGTON METROPOLITAN AREA TRANSIT AUTHORITY		CAPITOL HEIGHTS STATION G-2	
DRAWN	DATE 12-2-74	NUMBER	DESCRIPTION	DATE	BY	DESCRIPTION	DE LEUW, CATHEN & COMPANY GENERAL ENGINEERING CONSULTANT	FARE MACHINES, FARE GATES, PHONES and MAP CASES	
CHECKED	DATE						HARRY WEESE & ASSOCIATES GENERAL ARCHITECTURAL CONSULTANT	SCALE: 1/8" = 1'-0"	
APPROVED	DATE						APPROVED	DRAWING NO. 11-11-74	

Pre-Inspection Field
Verification 11/06/2014

EXISTING PANEL "MF" ✓										
AMPERES: 250		VOLTS: 120/208		MOUNTING: SURFACE						
MAINS: 250A MCB		PHASE: 3		LOCATION: MECHANICAL EQUIP. ROOM C206 ✓						
RATING: 10K AIC		WIRE: 4		SECTION: 1 OF 1						
LOAD DESCRIPTION	KVA	AMP	POLE	NO.	NO.	POLE	AMP	KVA	LOAD DESCRIPTION	
EXIST. LOAD CENTER "KES"	2.9	20	1	1	A -	2	1	20	0.8	EXISTING VENDOR
	2.5	20	1	3	- B -	4	1	20	0.8	EXISTING VENDOR
	2.5	20	1	5	- - C	6	1	20	0.0	SPARE
EXISTING VENDOR	0.8	20	1	7	A -	8	1	20	0.8	EXISTING VENDOR
EXISTING VENDOR	0.8	20	1	9	- B -	10	1	20	0.8	EXISTING VENDOR
EXISTING VENDOR	0.8	20	1	11	- - C	12	1	20	0.8	EXISTING VENDOR
EXISTING VENDOR	0.8	20	1	13	A -	14	1	20	0.8	EXISTING VENDOR
EXISTING VENDOR	0.8	20	1	15	- B -	16	1	20	0.8	EXISTING VENDOR
EXISTING VENDOR	0.8	20	1	17	- - C	18	1	20	0.8	EXISTING VENDOR
EXISTING VENDOR	0.8	20	1	19	A -	20	1	20	0.8	NEW KIOSK RECEPT. (IT & NEPP)
EXISTING VENDOR	0.8	20	1	21	- B -	22	1	20	0.0	SPARE (KIOSK)
EXISTING VENDOR	0.8	20	1	23	- - C	24	1	20	0.0	SPARE
SPARE	0.0	20	1	25	A -	26	1	20	0.0	SPARE
SPARE	0.0	20	1	27	- B -	28	1	20	0.8	EXISTING VENDOR
SPARE	0.0	20	1	29	- - C	30	1	20	0.0	SPARE
SPARE	0.0	20	1	31	A -	32	1	20	0.0	SPARE
SPARE	0.0	20	1	33	- B -	34	1	20	0.0	SPARE
SPARE	0.0	20	1	35	- - C	36	1	20	0.0	SPARE

NOTES: 1. CONNECT NEW FEEDER TO EXISTING SPARE 20A, 1P CB
2. CB TO BE RESERVED FOR FUTURE AFC

LOAD SUMMARY

LIGHTS	0.0 x 125%	0.0 KVA
RECEPTACLES, FIRST 10 KVA	10.0 x 100%	10.0 KVA
RECEPTACLES	5.6 x 50%	2.8 KVA
MISC. APPLIANCES	0.0 x 100%	0.0 KVA
LARGEST MOTOR	0.0 x 125%	0.0 KVA
MOTORS	0.0 x 100%	0.0 KVA
HEAT	3.0 x 125%	3.8 KVA
AC	4.5 x 100%	4.5 KVA
WATER HEATING	0.0 x 125%	0.0 KVA
TOTAL CONNECTED LOAD	23.1 KVA	TOTAL DEMAND KVA 21.1 KVA
		TOTAL DEMAND AMPS 58.5 AMPS
CONNECTED LOAD PHASE SUMMARY		
PHASE A:	8.5 KVA	
PHASE B:	8.1 KVA	
PHASE C:	6.5 KVA	

NOTES: A. EXISTING PANEL "MF" IS FED FROM 277/480V, 3Ø, 4W EXISTING PANEL "MPOE" LOCATED IN MECHANICAL EQUIPMENT RM. 206, CIRCUIT #10-200/3P VIA 75KVA TRANSFORMER (SEE ATTACHED MM-0-ED9).
B. EXISTING WIRING FED FROM TOP OF PANEL BY:
* 1-1/2" C. (WIRING FILL >40%).
EXISTING WIRING FED FROM BOTTOM OF PANEL BY:
* 1-4" C. TO TRANSFORMER (WIRING FILL >40%).
* 3-2" C. (WIRING FILL >40%).

CONTRACT NO
14-FQ10060-CENI-24

DESIGNED <u>C. MD</u>	DATE <u>09-14</u>	REFERENCE DRAWINGS		REVISIONS	
		NUMBER	DESCRIPTION	DATE	BY
DRAWN <u>C. MD</u>	DATE <u>09-14</u>				
CHECKED <u>B. EMB</u>	DATE <u>09-14</u>				
APPROVED <u>N/A</u>	DATE				

WASHINGTON METROPOLITAN AREA TRANSIT AUTHORITY
DEPARTMENT OF TRANSIT INFRASTRUCTURE AND ENGINEERING SERVICES
OFFICE OF INFRASTRUCTURE RENEWAL PROGRAM


GFP A Generali Financing/Personnel JOINT VENTURE

APPROVED _____ SUBMITTED _____ PROJECT MANAGER

NEW ELECTRONIC PAY PROGRAM (NEPP) IN METRORAIL STATIONS
CAPITOL HEIGHTS
PANEL SCHEDULE

SCALE NOT TO SCALE DRAWING NO G02-E-102

DESIGNED _____ DATE _____
 DRAWN _____ DATE _____
 CHECKED _____ DATE _____
 APPROVED _____ DATE _____

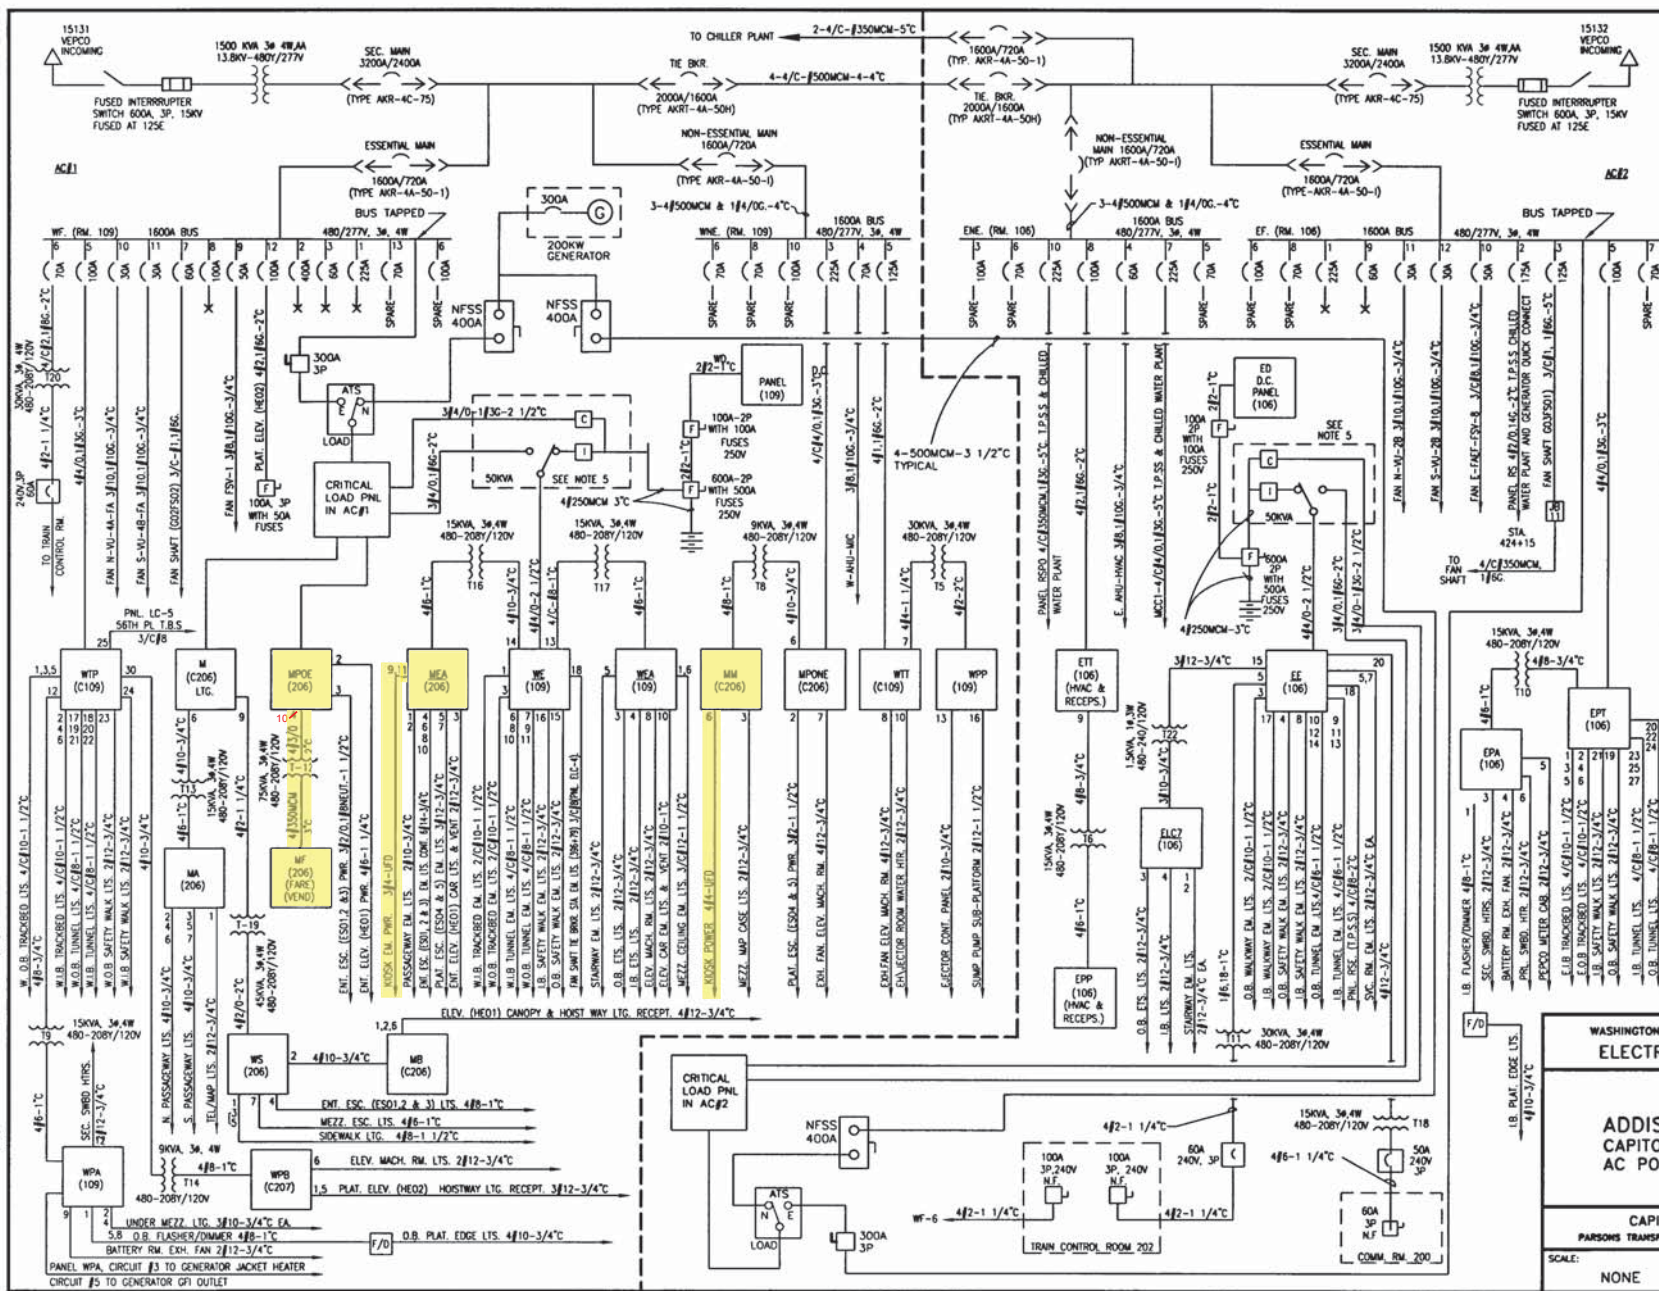

- NOTES:**
1. PANEL DESIGNATION
 PANEL DESIGNATION WHEN UNDERLINED IS EMERGENCY
 ROOM NUMBER
 TYPE OF DISTRIBUTION *
 8 (CIRCUIT NUMBER)
 * WHEN NO CXTS SHOWN
 2. 3/2, 2" CONDUIT SIZE *
 AWG OR KCMIL CIRCUIT WIRES *
 * AS TAKEN FROM AS BUILT DWGS.
 3. CIRCUIT BREAKERS
 DRAW OUT \rightarrow 1600A/1200A MOLDED CASE
 FRAME SIZE
 CONTINUOUS CURRENT SETTING
 4. 4/C # 4/0 INDICATES MULTICONDUCTOR CABLE WITH 4 CONDUCTORS AND SIZE OF EACH 4/0
 5. RATING AS SHOWN FOR UNINTERRUPTIBLE POWER SUPPLY CONSISTING OF RECTIFIER/CHARGER, INVERTER, POWER TRANSFER SWITCH, ASSOCIATED BATTERIES AND D.C. PANELBOARD.
 6. SWITCHGEAR MANUFACTURER GENERAL ELECTRIC
 7. UPS MANUFACTURER INTERNATIONAL POWER MACHINE

Pre-Inspection Field Verification 11/06/2014

REVISIONS	
DATE	DESCRIPTION
6/02	RJM ADOED EMERGENCY GENERATOR


WASHINGTON METROPOLITAN AREA TRANSIT AUTHORITY
ELECTRICAL MAINTENANCE MAP

**ADDITION ROUTE
 CAPITOL HEIGHTS STATION-G02
 AC POWER ONE LINE DIAGRAMS**

CAPITAL IMPROVEMENT PROGRAM
 PARSONS TRANSPORTATION GROUP - CAPITAL TRANSIT CONSULTANTS

SCALE: NONE DRAWING No. MM-G-E09

Pre-Inspection Mezzanine Walkthrough Checklist

Date: 11/06/2014	Station Name: Addison Road - G03	Mezzanine #: 092	Completed By: Tino Sahoo	
Check	Task	Equipment	Room ID	Notes
<input checked="" type="checkbox"/>	Verify that electrical power design matches the field/record. Identify locations of the electrical equipment.	Electrical Source Panel Existing SWBD "2"/ESS-2 Name/Number: Source Breaker Name/Number: Primary T9 "F" (Breaker #1) Electrical AFC Panel Panel F Name/Number:	Rm 207 Rm 207 Rm 207	Room 207 is on Track 1 wayside. SWBD on as-built is listed as ESS-2, but in field is listed as Existing SWBD "2".
<input checked="" type="checkbox"/>	Verify if disconnect switch is connected to the AFC electrical power panel. Low or High voltage SMNT/POWR escorts requirements?	Disconnect Name/Number: "CB-6" SMNT/POWR escorts: LOW Voltage	Rm 207	
<input checked="" type="checkbox"/>	Check if there is a shared raceway between AFC Panel and Kiosk and identify additional source panels to be de-energized.	Do AFC Panel loads feed into a shared raceway e.g. trench or trough? If Yes, specify source panels in notes. NO		No handholes on mezzanine floor. Conduit/ducts on two levels.
<input checked="" type="checkbox"/>	Identify the assumed pathway of duct / conduit, the location of the handholes, manholes and boxes and accessibility or special escort requirement?	PLNT <input type="checkbox"/> COMM / IT <input type="checkbox"/> ELES <input type="checkbox"/> RAIL <input type="checkbox"/> CMNT <input type="checkbox"/> Other Access/Support:		Power run from Kiosk to AFC Panel is 20'. Power run is from Kiosk to Junction box (located on platform level in AC SWBD room 207 directly below the Kiosk); Junction box to AFC Panel.
<input checked="" type="checkbox"/>	Identify handhole or manhole access requirement.	Required PLNT Mason for handhole/manhole access? NO Identified Conduit/Duct Transition to mezzanine level? YES		The run portion from Kiosk to Junction box is approx. 5' of duct. Run portion from Junction box to AFC Panel is approx. 15' of conduit.
Emergency Power Verification				
Check	Task	Equipment	Room ID	Notes
<input checked="" type="checkbox"/>	Verify if AFC electrical panel is connected to an Automatic Transfer Switch (ATS).	ATS Name/Number:		
<input checked="" type="checkbox"/>	Verification of Kiosk Emergency Panel(s) (KE, KES, KESS, etc)	Source Panel Name/Number: EP02B Emergency Power Source Breaker Name/Number: Breaker # 4 Panel Name/Number: Kiosk Emergency Panel	Rm 207 Rm 207 Kiosk	Panel KE (Kiosk Emergency Panel) located in Kiosk, Breaker #1 de-energizes emergency power for faregates.
Notes and Discrepancies:				
Sign Off	GFP Representative	WMATA PRGM		
Name:	Tino Sahoo			
Signature:				
Date:	11/06/2014			

Picture 1: G03 Addison Road – No handholes in Mezzanine




Picture 2: G03 Addison Road – No handholes in Mezzanine



Picture 3: G03 Addison Road – AFC Panel F in Room 207



Picture 4: G03 Addison Road – AFC Panel F in Room 207

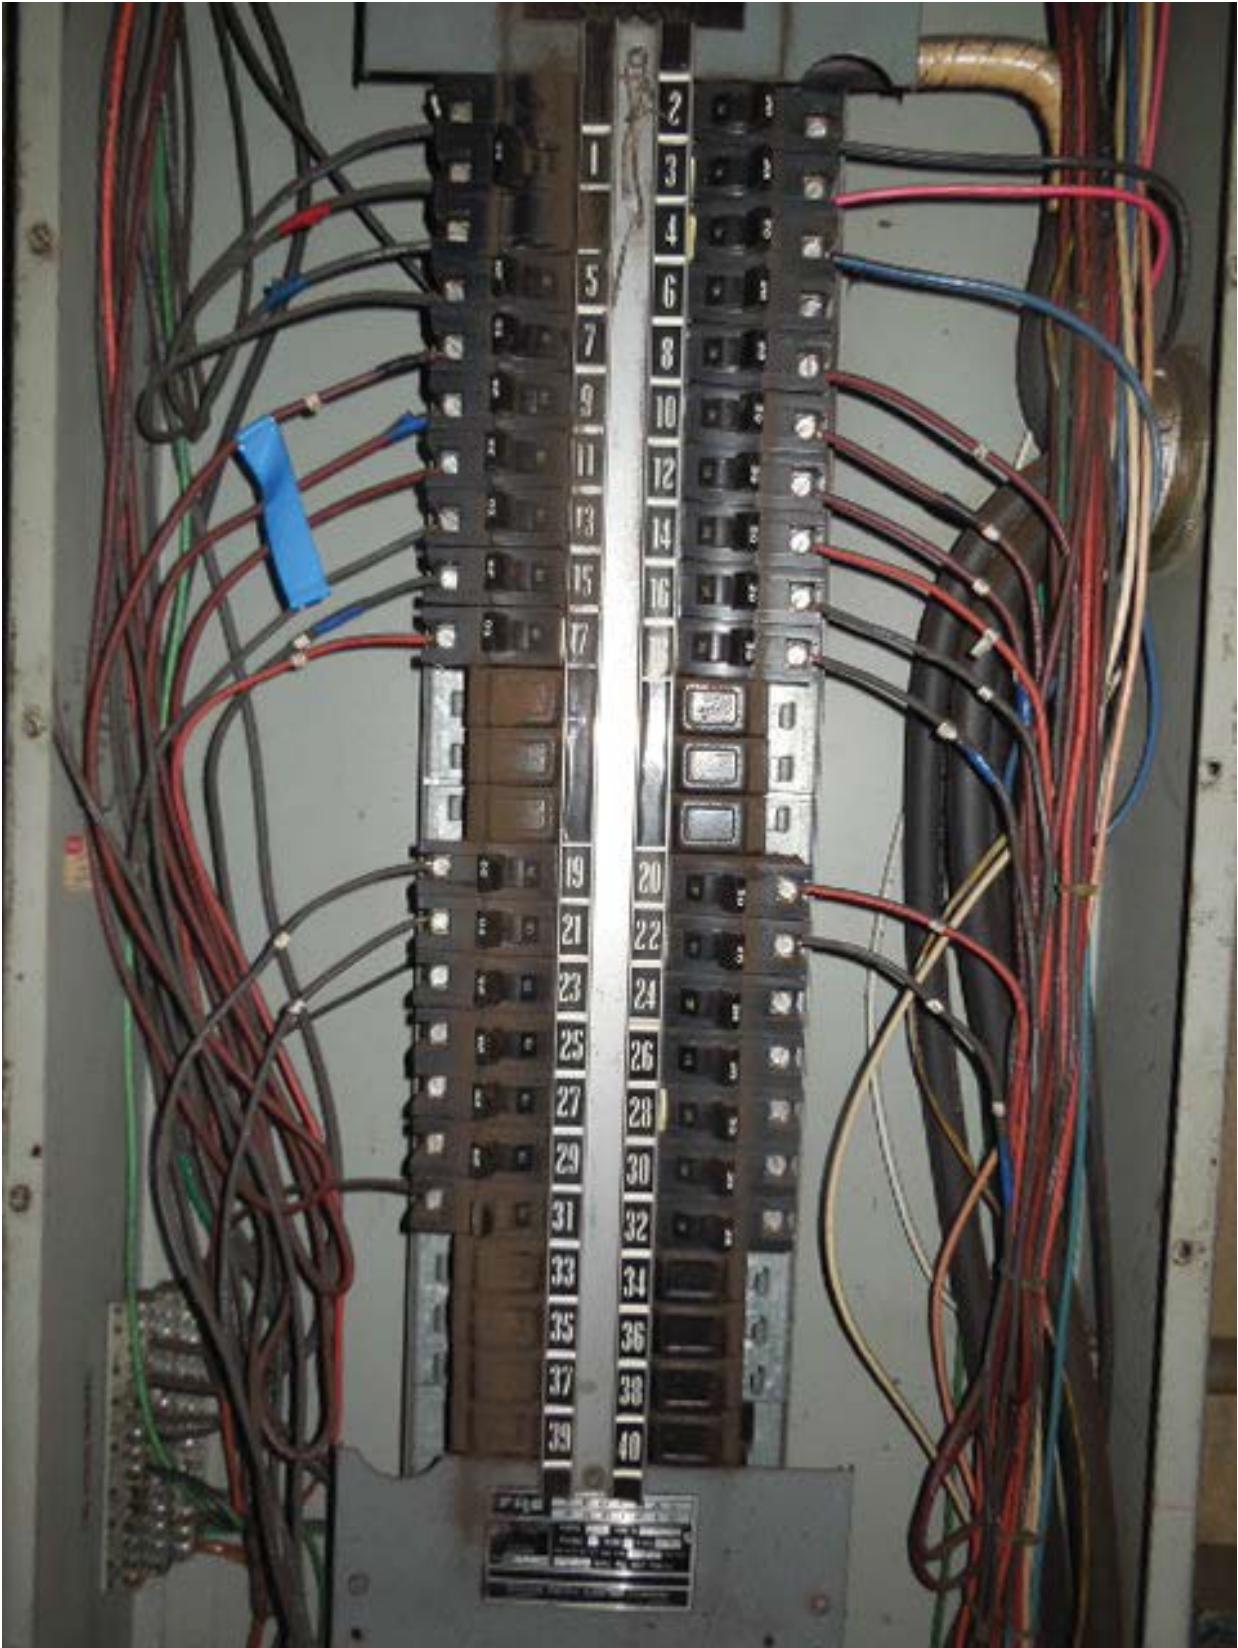

Picture 5: G03 Addison Road – AFC Panel F in Room 207 – Panel schedule

FFZE

PANEL BOARD: F F


FED FROM:

CIR.	LOAD DESCRIPTION
1	Kiosk AC 3Ø
2	SMART TRIP CARD VENDOR
3	Smart Trip - Red Wire
4	SMART TRIP CARD VENDORS (PRIVATE)
5	Kiosk recpt. outside base
6	
7	TRIP CARD VENDOR 34
8	" " " 35
9	" " " 22
10	" " " 38
11	" " " 31
12	" " " 30
13	" " " R to [unclear]
14	" " " 30
15	" " " 11
16	" " " 10
17	" " " 10
18	" " " 12
19	" " " 11
20	" " " 10
21	A.C. Trip Upgrade
22	" " " "
23	" " " "
24	Line 3302117 Breaker is tied
25	to Gate Emergency Alarm in Kiosk
26	
27	
28	Transfer Space
29	
30	Transfer Space
31	Peeco metering
32	
33	
34	
35	
36	

Picture 6: G03 Addison Road – AFC Panel F in Room 207 – Conduits above panel



Picture 8: G03 Addison Road – One line diagram in Room 207 – Different diagram than As-built

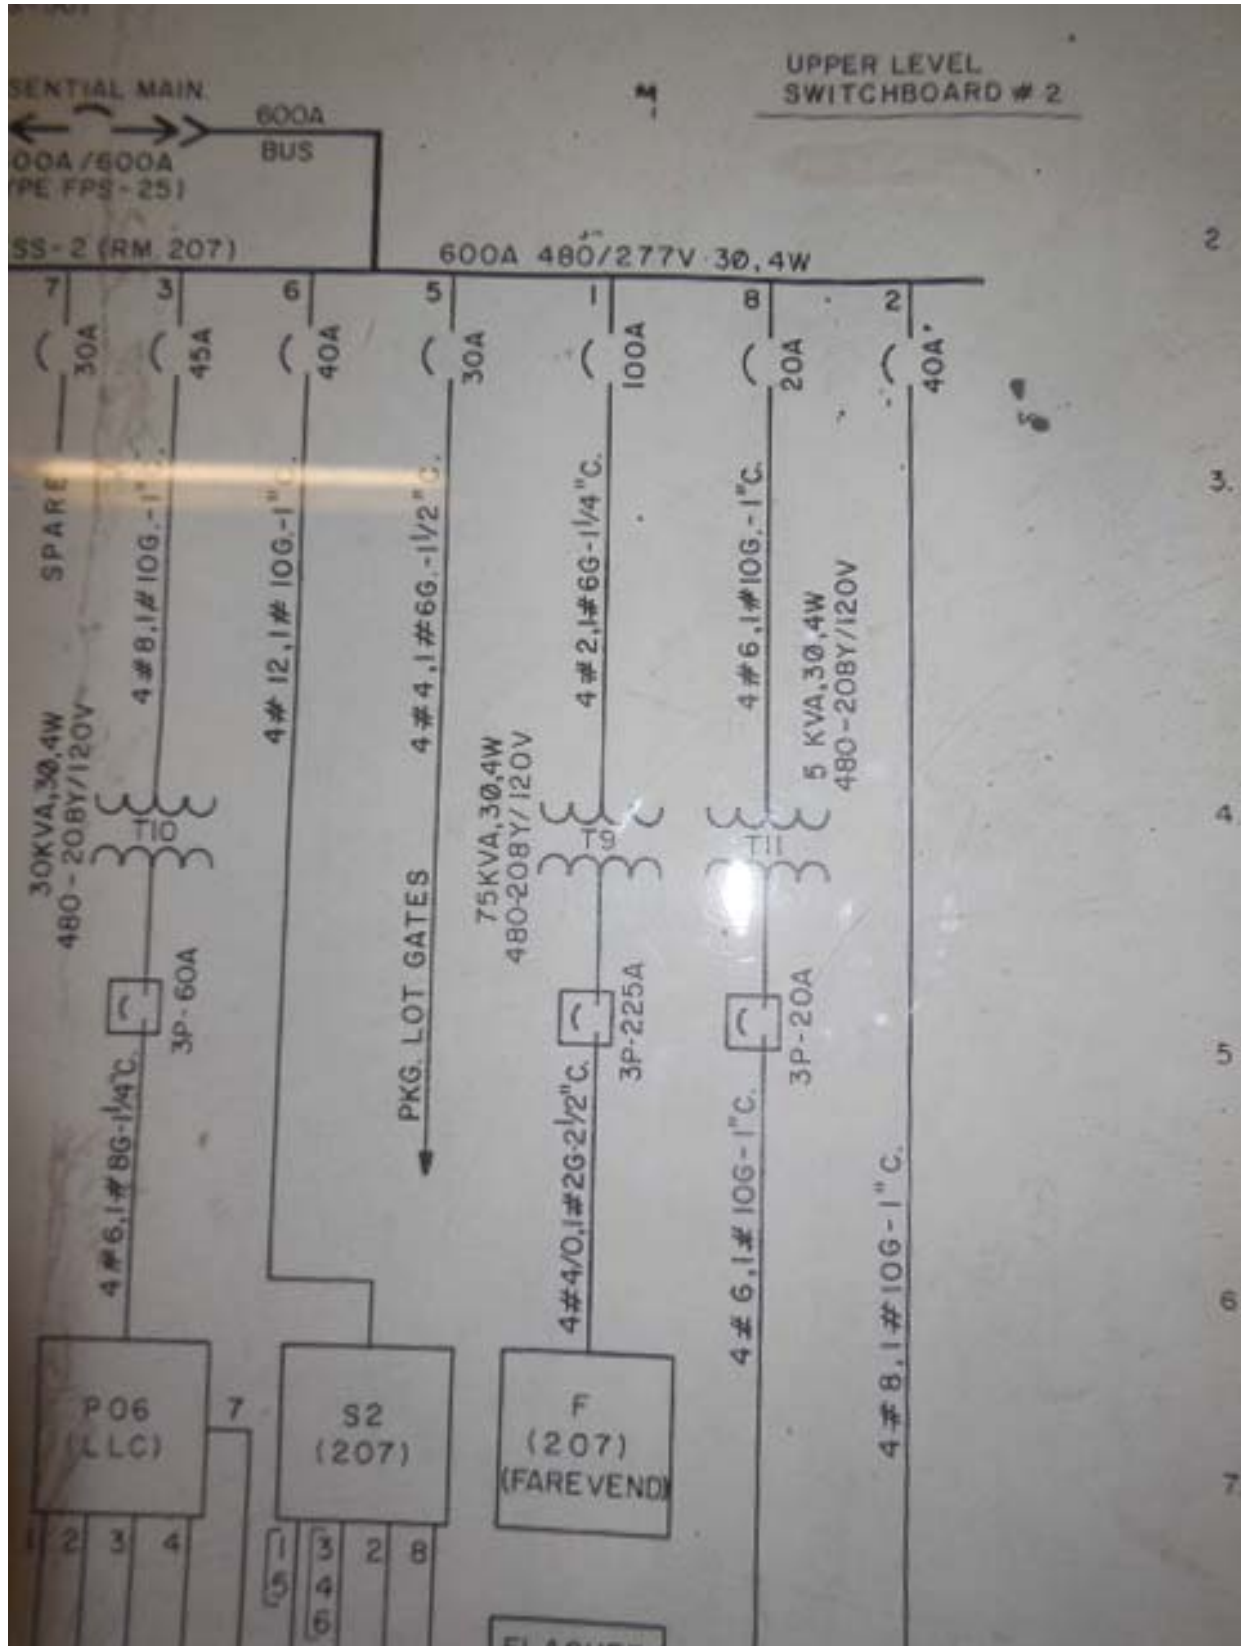

Picture 9: G03 Addison Road – Essential Section in Room 207



Picture 10: G03 Addison Road – Primary T9 “F” Disconnect Switch in Room 207



Picture 11: G03 Addison Road – EP02B Emergency Power Panel



Picture 12: G03 Addison Road – EP02B Emergency Power Panel in Room 207 – Circuit 4



Picture 13: G03 Addison Road – EP02B Emergency Power Panel in Room 207 – Panel schedule

PANEL BOARD: EP02B

FED FROM: EP01

CIR.	LOAD DESCRIPTION
1	Esc. Pit. #2
2	Elev. Mach. Rm.
3	Spare SUMP PUMP
4	Kiosk EM Pnl.
5	
6	
7	
8	
9	
10	
11	


Picture 14: G03 Addison Road – DB-6 Disconnect switch in Room 207



Pre-Inspection Field
Verification 11/06/2014

NOTES

1. ALL DIMENSIONS (CONCRETE WORK & CURBS) IS BASED ON THE PLAN SUPPLIED TO CLIC, WESTERN DIV. BY WMATA.
2. TOTAL MACHINE INVENTORY IS SHOWN ON THE DRAWING.
3. THE MINIMUM OPERATIONAL MACHINE INVENTORY IS DIFFERENT FROM THE DRAWING BY THE SEARCH OF THE MACHINE.
4. THE PREVIOUS DRAWINGS AND SUPPORT DOCUMENTATION PACKAGE FOR THIS PROJECT.

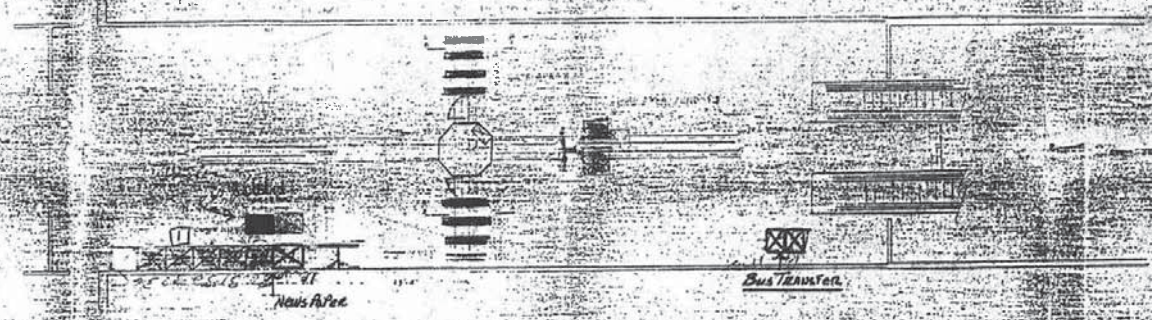

ADDISON ROAD STATION

CP-23007A-140-2-0

WASHINGTON METROPOLITAN
AREA TRANSIT AUTHORITY
APPROVED
Approved: Does Not Relieve the Contractor
of the Responsibility for the Accuracy
of this Document or for Full Compliance
with the Contract Requirements.
BY: *[Signature]*
DATE: *[Date]*

WASHINGTON METROPOLITAN
AREA TRANSIT AUTHORITY



AS BUILT
AS OF 11-22-89

CLIC/WESTERN DIV.

PCD-65

(92)

Pre-Inspection Field
Verification 11/06/2014

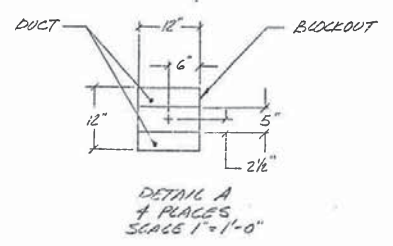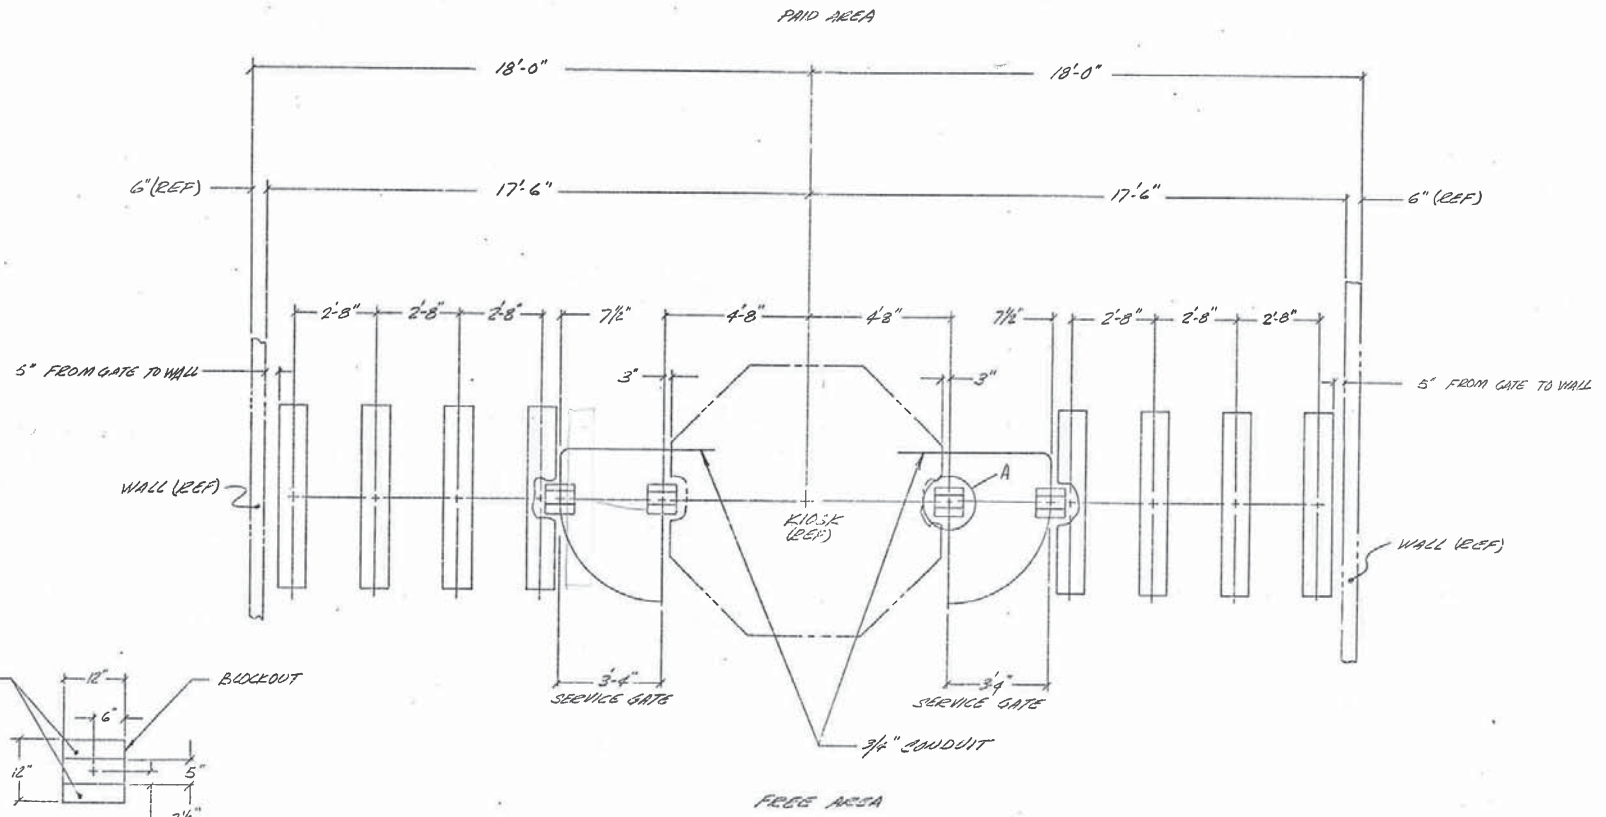

FREE AREA
-1

DATE: 11/06/2014		SCALE: 1/2" = 1'-0"	
DRAWING NUMBER: 948-0372			
SHEET 1 OF 1			
TITLE: CUBIC WESTERN DATA			
PROJECT: HILSON ROAD STATION			
SUBJECT: SERVICE GATE & KIOSK			
CODE IDENT NO. 94987			
DESIGNER	CHECKER	ENGINEER	APPROVAL

REF 3R-10B2 SCALE 1/2" = 1'-0"

Pre-Inspection Field
Verification 11/06/2014

EXISTING PANEL "F" ✓										
AMPERES: 225		VOLTS: 120/208		MOUNTING: SURFACE						
MAINS: 225A MLO		PHASE: 3		LOCATION: ROOM #207 ✓						
RATING: 10K AIC		WIRE: 4		SECTION: 1 OF 1						
LOAD DESCRIPTION	KVA	AMP	POLE	CKT NO.	CKT	CKT BKRS	AMP	KVA	LOAD DESCRIPTION	
EXIST. LOAD CENTER "KES"	2.7	30	3	1	A - -	2	1	20	0.8	EXISTING VENDOR
	2.5	-	-	3	- B -	4	1	20	0.8	EXISTING VENDOR
	2.5	-	-	5	- - C	6	1	20	0.8	EXISTING VENDOR
EXISTING VENDOR	0.8	20	1	7	A - -	8	1	20	0.0	SPARE
EXISTING VENDOR	0.8	20	1	9	- B -	10	1	20	0.8	EXISTING VENDOR
EXISTING VENDOR	0.8	20	1	11	- - C	12	1	20	0.8	EXISTING VENDOR
EXISTING VENDOR	0.8	20	1	13	A - -	14	1	20	0.8	EXISTING VENDOR
EXISTING VENDOR	0.8	20	1	15	- B -	16	1	20	0.8	EXISTING VENDOR
EXISTING VENDOR	0.8	20	1	17	- - C	18	1	20	0.8	EXISTING VENDOR
EXISTING VENDOR	0.8	20	1	19	A - -	20	1	20	0.8	EXISTING VENDOR
SPACE	0.0	-	-	21	- B -	22	-	-	0.0	SPACE
SPACE	0.0	-	-	23	- - C	24	-	-	0.0	SPACE
SPACE	0.0	-	-	25	A - -	26	-	-	0.0	SPACE
EXISTING VENDOR	0.8	20	1	27	- B -	28	1	20	0.8	EXISTING VENDOR
EXISTING VENDOR	0.8	20	1	29	- - C	30	1	20	0.8	EXISTING VENDOR
NEW KIOSK RECEPT. (IT & NEPP)	0.0	20	1	31	A - -	32	1	20	0.0	SPARE
SPARE (KIOSK)	0.0	20	1	33	- B -	34	1	20	0.0	SPARE
SPARE	0.0	20	1	35	- - C	36	1	20	0.0	SPARE
SPARE	0.0	20	1	37	A - -	38	1	20	0.0	SPARE
EXISTING VENDOR	0.8	20	1	39	- B -	40	1	20	0.0	SPARE
SPACE	0.0	-	-	41	- - C	42	-	-	0.0	SPACE
SPACE	0.0	-	-	43	A - -	44	-	-	0.0	SPACE
SPACE	0.0	-	-	45	- B -	46	-	-	0.0	SPACE
SPACE	0.0	-	-	47	- - C	48	-	-	0.0	SPACE

← 1
← 1&2

1
1&2

NOTES 1. CONNECT NEW FEEDER TO EXISTING SPARE 20A, 1P, CB
2. CB TO BE RESERVED FOR FUTURE AFC

LOAD SUMMARY

LIGHTS	0.0 x 125%	0.0 KVA
RECEPTACLES FIRST 10 KVA	10.0 x 100%	10.0 KVA
RECEPTACLES	7.8 x 50%	3.9 KVA
MISC APPLIANCES	0.0 x 100%	0.0 KVA
LARGEST MOTOR	0.0 x 125%	0.0 KVA
MOTORS	0.0 x 100%	0.0 KVA
HEAT	3.0 x 125%	3.8 KVA
AC	4.5 x 100%	4.5 KVA
WATER HEATING	0.0 x 125%	0.0 KVA
TOTAL CONNECTED LOAD	25.3 KVA	TOTAL DEMAND KVA 22.2 KVA
		TOTAL DEMAND AMPS 61.5 AMPS
CONNECTED LOAD PHASE SUMMARY		
PHASE A:	8.3 KVA	
PHASE B:	8.9 KVA	
PHASE C:	8.1 KVA	

NOTES: A. EXISTING PANEL "F" IS FED FROM 277/480V, 3Ø, 4W EXISTING SWBD "2" LOCATED IN ROOM 207, CIRCUIT #1-100/3P TO 200A DISC. SW., VIA 75KVA TRANSFORMER (SEE ATTACHED MM-6-E11).
B. EXISTING WIRING FED FROM BOTTOM OF PANEL BY:
* 4-2" C. (2-WIRING FILL >40% & 2-EMPTY CONDUIT).
EXISTING WIRING FED FROM RIGHT SIDE OF PANEL BY:
* 1-3" C. TO DISCONNECT SWITCH (WIRING FILL >40%).

CONTRACT NO
14-FQ10060-CENI-24

DESIGNED <u>C. HED</u>	DATE	REFERENCE DRAWINGS		REVISIONS	
		NUMBER	DESCRIPTION	DATE	BY
DRAWN <u>C. HED</u>	DATE				
CHECKED <u>A. KES</u>	DATE				
APPROVED <u>JVA</u>	DATE				

WASHINGTON METROPOLITAN AREA TRANSIT AUTHORITY

DEPARTMENT OF TRANSIT INFRASTRUCTURE
AND ENGINEERING SERVICES
OFFICE OF INFRASTRUCTURE RENEWAL PROGRAM




APPROVED _____

SUBMITTED _____
PROJECT MANAGER

NEW ELECTRONIC PAY PROGRAM (NEPP)
IN METRO RAIL STATIONS
ADDISON ROAD
PANEL SCHEDULE

SCALE
NOT TO SCALE

DRAWING NO
G03-E-102

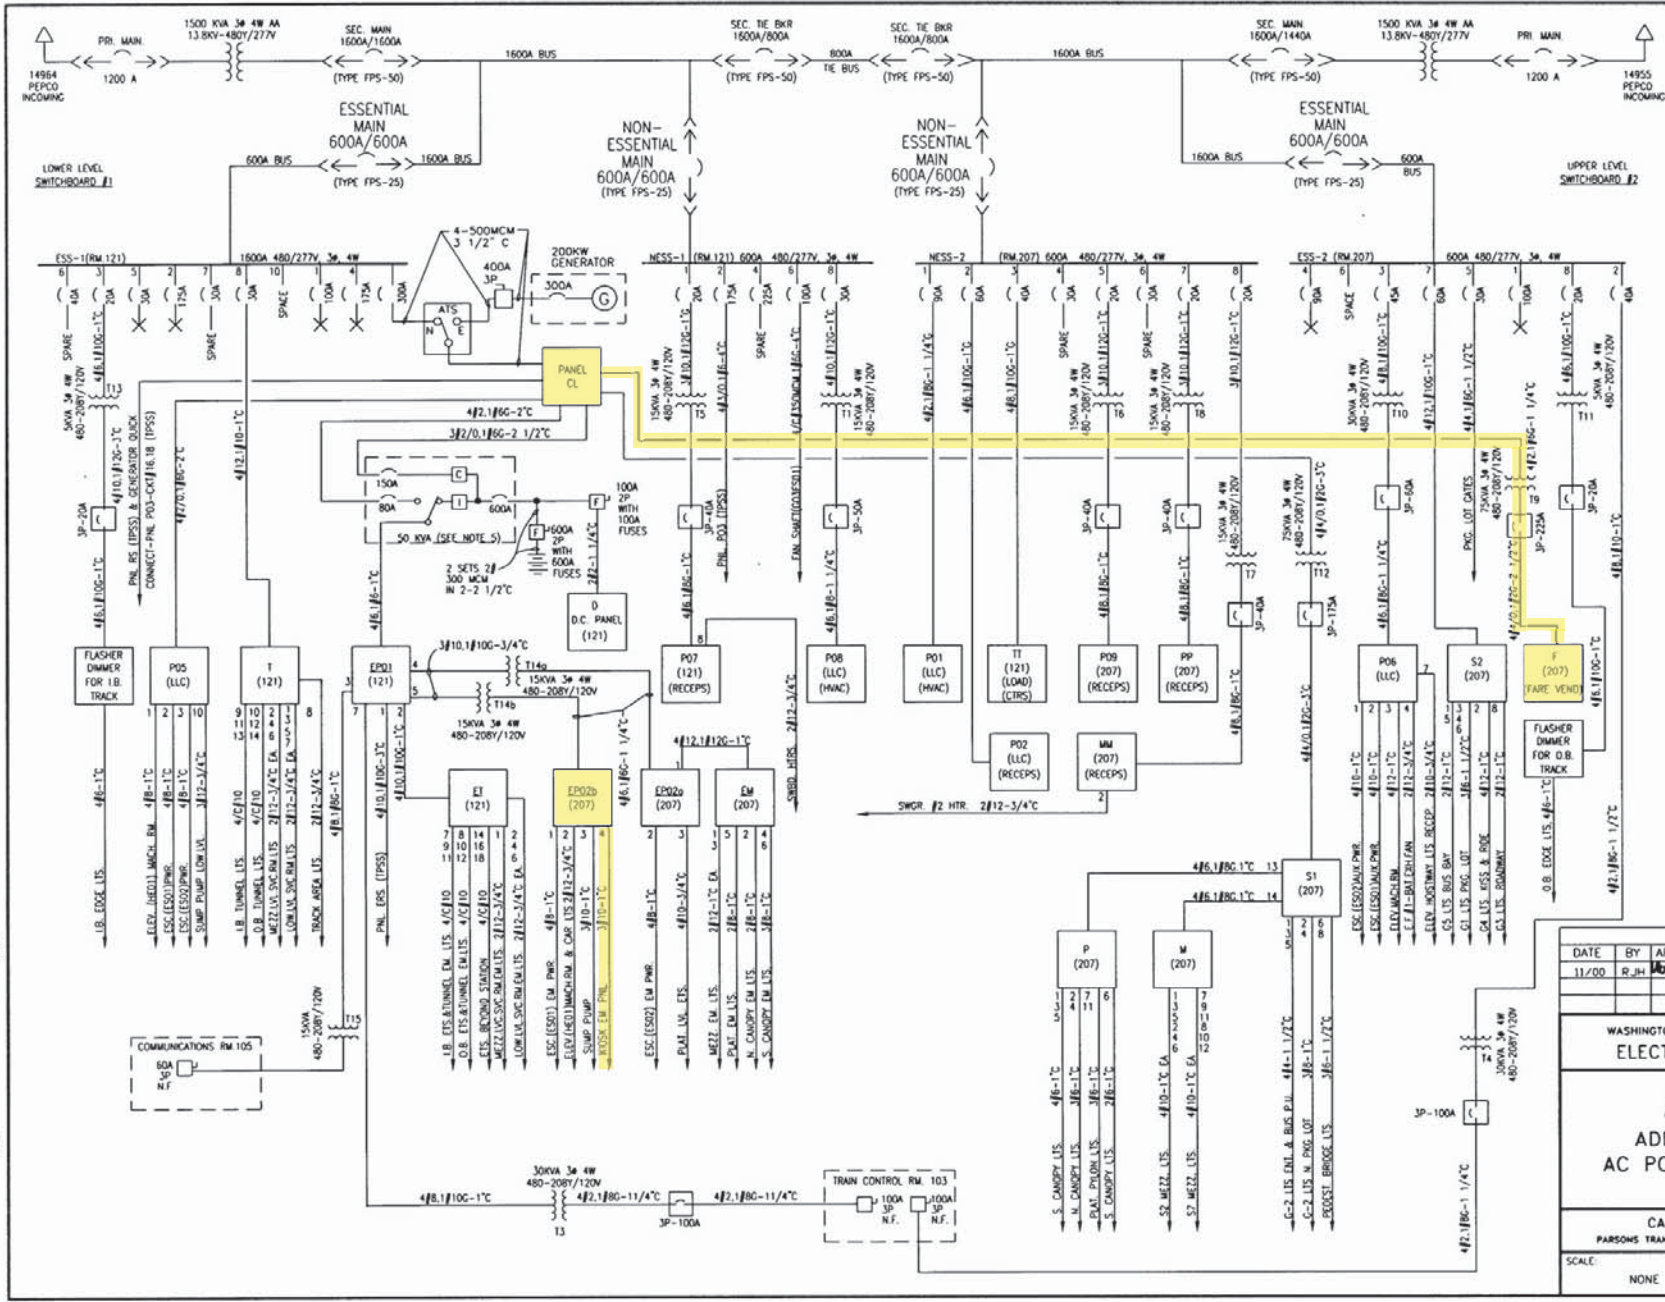

- NOTES:**
1. PANEL DESIGNATION
 PANEL DESIGNATION WHEN UNDERLINED IS EMERGENCY (LIGHTING)
 ROOM NUMBER
 TYPE OF DISTRIBUTION
 B (CIRCUIT NUMBER)
 * WHEN NO CKTS SHOWN
 2. 3/2, 2" CONDUIT SIZE
 AWG OR KCMIL CIRCUIT WIRES
 * AS TAKEN FROM AS BUILT DWGS
 3. CIRCUIT BREAKERS
 DRAW OUT
 MOULDED CASE
 FRAME SIZE
 CONTINUOUS CURRENT SETTING
 4. 4/C # 4/0
 INDICATES MULTICONDUCTOR CABLE WITH 4 CONDUCTORS AND SIZE OF EACH 4/0
 5. RATING AS SHOWN FOR UNINTERRUPTIBLE POWER SUPPLY CONSISTING OF RECTIFIER/CHARGER, INVERTER, POWER TRANSFER SWITCH, ASSOCIATED BATTERIES AND D.C. PANELBOARD.
 6. SWITCHGEAR MANUFACTURER: FEDERAL PACIFIC
 TYPE OF BREAKERS: ICS
 7. UPS MANUFACTURER: IPM

Pre-Inspection Field Verification 11/06/2014

REVISIONS	
DATE	DESCRIPTION
11/00	R, JH, APRVD, ADDD EMERGENCY GENERATOR

WASHINGTON METROPOLITAN AREA TRANSIT AUTHORITY
 ELECTRICAL MAINTENANCE MAP


**ADDISON ROUTE
 ADDISON ROAD STATION
 AC POWER ONE LINE DIAGRAM**

CAPITAL IMPROVEMENT PROGRAM
 PARSONS TRANSPORTATION GROUP - CAPITAL TRANSIT CONSULTANTS

SCALE: NONE DRAWING NO: MM-C-E11

DESIGNED: _____ DATE: _____
 CHECKED: _____ DATE: _____
 APPROVED: _____ DATE: _____
 DRAWN: _____

Pre-Inspection Mezzanine Walkthrough Checklist

Date: 11/06/2014		Station Name: Morgan Blvd - G04		Mezzanine #: 110		Completed By: Tino Sahoo	
Check	Task	Equipment	Room ID	Notes			
<input checked="" type="checkbox"/>	Verify that electrical power design matches the field/record. Identify locations of the electrical equipment.	Electrical Source Panel Name/Number: WMES Source Breaker Name/Number: Breaker #1, #3, #5 Electrical AFC Panel Name/Number: WMESS1	Rm 205 Rm 205 Rm 205				
<input checked="" type="checkbox"/>	Verify if disconnect switch is connected to the AFC electrical power panel. Low or High voltage SMNT/POWR escorts requirements?	Disconnect Name/Number: SMNT/POWR escorts: HIGH and LOW Voltage					
<input checked="" type="checkbox"/>	Check if there is a shared raceway between AFC Panel and Kiosk and identify additional source panels to be de-energized.	Do AFC Panel loads feed into a shared raceway e.g. trench or trough? If Yes, specify source panels in notes. NO					
<input checked="" type="checkbox"/>	Identify the assumed pathway of duct / conduit, the location of the handholes, manholes and boxes and accessibility or special escort requirement?	PLNT <input checked="" type="checkbox"/> COMM / IT <input type="checkbox"/> ELES <input type="checkbox"/> RAIL <input type="checkbox"/> CMNT <input type="checkbox"/> Other Access/Support:					
<input checked="" type="checkbox"/>	Identify handhole or manhole access requirement.	Required PLNT Mason for handhole/manhole access? YES (see notes) Identified Conduit/Duct Transition to mezzanine level? YES		All conduit/ducts on one level. Power run from Kiosk to AFC Panel is approx. 90' via 4 handholes.			
Emergency Power Verification							
Check	Task	Equipment	Room ID	Notes			
<input checked="" type="checkbox"/>	Verify if AFC electrical panel is connected to an Automatic Transfer Switch (ATS).	ATS Name/Number:					
<input checked="" type="checkbox"/>	Verification of Kiosk Emergency Panel(s) (KE, KES, KESS, etc)	Source Panel Name/Number: WMEE Source Breaker Name/Number: Breaker #3 Panel Name/Number: Kiosk Emergency Panel	Rm 205 Rm 205 Kiosk	Shown on as-built as Breaker #7, #9, #11. Panel KE located in Kiosk, Breaker #1 de-energizes emergency power to faregates.			
Notes and Discrepancies:							
Sign Off		GFP Representative			WMATA PRGM		
Name:		Tino Sahoo					
Signature:							
Date:		11/06/2014					

Picture 1: G04 Morgan Boulevard – Manhole in Mezzanine



Picture 2: G04 Morgan Boulevard – Manholes in Mezzanine



Picture 3: G04 Morgan Boulevard – Manholes in Mezzanine




Picture 4: G04 Morgan Boulevard – AFC Panel WMESSI in Room 205



Picture 5: G04 Morgan Boulevard – AFC Panel WMESSI in Room 205



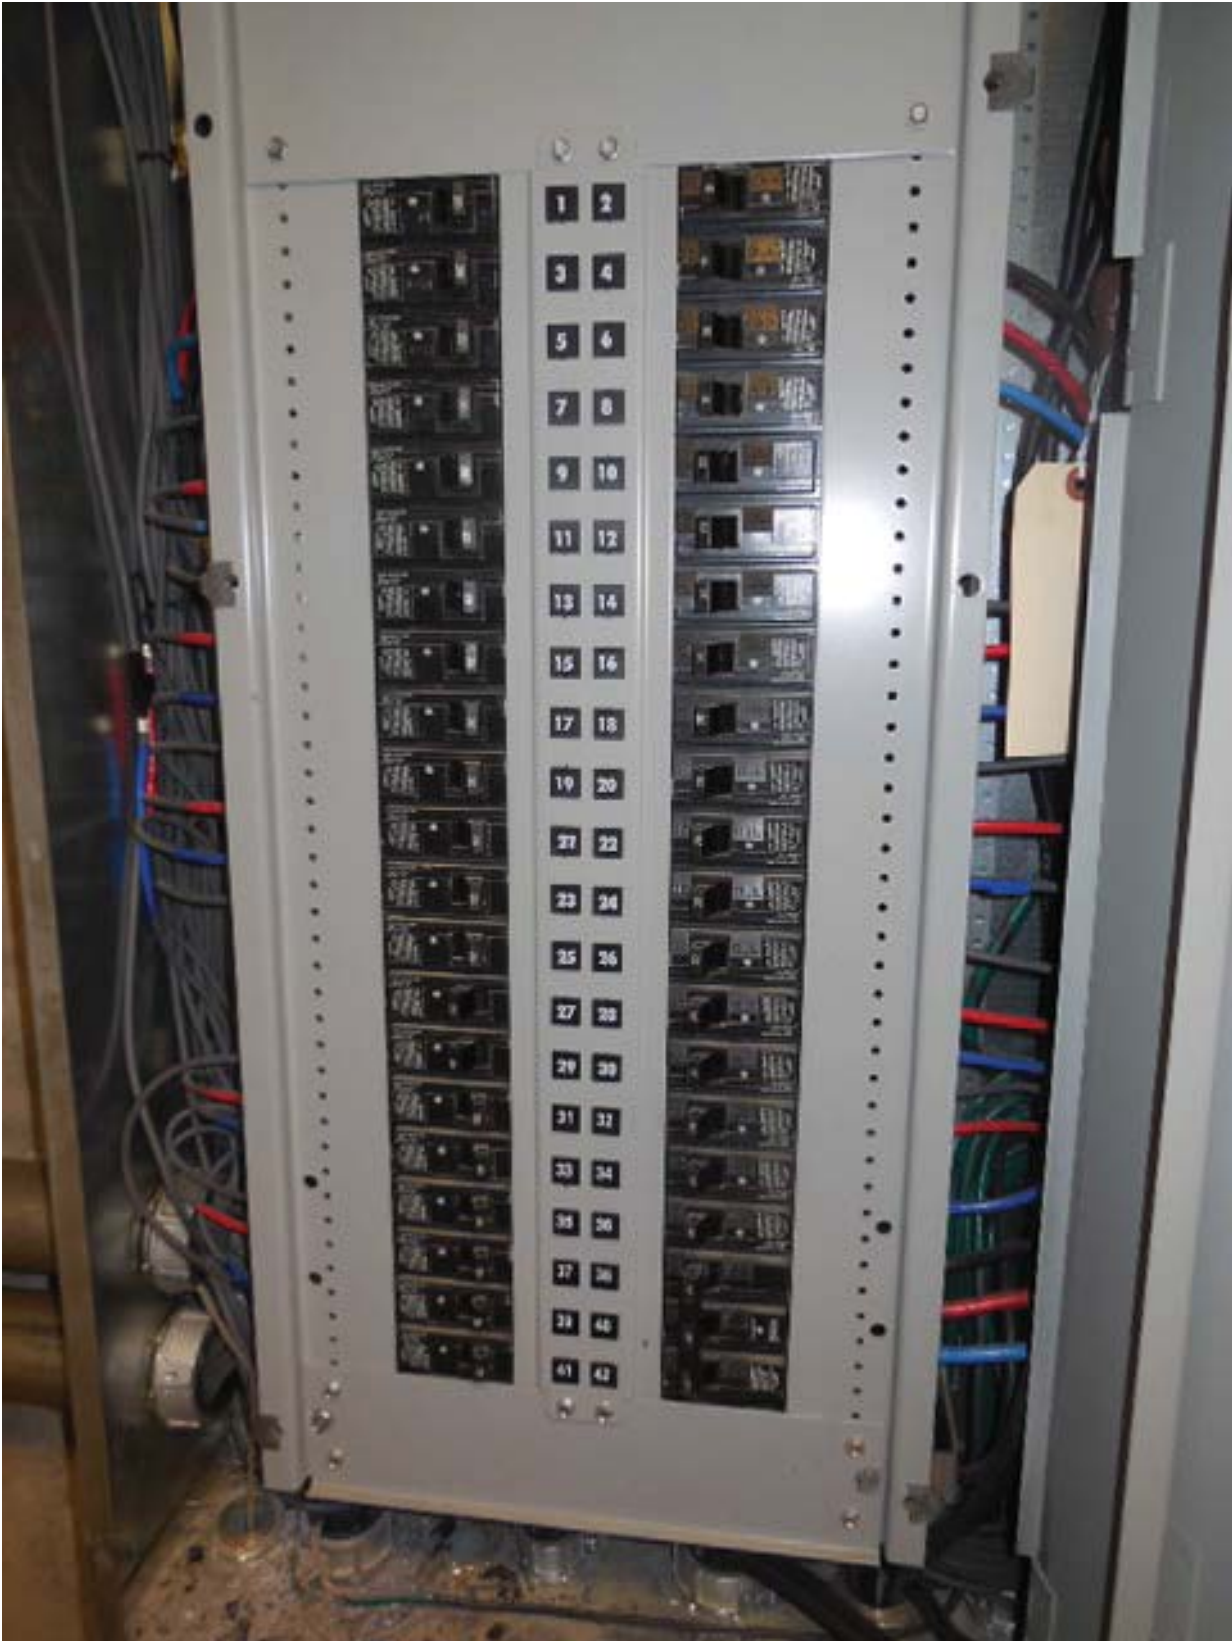

Picture 6: G04 Morgan Boulevard – AFC Panel WMESSI in Room 205



Picture 7: G04 Morgan Boulevard – AFC Panel WMESSI in Room 205 – Panel schedule

WMESSI			
120 / 208V 250A MCB - WEST MEZZ ELEC RM			
NORTH MAP CASE	1	2	MAP CASE - CONC
MAP CASE - COL. 3-A	3	4	MAP CASE - CONC COL3-B
MAP CASE - COL. 2-A	5	6	MAP CASE-CONC COL2-BB
FARE VENDING	7	8	ESC #2 BUS TRANSFR. DISP
FARE VENDING	9	10	ESC #1 BUS XFER DISP
FARE VENDING	11	12	ESC #1 BUS XFER DISP
FARE VENDING	13	14	FARE GATE CONSOLES
FARE VENDING	15	16	FARE GATE CONSOLES
FARE VENDING	17	18	FARE GATE CONSOLES
FARE VENDING	19	20	FARE GATE CONSOLES
FARE VENDING	21	22	FARE GATE CONSOLES
FARE VENDING	23	24	FARE GATE CONSOLES
FARE VENDING	25	26	SPARE
FARE VENDING ✓	27	28	SPARE
ADD FARE MACHINE ✓	29	30	SPARE
ADD FARE MACHINE	31	32	Smart SPARE
FARE GATE CONSOLES	33	34	Smart SPARE
FARE GATE CONSOLES	35	36	SPARE
FARE GATE CONSOLES	37	38	PNL KES
FARE GATE CONSOLES	39	40	
FARE GATE CONSOLES	41	42	
FARE GATE CONSOLES	41	42	

✓ BKT. 27 & 29
 ✓ WIRE REMOVED
 FROM BKR,
 2/13/13 10

Picture 8: G04 Morgan Boulevard – Panel WMES in Room 205



Picture 9: G04 Morgan Boulevard – Panel WMES in Room 205



Picture 10: G04 Morgan Boulevard – Panel WMES in Room 205 – Panel schedule

WMES			
480 / 277V 600A MLO - WEST MEZZ ELEC RM			
TRANSFORMER T3 (PNL WMESS1)	1	2	SPARE
	3	4	
	5	6	
SPARE	7	8	EUH-2 (ELEVATOR MACHINE RM.)
	9	10	
	11	12	
ESCALATOR #3 PWR	13	14	ESCALATOR PWR
	15	16	
	17	18	
ESCALATOR #1 PWR	19	20	SPACE
	21	22	
	23	24	
EUH-3	25	26	XFMR T-2 (PNL WMESS)
EUH-4	27	28	
SPACE	29	30	
SPACE	31	32	SP-2
SPARE	33	34	
SPACE	35	36	
SPARE	37	38	
SPARE	39	40	SPARE
SPARE	41	42	SPARE
	150A ELEV MAIN		<i>ELEV ATOR</i>

TRULAND

Walker Seal

Picture 11: G04 Morgan Boulevard – Emergency Panel WMEE in Room 205





Picture 12: G04 Morgan Boulevard – Emergency Panel WMEE in Room 205 – Circuit 3



Picture 13: G04 Morgan Boulevard – Emergency Panel WMEE in Room 205 – Panel schedule

WMEE			
120 / 208V 50A MF - WEST MEZZ ELEC RM			
ESCALATOR #3 EM PWR	1	2	ESCALATOR #2 EM PWR
ESCALATOR #3 EM PWR			ESCALATOR #2 EM PWR
ESCALATOR #3 EM PWR			ESCALATOR #2 EM PWR
KIOSK EM PNL KE	3	4	ESCALATOR #1 EM PWR
			ESCALATOR #1 EM PWR
			ESCALATOR #1 EM PWR
ELEVATOR #1,2	5	6	SPARE
SPARE			SPARE
SPARE			LTG CONTRCTR
PIDS - COLUMN #7	7	8	LTG CONTRCTR
PIDS - COLUMN #7			BUSSED SPACE
BUSSED SPACE			BUSSED SPACE
PIDS - COUNCOURSE LVL.	9	10	BUSSED SPACE
BUSSED SPACE			BUSSED SPACE
BUSSED SPACE			BUSSED SPACE
BUSSED SPACE	11	12	BUSSED SPACE
BUSSED SPACE			BUSSED SPACE
BUSSED SPACE			BUSSED SPACE
SPACE	13	14	SPACE
SPACE			SPACE
SPACE			SPACE

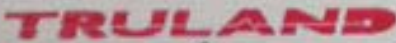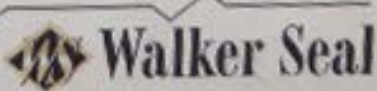Pre-Inspection Field
Verification 11/06/2014

EXISTING PANEL "WMESS1" ✓										
AMPERES: 250		VOLTS: 120/208		MOUNTING: SURFACE						
MAINS: 250A MCB		PHASE: 3		LOCATION: ELECTRICAL ROOM 205 ✓						
RATING: 10K AIC		WIRE: 4		SECTION: 1 OF 1						
LOAD DESCRIPTION	KVA	AMP	POLE	NO.	CTKT.	NO.	POLE	AMP	KVA	LOAD DESCRIPTION
SPARE	0.0	20	1	1	A - -	2	1	20	0.8	EXISTING VENDOR
EXISTING VENDOR	0.8	20	1	3	- B -	4	1	20	0.8	EXISTING VENDOR
EXISTING VENDOR	0.8	20	1	5	- - C	6	1	20	0.8	EXISTING VENDOR
EXISTING VENDOR	0.8	20	1	7	A - -	8	1	20	0.8	NEW KIOSK RECEPT. (IT & NEPP) 1 ✓
EXISTING VENDOR	0.8	20	1	9	- B -	10	1	20	0.0	SPARE (KIOSK) 1&2 ✓
EXISTING VENDOR	0.8	20	1	11	- - C	12	1	20	0.0	SPARE
EXISTING VENDOR	0.8	20	1	13	A - -	14	1	20	0.0	EXISTING VENDOR
EXISTING VENDOR	0.8	20	1	15	- B -	16	1	20	0.8	EXISTING VENDOR
EXISTING VENDOR	0.8	20	1	17	- - C	18	1	20	0.8	EXISTING VENDOR
EXISTING VENDOR	0.8	20	1	19	A - -	20	1	20	0.8	EXISTING VENDOR
EXISTING VENDOR	0.8	20	1	21	- B -	22	1	20	0.8	EXISTING VENDOR
EXISTING VENDOR	0.8	20	1	23	- - C	24	1	20	0.8	EXISTING VENDOR
EXISTING VENDOR	0.8	20	1	25	A - -	26	1	20	0.8	EXISTING VENDOR
SPARE	0.0	20	1	27	- B -	28	1	20	0.8	EXISTING VENDOR
SPARE	0.0	20	1	29	- - C	30	1	20	0.8	EXISTING VENDOR
EXISTING VENDOR	0.8	20	1	31	A - -	32	1	20	0.8	EXISTING VENDOR
EXISTING VENDOR	0.8	20	1	33	- B -	34	1	20	0.8	EXISTING VENDOR
EXISTING VENDOR	0.8	20	1	35	- - C	36	1	20	0.8	EXISTING VENDOR
EXISTING VENDOR	0.8	20	1	37	A - -	38	3	40	3.3	EXIST. KIOSK LOAD CENTER "KES"
EXISTING VENDOR	0.8	20	1	39	- B -	40	-	-	2.5	
EXISTING VENDOR	0.8	20	1	41	- - C	42	-	-	2.5	


NOTES: 1. CONNECT NEW FEEDER TO EXISTING SPARE 20A, 1P CB
2. CB TO BE RESERVED FOR FUTURE AFC

LOAD SUMMARY		
LIGHTS	0.0 x 125%	0.0 KVA
RECEPTACLES, FIRST 10 KVA	10.0 x 100%	10.0 KVA
RECEPTACLES	17.2 x 50%	8.6 KVA
MISC. APPLIANCES	0.0 x 100%	0.0 KVA
LARGEST MOTOR	0.0 x 125%	0.0 KVA
MOTORS	0.0 x 100%	0.0 KVA
HEAT	3.0 x 125%	3.8 KVA
AC	4.5 x 100%	4.5 KVA
WATER HEATING	0.0 x 125%	0.0 KVA
TOTAL CONNECTED LOAD	34.7 KVA	TOTAL DEMAND KVA 26.9 KVA
		TOTAL DEMAND AMPS 74.6 AMPS


CONNECTED LOAD PHASE SUMMARY	
PHASE A:	12.1 KVA
PHASE B:	11.3 KVA
PHASE C:	11.3 KVA

NOTES: A. EXISTING PANEL "WMESS1" IS FED FROM 277/480V, 3Ø, 4W EXISTING PANEL "WMES" LOCATED IN ELECTRICAL RM. 205, CIRCUIT #1,3,5-125/3P, VIA 75KVA TRANSFORMER (SEE ATTACHED MM-6-E15).
B. EXISTING WIRING FED FROM BOTTOM OF PANEL BY:
* 4-1" C. (WIRING FILL >40%).
* 3- 3/4" C. (1-WIRING FILL >40% & 2-EMPTY CONDUIT).
EXISTING WIRING FED FROM RIGHT SIDE OF PANEL BY:
* 1- 4" C. TO TRANSFORMER (WIRING FILL >40%).

CONTRACT No
14-FQ10060-CENI-24

DESIGNED <u>C. MOO</u> DATE <u>08-14</u>	NUMBER	DESCRIPTION	DATE	BY	DESCRIPTION	WASHINGTON METROPOLITAN AREA TRANSIT AUTHORITY DEPARTMENT OF TRANSIT INFRASTRUCTURE AND ENGINEERING SERVICES OFFICE OF INFRASTRUCTURE RENEWAL PROGRAM	 A Goodell Fleming/Parsons JOINT VENTURE	NEW ELECTRONIC PAY PROGRAM (NEPP) IN METRORAIL STATIONS MORGAN BLVD PANEL SCHEDULE		
DRAWN <u>C. MOO</u> DATE <u>08-14</u>					APPROVED _____			SUBMITTED _____	SCALE NOT TO SCALE	DRAWING NO. G04-E-102
CHECKED <u>S. OUB</u> DATE <u>08-14</u>										
APPROVED <u>NA</u> DATE _____										

Pre-Inspection Mezzanine Walkthrough Checklist

Date: 11/06/2014		Station Name: Largo Town Center - G05		Mezzanine #: 111		Completed By: Tino Sahoo	
Check	Task	Equipment	Room ID	Notes			
<input checked="" type="checkbox"/>	Verify that electrical power design matches the field/record. Identify locations of the electrical equipment.	Electrical Source Panel Name/Number: WMES Sect 1 Source Breaker Name/Number: Breaker #1, #3, #5 Electrical AFC Panel Name/Number: WMESS1	Rm 117 Rm 117 Rm 101				
<input checked="" type="checkbox"/>	Verify if disconnect switch is connected to the AFC electrical power panel. Low or High voltage SMNT/POWR escorts requirements?	Disconnect Name/Number: SMNT/POWR escorts: HIGH and LOW Voltage					
<input checked="" type="checkbox"/>	Check if there is a shared raceway between AFC Panel and Kiosk and identify additional source panels to be de-energized.	Do AFC Panel loads feed into a shared raceway e.g. trench or trough? If Yes, specify source panels in notes. NO					
<input checked="" type="checkbox"/>	Identify the assumed pathway of duct / conduit, the location of the handholes, manholes and boxes and accessibility or special escort requirement?	PLNT <input checked="" type="checkbox"/> COMM / IT <input type="checkbox"/> ELES <input type="checkbox"/> RAIL <input type="checkbox"/> CMNT <input type="checkbox"/> Other Access/Support:					
<input checked="" type="checkbox"/>	Identify handhole or manhole access requirement.	Required PLNT Mason for handhole/manhole access? YES (see notes) Identified Conduit/Duct Transition to mezzanine level? YES		All conduit/ducts on one level. Power run from Kiosk to AFC Panel is approx. 80' via 3 handholes.			
Emergency Power Verification							
Check	Task	Equipment	Room ID	Notes			
<input checked="" type="checkbox"/>	Verify if AFC electrical panel is connected to an Automatic Transfer Switch (ATS).	ATS Name/Number:					
<input checked="" type="checkbox"/>	Verification of Kiosk Emergency Panel(s) (KE, KES, KESS, etc)	Source Panel Name/Number: WMEE Source Breaker Name/Number: Breaker #1, #3, #5 Panel Name/Number: Kiosk Panel KE	Rm 117 Rm 117 Kiosk	Panel KE located in the Kiosk, Breaker #4 will de-energize emergency power to faregates.			
Notes and Discrepancies:							
Sign Off		GFP Representative			WMATA PRGM		
Name:		Tino Sahoo					
Signature:							
Date:		11/06/2014					

Picture 1: G05 Largo Town Center – Manhole in Mezzanine



Picture 2: G05 Largo Town Center – Manholes in Mezzanine



Picture 3: G05 Largo Town Center – Manhole in Service area



Picture 4: G05 Largo Town Center – AFC Panel WMESS1 in Room 117



Picture 5: G05 Largo Town Center – AFC Panel WMESS1 in Room 117



Picture 6: G05 Largo Town Center – AFC Panel WMESS1 in Room 117



Picture 7: G05 Largo Town Center – AFC Panel WMESS1 in Room 117 – Panel schedule

WMESS1

120/208V 250A MCB-WEST CONCOURSE CORRIDOR

MAP CASE/SIGN	1	2	TEL/MAP CASE AT COL 6-F
TEL/MAP CASE	3	4	ESC #2 BUS XFER DISP.1
SPARE ATM	5	8	MAP CASE/SIGNS
ESC #4 BUS XFER DISP#1	7	8	ESC #1 BUS XFER DISP.1
ESC #4 BUS XFER DISP#2	9	10	ESC #1 BUS XFER DISP.2
FARE VENDING 37	11	12	SPARE
FARE VENDING	13	14	FARE GATE CONSOLES
FARE VENDING	15	16	FARE GATE CONSOLES
FARE VENDING	17	18	FARE GATE CONSOLES
FARE VENDING	19	20	FARE GATE CONSOLES
FARE VENDING	21	22	FARE GATE CONSOLES
FARE VENDING	23	24	FARE GATE CONSOLES
FARE VENDING	25	26	FARE GATE CONSOLES
FARE VENDING 37	27	28	FARE GATE CONSOLES
FARE GATE	29	30	FARE GATE CONSOLES
ADD FARE MACH	31	32	FARE GATE CONSOLES
ADD FARE MACH	33	34	FARE GATE CONSOLES
V/SPARE 30	35	36	SPARE
SPARE 370 70	37	38	
SPARE TDM-71	39	40	PNL KES (KIOSK)
SPARE	41	42	

TRULAND Walker Seal

CKT 11 & 13
REMOVED

PANEL	FED FROM
1	22
2	23
3	24
4	25
5	26
6	27
7	28
8	29
9	30
10	31
11	32
12	33
13	34
14	35
15	36

VERTICAL NUMBERING

REMOVED FROM BKR

REMOVED FROM BKR

Picture 8: G05 Largo Town Center – Panel WMES Section 1 in Room 117




Picture 9: G05 Largo Town Center – Panel WMES Section 1 in Room 117 – Breaker 1




Picture 10: G05 Largo Town Center – Panel WMES Section 1 in Room 117 – Panel schedule

WMES (SECTION 1)			
480/277V 1200A MCB-WEST CONCOURSE ELECT RM			
XFMR T-3 (PNL WMESS1)	1	2	EUH-2
	3	4	
	5	6	
ESC #1 PWR	7	8	V #3 MAIN PWR
	9	10	
	11	12	
ESC #3 PWR	13	14	ESC #2 PWR
	15	16	
	17	18	
SPACE	19	20	CU-1
	21	22	
	23	24	
EUH-9 ELEV #3 MACH. RM	25	26	XFMR T-2 (PNL WMESS)
	27	28	
	29	30	
SPARE	31	32	EUH-8
	33	34	SPACE
	35	36	SPACE
SPACE	37	38	SPACE
	39	40	SPACE
	41	42	SPACE

TRULAND  **Walker Seal**

49 7

Picture 11: G05 Largo Town Center – Emergency Panel WMEE in Room 117

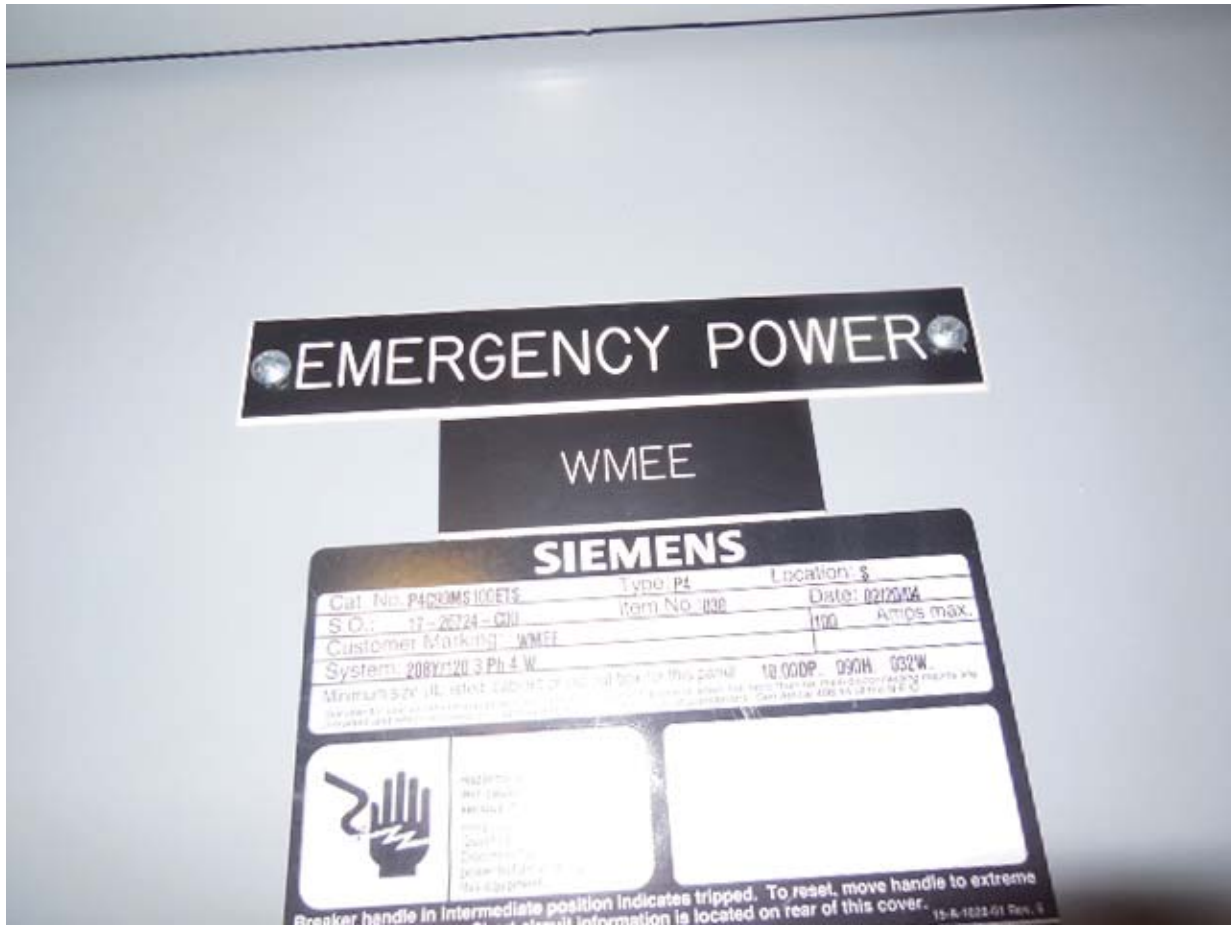

Picture 12: G05 Largo Town Center – Emergency Panel WMEE in Room 117 – Panel schedule

WMEE			
120 / 208V 100A - WEST CONCOURSE ELECTRIC RM			
	1	2	ESC #1 EM PNL
PANEL KE	3	4	ESC #1 EM PNL
	5	6	ESC #1 EM PNL
SPARE	7	8	ESC #2 EM PNL
ESC #3 EM PNL	9	10	ESC #2 EM PNL
ESC #3 EM PNL	11	12	ESC #2 EM PNL
ESC #4 EM PNL	13	14	ELEV #1,2 EMER. DISC.
ESC #4 EM PNL	15	16	ELEV #1,2 EMER. DISC.
SPARE	17	18	ELEV #1,2 EMER. DISC.
SPARE	19	20	PIDS L190 CONCOURSE
SPARE	21	22	PIDS L290 IB PLATFORM
SPARE	23	24	PIDS L291 OB PLATFORM
SPARE	25	26	SPARE
SPARE	27	28	SPARE
SPARE	29	30	SPARE
SPARE	31	32	SPARE
SPARE	33	34	SPARE
SPARE	35	36	SPARE
SPARE	37	38	SPARE
SPARE	39	40	SPARE
SPARE	41	42	SPARE

TRULAND



Walker Seal

Pre-Inspection Field
Verification 11/06/2014

EXISTING PANEL "WMES1" ✓											
AMPERES: 250		VOLTS: 120/208		MOUNTING: SURFACE							
MAINS: 250A MCB		PHASE: 3		LOCATION: FIRE EQUIP. CABINET & SERVICE RM 101 ✓							
RATING: 10K AIC		WIRE: 4		SECTION: 1 OF 1							
LOAD DESCRIPTION	KVA	AMP	POLE	NO	CTK.	NO	CTK.	POLE	AMP	KVA	LOAD DESCRIPTION
EXISTING VENDOR	0.8	20	1	1	A - -	2	1	20	0.8		EXISTING VENDOR
SPARE	0.0	20	1	3	- B -	4	1	20	0.8		NEW KIOSK RECEPT. (IT & NEPP)
EXISTING VENDOR	0.8	20	1	5	- - C	6	1	20	0.8		SPARE (KIOSK)
SPARE	0.0	20	1	7	A - -	8	1	20	0.0		SPARE
SPARE	0.0	20	1	9	- B -	10	1	20	0.0		SPARE
SPARE	0.0	20	1	11	- - C	12	1	20	0.0		SPARE
SPARE	0.0	20	1	13	A - -	14	1	20	0.8		EXISTING VENDOR
EXISTING VENDOR	0.8	20	1	15	- B -	16	1	20	0.8		EXISTING VENDOR
EXISTING VENDOR	0.8	20	1	17	- - C	18	1	20	0.8		EXISTING VENDOR
EXISTING VENDOR	0.8	20	1	19	A - -	20	1	20	0.8		EXISTING VENDOR
EXISTING VENDOR	0.8	20	1	21	- B -	22	1	20	0.8		EXISTING VENDOR
EXISTING VENDOR	0.8	20	1	23	- - C	24	1	20	0.8		EXISTING VENDOR
EXISTING VENDOR	0.8	20	1	25	A - -	26	1	20	0.8		EXISTING VENDOR
EXISTING VENDOR	0.8	20	1	27	- B -	28	1	20	0.8		EXISTING VENDOR
SPARE	0.0	20	1	29	- - C	30	1	20	0.8		EXISTING VENDOR
EXISTING VENDOR	0.8	20	1	31	A - -	32	1	20	0.8		EXISTING VENDOR
EXISTING VENDOR	0.8	20	1	33	- B -	34	1	20	0.8		EXISTING VENDOR
EXISTING VENDOR	0.8	20	1	35	- - C	36	1	20	0.8		EXISTING VENDOR
EXISTING VENDOR	0.8	20	1	37	A - -	38	3	40	2.9		EXIST. LOAD CENTER "KES"
EXISTING VENDOR	0.8	20	1	39	- B -	40	-	-	2.5		
SPARE	0.0	20	1	41	- - C	42	-	-	2.5		

NOTES 1. CONNECT NEW FEEDER TO EXISTING SPARE 20A, 1P CB
2. CB TO BE RESERVED FOR FUTURE AFC

LOAD SUMMARY

LIGHTS	0.0 x 125%	0.0 KVA
RECEPTACLES, FIRST 10 KVA	10.0 x 100%	10.0 KVA
RECEPTACLES	12.8 x 50%	6.4 KVA
MISC. APPLIANCES	0.0 x 100%	0.0 KVA
LARGEST MOTOR	0.0 x 125%	0.0 KVA
MOTORS	0.0 x 100%	0.0 KVA
HEAT	0.0 x 125%	0.0 KVA
AC	4.5 x 100%	4.5 KVA
WATER HEATING	3.0 x 125%	3.8 KVA
TOTAL CONNECTED LOAD	30.3 KVA	TOTAL DEMAND KVA 24.7 KVA
		TOTAL DEMAND AMPS 68.5 AMPS
CONNECTED LOAD PHASE SUMMARY		
PHASE A:	10.9 KVA	
PHASE B:	10.5 KVA	
PHASE C:	8.9 KVA	

NOTES: A. EXISTING PANEL "WMES1" IS FED FROM 277/480V, 3ø, 4W EXISTING PANEL "WMES" LOCATED IN ELECTRICAL ROOM 117, CIRCUIT 1,3,5-125/3P, VA 75KVA TRANSFORMER (SEE ATTACHED MM-G-E21).

- B. EXISTING WIRING FED FROM TOP OF PANEL BY:
 * 1-4" C. TO TRANSFORMER (WIRING FILL >40%).
 * 4- 1" C. (WIRING FILL >40%).
 EXISTING WIRING FED FROM BOTTOM OF PANEL BY:
 * 2- 6 1/2" x 1 1/2" FLOOR DUCT (1-WIRING FILL >40% & 1-EMPTY).

CONTRACT NO.
14-FQ10060-CENI-24

DESIGNED C. MEO	DATE 08-14	REFERENCE DRAWINGS		REVISIONS	
		NUMBER	DESCRIPTION	DATE	BY
DRAWN C. MEO	DATE 08-14				
CHECKED B. GUB	DATE 08-14				
APPROVED M/A	DATE				

WASHINGTON METROPOLITAN AREA TRANSIT AUTHORITY
 DEPARTMENT OF TRANSIT INFRASTRUCTURE
 AND ENGINEERING SERVICES
 OFFICE OF INFRASTRUCTURE RENEWAL PROGRAM



A Generali FlemingParsons
JOINT VENTURE

APPROVED _____ SUBMITTED _____
PROJECT MANAGER

NEW ELECTRONIC PAY PROGRAM (NEPP)
 IN METRO RAIL STATIONS
 LARGO TOWN CENTER
 PANEL SCHEDULE

SCALE
NOT TO SCALE

DRAWING NO.
G05-E-102

Pre-Inspection Mezzanine Walkthrough Checklist


Date: 10/09/2014		Station Name: J02 Van Dorn Street		Mezzanine #: 094		Completed By: Tino Sahoo	
Check	Task	Equipment	Room ID	Notes			
<input checked="" type="checkbox"/>	Verify that electrical power design matches the field/record. Identify locations of the electrical equipment.	Electrical Source Panel Name/Number: Existing SWBD "1" Source Breaker Name/Number: Panel "NF" (Breaker #4) Electrical AFC Panel Name/Number: Panel NF	110 110 110				
<input checked="" type="checkbox"/>	Verify if disconnect switch is connected to the AFC electrical power panel. Low or High voltage SMNT/POWR escorts requirements?	Disconnect Name/Number: N/A SMNT/POWR escorts: HIGH and LOW Voltage					
<input checked="" type="checkbox"/>	Check if there is a shared raceway between AFC Panel and Kiosk and identify additional source panels to be de-energized.	Do AFC Panel loads feed into a shared raceway e.g. trench or trough? If Yes, specify source panels in notes. NO					
<input checked="" type="checkbox"/>	Identify the assumed pathway of duct / conduit, the location of the handholes, manholes and boxes and accessibility or special escort requirement?	PLNT <input checked="" type="checkbox"/> COMM / IT <input type="checkbox"/> ELES <input type="checkbox"/> RAIL <input type="checkbox"/> CMNT <input type="checkbox"/> Other Access/Support:					
<input checked="" type="checkbox"/>	Identify handhole or manhole access requirement.	Required PLNT Mason for handhole/manhole access? YES (see notes) Identified Conduit/Duct Transition to mezzanine level? YES		All conduits are on one level			
Emergency Power Verification							
Check	Task	Equipment	Room ID	Notes			
<input checked="" type="checkbox"/>	Verify if AFC electrical panel is connected to an Automatic Transfer Switch (ATS).	ATS Name/Number:					
<input checked="" type="checkbox"/>	Verification of Kiosk Emergency Panel(s) (KE, KES, KESS, etc)	Source Panel Name/Number: NEE Section 2 Source Breaker Name/Number: Breaker #9 Panel Name/Number: Kiosk Emergency Panel	110 110 Kiosk				
Notes and Discrepancies: Panel KE (Breaker #4) in Kiosk will de-energize emergency power to faregates.							
Sign Off	GFP Representative	WMATA PRGM					
Name:	Tino Sahoo						
Signature:							
Date:	10/09/2014						

Photo #1: J02 Van Dorn Street – Kiosk to Mezzanine Level Handhole

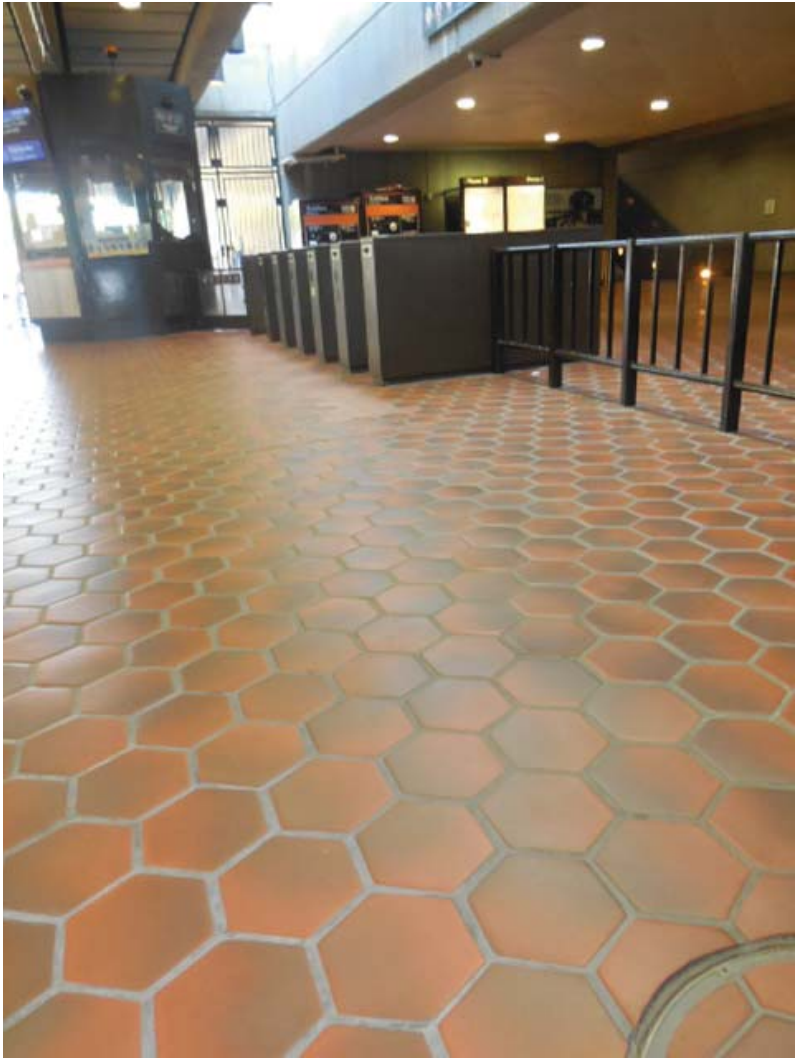


Photo #2: J02 Van Dorn Street – Mezzanine Level Handhole



Photo #3: J02 Van Dorn Street – Ducts feeding into bottom of AFC panel NF in Room 110



Photo #4: J02 Van Dorn Street – Bottom of AFC panel NF in Room 110



Photo #5: J02 Van Dorn Street – AFC panel NF in Room 110



Photo #6: J02 Van Dorn Street – Label of AFC panel NF in Room 110



Photo #7: J02 Van Dorn Street – Source breaker for AFC panel NF in Room 110



Photo #8: J02 Van Dorn Street – Label for Kiosk Emergency feed Source Panel NEE in Room 110



Photo #9: J02 Van Dorn Street – Label for Kiosk Emergency feed Source Breaker “Kiosk” in Room 110




Pre-inspection Field Verification 10/9/2014

NOTES:

- FOR VENDOR AND ADDFARE INSTALLATION SEE 931-4002.
- FOR SHADS INSTALLATION SEE 931-4001.
- FOR ENTRY, EXIT AND REVERSIBLE GATE INSTALLATION SEE 931-4003.
- FOR BI-DIRECTIONAL SERVICE GATE INSTALLATION SEE 931-4005.
- FOR A TYPICAL MEZZANINE INSTALLATION SEE 931-4000.
- CIRCUIT BREAKERS WITH COMMON NEUTRAL:
1, 3 & 5; 7, 9 & 11; 22 & 24; 15, 16 & 18; 10, 12 & 14.

ITEM	NAME	S/N	PANEL AFC	TYPE BREAKER
1	VENDOR	FUTURE	NF	1
2	VENDOR	FUTURE	NF	3
3	VENDOR	1655	NF	5
4	VENDOR	1815	NF	7
5	VENDOR	1831	NF	9
6	VENDOR	1897	NF	11
7	ADDFARE	2806	NF	22
8	ADDFARE	2825	NF	24
9	ENTRY GATE	3821	NF	8
10	REV. GATE	7868	NF	10
11	REV. GATE	7872	NF	12
12	REV. GATE	7874	NF	14
13	REV. GATE	7882	NF	16
14	REV. GATE	7885	NF	18
15	EXIT GATE	4818	NF	N/A
16	SHADS	8815	KE	1
17	S. CLOCK	98984	KES	8
18	EMERGENCY LT		KE	4

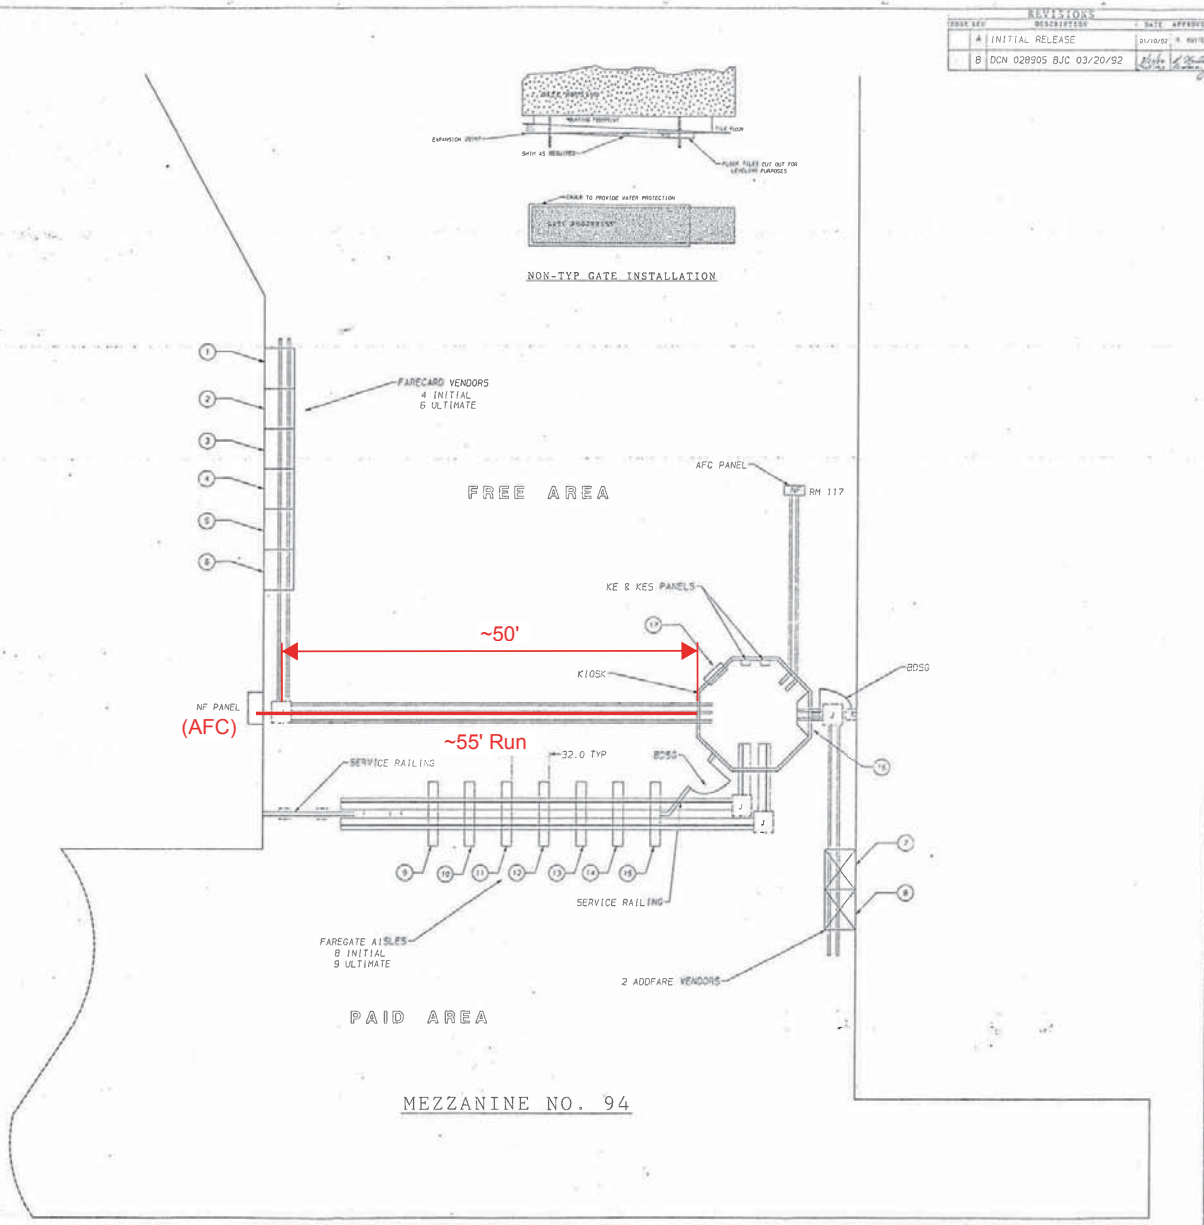

CODE	REV	DESCRIPTION	DATE	APPROVED
A		INITIAL RELEASE		
B		DCN 028905 BJC 03/20/92		

SEE SEPARATE PL WHEN ITEM NUMBERS ARE USED OR USE DESIGNATION MAY BE USED IN LIEU OF ITEM NUMBERS	UNLESS OTHERWISE SPECIFIED ALL DIMENSIONS ARE IN FEET AND INCHES UNLESS OTHERWISE SPECIFIED DIMENSIONS ARE TO CENTERLINE	UNLESS OTHERWISE SPECIFIED ALL DIMENSIONS ARE IN FEET AND INCHES UNLESS OTHERWISE SPECIFIED DIMENSIONS ARE TO CENTERLINE	<table border="1"> <tr><td>DATE</td><td>10/9/14</td></tr> <tr><td>PROJECT</td><td>VAN DORN STATION MEZZANINE LAYOUT</td></tr> <tr><td>SCALE</td><td>AS SHOWN</td></tr> <tr><td>PROJECT NO.</td><td>931-4017</td></tr> </table>	DATE	10/9/14	PROJECT	VAN DORN STATION MEZZANINE LAYOUT	SCALE	AS SHOWN	PROJECT NO.	931-4017																								
DATE	10/9/14																																		
PROJECT	VAN DORN STATION MEZZANINE LAYOUT																																		
SCALE	AS SHOWN																																		
PROJECT NO.	931-4017																																		
<table border="1"> <tr><td>DATE</td><td>10/9/14</td></tr> <tr><td>PROJECT</td><td>VAN DORN STATION MEZZANINE LAYOUT</td></tr> <tr><td>SCALE</td><td>AS SHOWN</td></tr> <tr><td>PROJECT NO.</td><td>931-4017</td></tr> </table>	DATE	10/9/14	PROJECT	VAN DORN STATION MEZZANINE LAYOUT	SCALE	AS SHOWN	PROJECT NO.	931-4017	<table border="1"> <tr><td>DATE</td><td>10/9/14</td></tr> <tr><td>PROJECT</td><td>VAN DORN STATION MEZZANINE LAYOUT</td></tr> <tr><td>SCALE</td><td>AS SHOWN</td></tr> <tr><td>PROJECT NO.</td><td>931-4017</td></tr> </table>	DATE	10/9/14	PROJECT	VAN DORN STATION MEZZANINE LAYOUT	SCALE	AS SHOWN	PROJECT NO.	931-4017	<table border="1"> <tr><td>DATE</td><td>10/9/14</td></tr> <tr><td>PROJECT</td><td>VAN DORN STATION MEZZANINE LAYOUT</td></tr> <tr><td>SCALE</td><td>AS SHOWN</td></tr> <tr><td>PROJECT NO.</td><td>931-4017</td></tr> </table>	DATE	10/9/14	PROJECT	VAN DORN STATION MEZZANINE LAYOUT	SCALE	AS SHOWN	PROJECT NO.	931-4017	<table border="1"> <tr><td>DATE</td><td>10/9/14</td></tr> <tr><td>PROJECT</td><td>VAN DORN STATION MEZZANINE LAYOUT</td></tr> <tr><td>SCALE</td><td>AS SHOWN</td></tr> <tr><td>PROJECT NO.</td><td>931-4017</td></tr> </table>	DATE	10/9/14	PROJECT	VAN DORN STATION MEZZANINE LAYOUT	SCALE	AS SHOWN	PROJECT NO.	931-4017
DATE	10/9/14																																		
PROJECT	VAN DORN STATION MEZZANINE LAYOUT																																		
SCALE	AS SHOWN																																		
PROJECT NO.	931-4017																																		
DATE	10/9/14																																		
PROJECT	VAN DORN STATION MEZZANINE LAYOUT																																		
SCALE	AS SHOWN																																		
PROJECT NO.	931-4017																																		
DATE	10/9/14																																		
PROJECT	VAN DORN STATION MEZZANINE LAYOUT																																		
SCALE	AS SHOWN																																		
PROJECT NO.	931-4017																																		
DATE	10/9/14																																		
PROJECT	VAN DORN STATION MEZZANINE LAYOUT																																		
SCALE	AS SHOWN																																		
PROJECT NO.	931-4017																																		

Pre-inspection Field
Verification 10/9/2014

EXISTING PANEL "NF" ✓										
AMPERES: 225			VOLTS: 120/208			MOUNTING: SURFACE				
MANS: 200A MCB			PHASE: 3			LOCATION: AC SWBD ROOM 110 ✓				
RATINGS: 10K AIC			WIRE: 4			SECTION: 1 OF 1				
LOAD DESCRIPTION	KVA	AMP	POLE	CKT. NO.	CKT. NO.	POLE	AMP	KVA	LOAD DESCRIPTION	
SPARE	0.0	20	1	1 A	2	3	30	2.9	EXIST. LOAD CENTER "KES"	
EXISTING VENDOR	0.8	20	1	3 - B	4	-	-	2.5		
EXISTING VENDOR	0.8	20	1	5 - C	6	-	-	2.5		
EXISTING VENDOR	0.8	20	1	7 A	8	1	20	0.8	EXISTING VENDOR	
EXISTING VENDOR	0.8	20	1	9 - B	10	1	20	0.8	EXISTING VENDOR	
EXISTING VENDOR	0.8	20	1	11 - C	12	1	20	0.8	EXISTING VENDOR	
EXISTING VENDOR	0.8	20	1	13 A	14	1	20	0.8	EXISTING VENDOR	
EXISTING VENDOR	0.8	20	1	15 - B	16	1	20	0.8	EXISTING VENDOR	
✓ 1 NEW KIOSK RECEPT. (IT & NEPP)	0.8	20	1	17 - C	18	1	20	0.8	EXISTING VENDOR	
✓ 1.2 SPARE (KIOSK)	0.0	20	1	19 A	20	1	20	0.8	EXISTING VENDOR	
SPARE	0.0	20	1	21 - B	22	1	20	0.8	EXISTING VENDOR	
SPARE	0.0	20	1	23 - C	24	1	20	0.8	EXISTING VENDOR	
SPARE	0.0	20	1	25 A	26	1	20	0.0	SPARE	
EXISTING VENDOR	0.8	20	1	27 - B	28	1	20	0.0	SPARE	
EXISTING VENDOR	0.8	20	1	29 - C	30	1	20	0.0	SPARE	
SPARE	0.0	20	1	31 A	32	1	20	0.0	SPARE	
EXISTING VENDOR	0.8	20	1	33 - B	34	1	20	0.0	SPARE	
SPARE	0.0	20	1	35 - C	36	1	20	0.0	SPARE	
SPARE	0.0	20	1	37 A	38	1	20	0.0	SPARE	
SPARE	0.0	20	1	39 - B	40	1	20	0.0	SPARE	
SPARE	0.0	20	1	41 - C	42	1	20	0.0	SPARE	

NOTES: 1. CONNECT NEW FEEDER TO EXISTING SPARE 20A, 1P CB
2. CB TO BE RESERVED FOR FUTURE AFC

LOAD SUMMARY


LIGHTS	0.0 x 125%	0.0 KVA
RECEPTACLES, FIRST 10 KVA	10.0 x 100%	10.0 KVA
RECEPTACLES	6.4 x 50%	3.2 KVA
MISC APPLIANCES	0.0 x 100%	0.0 KVA
LARGEST MOTOR	0.0 x 125%	0.0 KVA
MOTORS	0.0 x 100%	0.0 KVA
HEAT	3.0 x 125%	3.8 KVA
AC	4.5 x 100%	4.5 KVA
WATER HEATING	0.0 x 125%	0.0 KVA
TOTAL CONNECTED LOAD	23.9 KVA	TOTAL DEMAND KVA 21.5 KVA
		TOTAL DEMAND AMPS 99.6 AMPS
CONNECTED LOAD PHASE SUMMARY		
PHASE A:	6.9 KVA	
PHASE B:	8.9 KVA	
PHASE C:	8.1 KVA	

Breaker "Panel NF"
(Breaker #4) - 100/3P

- NOTES: A. EXISTING PANEL "NF" IS FED FROM 277/480V, 3ø, 4W EXISTING SWBD "1" LOCATED IN AC SWBD ROOM 110. -CIRCUIT #4-100/3P-4A-75KVA TRANSFORMER (SEE ATTACHED DWG. MM-J&H-ED6).
- B. EXISTING WIRING FED FROM BOTTOM PANEL BY:
 * 2-5 1/2" x 1 1/2" FLOOR DUCTS (1-EMPTY FLOOR DUCT & 1-WIRING FILL >40%).
 * 2-1/2" C. (1-WIRING FILL >40% & 1-EMPTY CONDUIT).
- EXISTING WIRING FED FROM TOP PANEL BY:
 * 6-1/2" C. (3-WIRING FILL >40% & 3-EMPTY CONDUIT)
- EXISTING WIRING FED FROM RIGHT SIDE PANEL BY:
 * 1-3" C. TO TRANSFORMER (WIRING FILL >40%).
 * 1-1/2" C. (WIRING FILL >40%).

CONTRACT NO
14-FQ10060-CENI-24

DESIGNED S. MOO 08-11 DATE	REFERENCE DRAWINGS	REVISIONS	WASHINGTON METROPOLITAN AREA TRANSIT AUTHORITY		NEW ELECTRONIC PAY PROGRAM (NEPP) IN METRORAIL STATIONS	
DRAWN S. MOO 08-11 DATE	NUMBER DESCRIPTION	DATE BY DESCRIPTION	DEPARTMENT OF TRANSIT INFRASTRUCTURE AND ENGINEERING SERVICES		VAN DORN STREET PANEL SCHEDULE	
CHECKED S. MOO 08-11 DATE			OFFICE OF INFRASTRUCTURE RENEWAL PROGRAM		SCALE NOT TO SCALE	
APPROVED N/A DATE			APPROVED _____	SUBMITTED _____ PROJECT MANAGER	DRAWING NO J02-E-102	

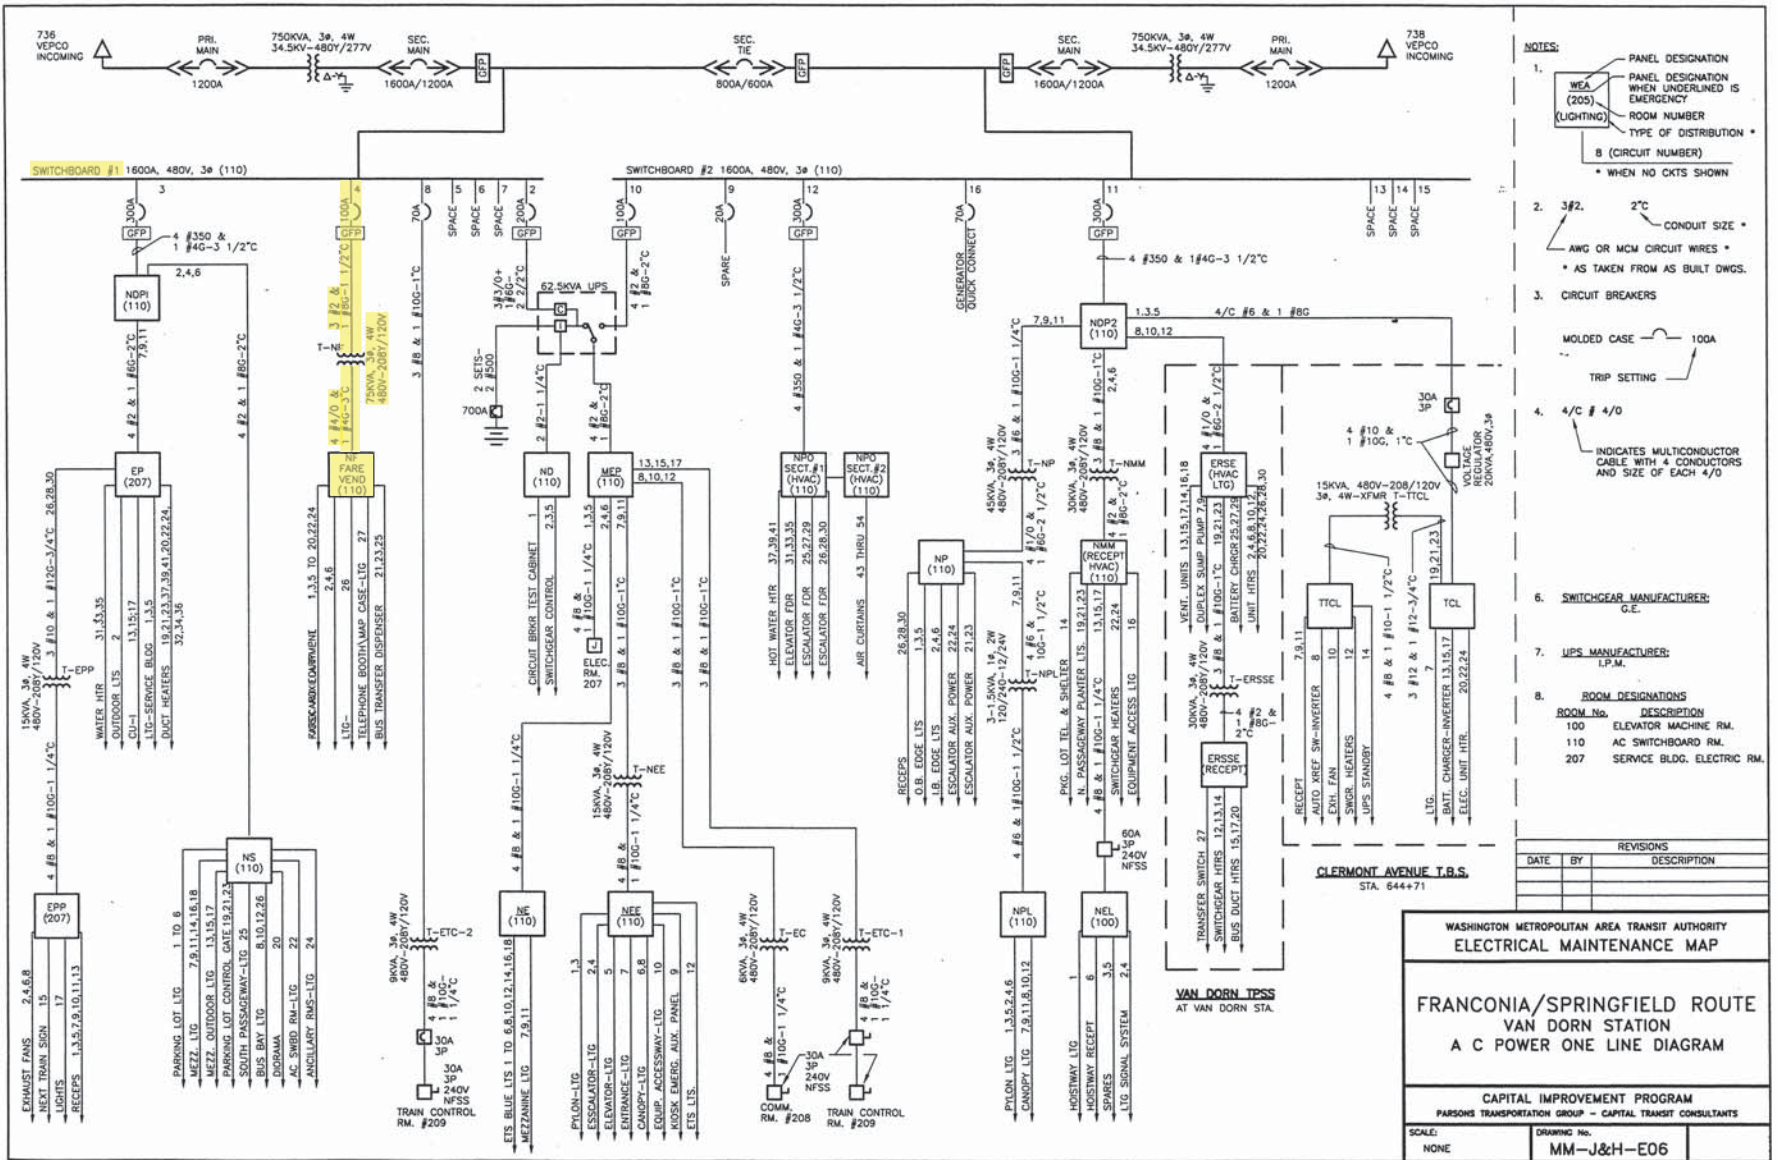

Pre-inspection Field Verification 10/9/2014

- NOTES:
- PANEL DESIGNATION
 - PANEL DESIGNATION WHEN UNDERLINED IS EMERGENCY (LIGHTING)
 - ROOM NUMBER
 - TYPE OF DISTRIBUTION
 - 8 (CIRCUIT NUMBER)
 - * WHEN NO CKTS SHOWN

- 3/2, 2°C CONDUIT SIZE *
 - AWG OR MCM CIRCUIT WIRES *
 - * AS TAKEN FROM AS BUILT DWGS.

- CIRCUIT BREAKERS

- MOLDED CASE 100A
 - TRIP SETTING
 - 4/C # 4/0
 - INDICATES MULTICONDUCTOR CABLE WITH 4 CONDUCTORS AND SIZE OF EACH 4/0

- SWITCHGEAR MANUFACTURER: G.E.
 - UPS MANUFACTURER: I.P.M.
 - ROOM DESIGNATIONS
- | ROOM No. | DESCRIPTION |
|----------|----------------------------|
| 100 | ELEVATOR MACHINE RM. |
| 110 | AC SWITCHBOARD RM. |
| 207 | SERVICE BLDG. ELECTRIC RM. |

REVISIONS		
DATE	BY	DESCRIPTION

WASHINGTON METROPOLITAN AREA TRANSIT AUTHORITY
ELECTRICAL MAINTENANCE MAP

FRANCONIA/SPRINGFIELD ROUTE
VAN DORN STATION
A C POWER ONE LINE DIAGRAM

CAPITAL IMPROVEMENT PROGRAM
PARSONS TRANSPORTATION GROUP - CAPITAL TRANSIT CONSULTANTS

SCALE: NONE DRAWING No. MM-J&H-E06

Pre-Inspection Mezzanine Walkthrough Checklist


Date: 10/09/2014		Station Name: J03 Franconia-Springfield		Mezzanine #: 095		Completed By: Tino Sahoo	
Check	Task	Equipment		Room ID	Notes		
<input checked="" type="checkbox"/>	Verify that electrical power design matches the field/record. Identify locations of the electrical equipment.	Electrical Source Panel Name/Number:	Existing SWB2 "2"	216			
		Source Breaker Name/Number:	"Panel FF (via T6)" (Breaker #6)	216			
		Electrical AFC Panel Name/Number:	Panel FF	216			
<input checked="" type="checkbox"/>	Verify if disconnect switch is connected to the AFC electrical power panel. Low or High voltage SMNT/POWR escorts requirements?	Disconnect Name/Number:	N/A				
		SMNT/POWR escorts:	HIGH and LOW Voltage				
<input checked="" type="checkbox"/>	Check if there is a shared raceway between AFC Panel and Kiosk and identify additional source panels to be de-energized.	Do AFC Panel loads feed into a shared raceway e.g. trench or trough? If Yes, specify source panels in notes.	NO				
<input checked="" type="checkbox"/>	Identify the assumed pathway of duct / conduit, the location of the handholes, manholes and boxes and accessibility or special escort requirement?	PLNT <input checked="" type="checkbox"/> COMM / IT <input type="checkbox"/> ELES <input type="checkbox"/> RAIL <input type="checkbox"/> CMNT <input type="checkbox"/>					
		Other Access/Support:					
<input checked="" type="checkbox"/>	Identify handhole or manhole access requirement.	Required PLNT Mason for handhole/manhole access?	YES (see notes)		All conduits and duct are on the same level		
		Identified Conduit/Duct Transition to mezzanine level?	YES				
Emergency Power Verification							
Check	Task	Equipment		Room ID	Notes		
<input checked="" type="checkbox"/>	Verify if AFC electrical panel is connected to an Automatic Transfer Switch (ATS).	ATS Name/Number:					
<input checked="" type="checkbox"/>	Verification of Kiosk Emergency Panel(s) (KE, KES, KESS, etc)	Source Panel Name/Number:	EE	216			
		Source Breaker Name/Number:	Breaker #7	216			
		Panel Name/Number:	KE	Kiosk			
Notes and Discrepancies: Panel KE (Breaker #12) in Kiosk de-energizes emergency power to faregates.							
Sign Off		GFP Representative			WMATA PRGM		
Name:		Tino Sahoo					
Signature:							
Date:		10/9/2014					

Photo #1: J03 Franconia-Springfield – Station Kiosk Area



Photo #2: J03 Franconia-Springfield – Handholes near station Kiosk



Photo #3: J03 Franconia-Springfield – Handholes near station Kiosk

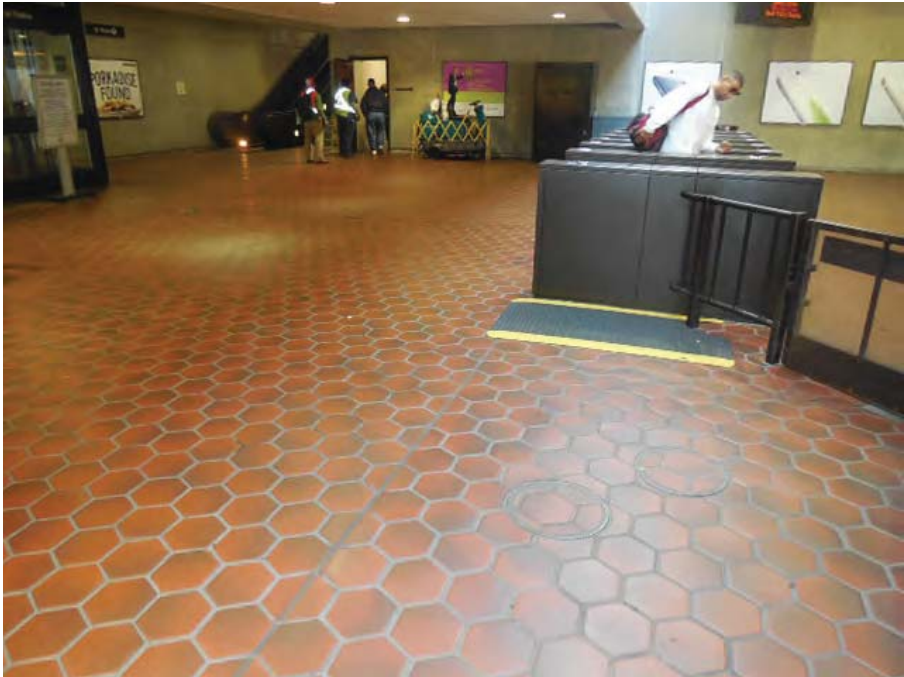


Photo #4: J03 Franconia-Springfield – Handholes in mezzanine floor



Photo #5: J03 Franconia-Springfield – Ducts feeding into trough in Room 216



Photo #6: J03 Franconia-Springfield – Bottom of AFC Panel FF feeding into trough in Room 216



Photo #7: J03 Franconia-Springfield – AFC Panel FF in Room 216

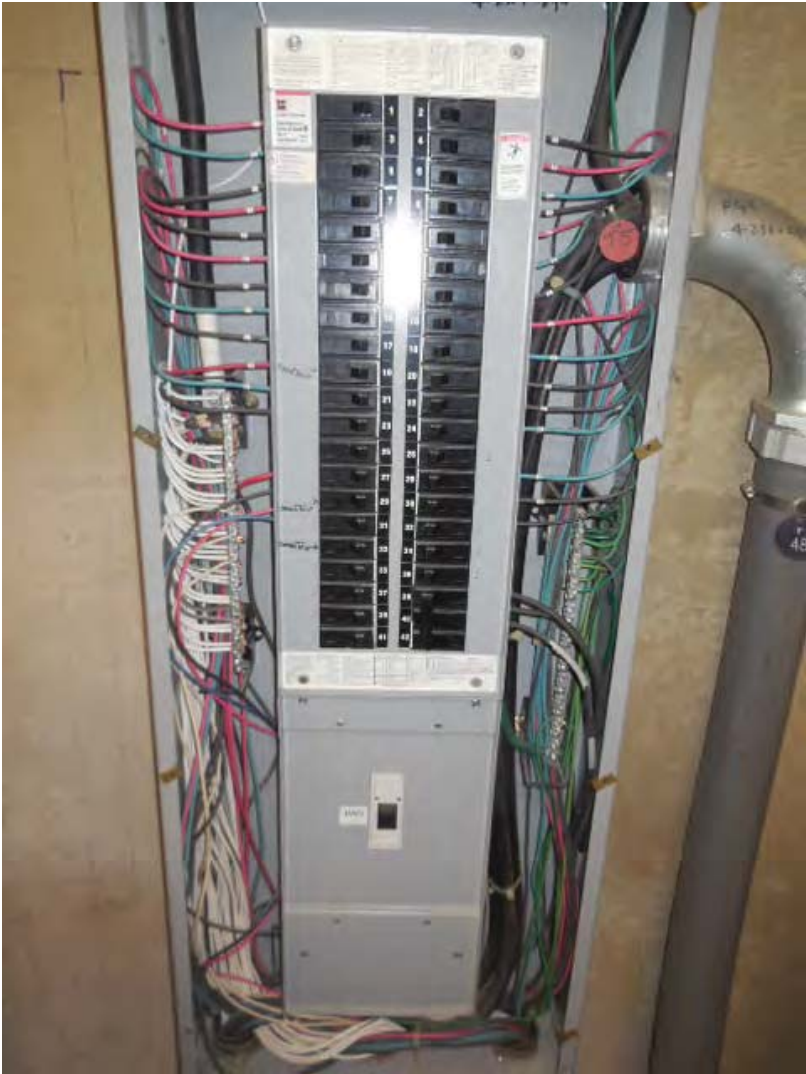


Photo #8: J03 Franconia-Springfield – Panel FF schedule

CIRCUIT DIRECTORY FOR FF	
1 FREE AREA VENDORS	FARE GATE CONSOLES #17
3 FREE AREA VENDORS #37	FARE GATE CONSOLES #11
5 FREE AREA VENDORS #36	FARE GATE CONSOLES #2
7 FREE AREA VENDORS #35	FARE GATE CONSOLES #3
9 FREE AREA VENDORS #34	10 FARE GATE CONSOLES #14
11 FREE AREA VENDORS #33	12 FARE GATE CONSOLES #15
13 FREE AREA VENDORS #32	14 FARE GATE CONSOLES #16
15 FREE AREA VENDORS #31	16 FARE GATE CONSOLES #17
17 FREE AREA VENDORS #30	18 FARE GATE CONSOLES #18
19 FREE AREA VENDORS #514M	20 FARE GATE CONSOLES #19
21 FREE AREA VENDORS #514M	22 FARE GATE CONSOLES #20
23 KIOSK LIGHTING Vendor #41	24 FARE GATE CONSOLES #21
25 BUS IN VEHICLE SAFETY	26 SPARE
27 TEL/MAP CASE LIGHTING	28 PAID AREA VENDORS #51
29 SPARE Smart Trip	30 PAID AREA VENDORS #50
31 SPARE	32 SPARE A111
33 SPARE Smart Trip	34 SPARE
36 SPARE	36 SPARE
37 SPARE	40 PANEL # (KIOSK) RE3
39 SPARE	(KIOSK AIR CONDITIONING
41 SPARE	HEATING & MISCELLANEOUS)

#21 Spare wire in Kiosk

Photo #9: J03 Franconia-Springfield – Switchboard #2 label in room 216



Photo #10: J03 Franconia-Springfield – AFC Panel circuit on Switchboard #2 in room 216



Photo #11: J03 Franconia-Springfield – Emergency feed for Kiosk Panel – Source Panel EE Label



Photo #12: J03 Franconia-Springfield – Emergency feed for Kiosk Panel – Circuit Switch for Panel KE



Pre-inspection Field Verification
10/9/2014

EXISTING PANEL "FF" ✓											
AMPERES: 225			VOLTS: 120/208			MOUNTING: SURFACE					
MAINS: 200AMCB			PHASE: 3			LOCATION: AC SWBD ROOM 216 ✓					
RATING: 10K AIC			WIRE: 4			SECTION: 1 OF 1					
LOAD DESCRIPTION	KVA	AMP	POLE	NO.	CKT. NO.	POLE	AMP	KVA	LOAD DESCRIPTION		
EXISTING VENDOR	0.8	20	1	1	A -	2	1	20	0.8	EXISTING VENDOR	
EXISTING VENDOR	0.8	20	1	3	- B -	4	1	20	0.8	EXISTING VENDOR	
EXISTING VENDOR	0.8	20	1	5	- - C	6	1	20	0.8	EXISTING VENDOR	
EXISTING VENDOR	0.8	20	1	7	A - -	8	1	20	0.8	EXISTING VENDOR	
EXISTING VENDOR	0.8	20	1	9	- B -	10	1	20	0.8	EXISTING VENDOR	
EXISTING VENDOR	0.8	20	1	11	- - C	12	1	20	0.8	EXISTING VENDOR	
EXISTING VENDOR	0.8	20	1	13	A - -	14	1	20	0.8	EXISTING VENDOR	
EXISTING VENDOR	0.8	20	1	15	- B -	16	1	20	0.8	EXISTING VENDOR	
EXISTING VENDOR	0.8	20	1	17	- - C	18	1	20	0.8	EXISTING VENDOR	
EXISTING VENDOR	0.8	20	1	19	A - -	20	1	20	0.8	EXISTING VENDOR	
EXISTING VENDOR	0.8	20	1	21	- B -	22	1	20	0.8	EXISTING VENDOR	
EXISTING VENDOR	0.8	20	1	23	- - C	24	1	20	0.8	EXISTING VENDOR	
SPARE	0.0	20	1	25	A - -	26	1	20	0.0	SPARE	
EXISTING VENDOR	0.8	20	1	27	- B -	28	1	20	0.8	EXISTING VENDOR	
EXISTING VENDOR	0.8	20	1	29	- - C	30	1	20	0.8	EXISTING VENDOR	
EXISTING VENDOR	0.8	20	1	31	A - -	32	1	20	0.8	EXISTING VENDOR	
EXISTING VENDOR	0.8	20	1	33	- B -	34	1	20	0.0	SPARE	
NEW KIOSK RECEPT. (IT & NEPP)	0.8	20	1	35	- - C	36	1	20	0.0	SPARE	
SPARE (KIOSK)	0.0	20	1	37	A - -	38	3	30	2.9	EXIST. LOAD CENTER "KES"	
SPARE	0.0	20	1	39	- B -	40	-	-	2.5		
SPARE	0.0	20	1	41	- - C	42	-	-	2.5		

NOTES: 1. CONNECT NEW FEEDER TO EXISTING SPARE 20A, 1P CB
2. CB TO BE RESERVED FOR FUTURE AFC

LOAD SUMMARY		
LIGHTS	0.0 x 125%	0.0 KVA
RECEPTACLES, FIRST 10 KVA	10.0 x 100%	10.0 KVA
RECEPTACLES	15.0 x 50%	8.0 KVA
MISC APPLIANCES	0.0 x 100%	0.0 KVA
LARGEST MOTOR	0.0 x 125%	0.0 KVA
MOTORS	0.0 x 100%	0.0 KVA
HEAT	3.0 x 125%	3.8 KVA
AC	4.5 x 100%	4.5 KVA
WATER HEATING	0.0 x 125%	0.0 KVA
TOTAL CONNECTED LOAD	33.5 KVA	TOTAL DEMAND KVA 26.3 KVA
		TOTAL DEMAND AMPS 72.9 AMPS

CONNECTED LOAD PHASE SUMMARY		
PHASE A	10.9 KVA	
PHASE B	11.3 KVA	
PHASE C	11.3 KVA	

✓ 1
✓ 1&2

Breaker "Panel FF (VIA T6)"
(Breaker #6) - 150/3P

NOTES: A. EXISTING PANEL "FF" IS FED FROM 277/480V, 3Ø, 4W EXISTING SWBD. "2" LOCATED IN AC SWBD ROOM 216, CIRCUIT #6-150/3P VIA 75 KVA TRANSFORMER (SEE ATTACHED DWG. MM-J&H-ED9).
B. EXISTING WIRING FED FROM BOTTOM PANEL BY:
* 3-2" C. (WIRING FILL >40%).
EXISTING WIRING FED FROM TOP PANEL BY:
* 1-1/2" C. (WIRING FILL >40%).
EXISTING WIRING FED FROM RIGHT SIDE PANEL BY:
* 1-3" C. TO TRANSFORMER (WIRING FILL >40%).

CONTRACT NO.
14-FQ10060-CENI-24

DESIGNED: C. MOO	DATE: 08-14	REFERENCE DRAWINGS		REVISIONS	
		NUMBER	DESCRIPTION	DATE	BY
DRAWN: C. MOO	DATE: 08-14				
CHECKED: A. KILM	DATE: 08-14				
APPROVED: M.A.	DATE:				


WASHINGTON METROPOLITAN AREA TRANSIT AUTHORITY
DEPARTMENT OF TRANSIT INFRASTRUCTURE AND ENGINEERING SERVICES
OFFICE OF INFRASTRUCTURE RENEWAL PROGRAM

GFP A BARNETT FLEMING PARTNERS JOINT VENTURE

APPROVED: _____ SUBMITTED: _____ PROJECT MANAGER

NEW ELECTRONIC PAY PROGRAM (NEPP)
IN METRO RAIL STATIONS
FRANCONIA - SPRINGFIELD
PANEL SCHEDULE

SCALE: NOT TO SCALE
DRAWING NO.: J03-E-102

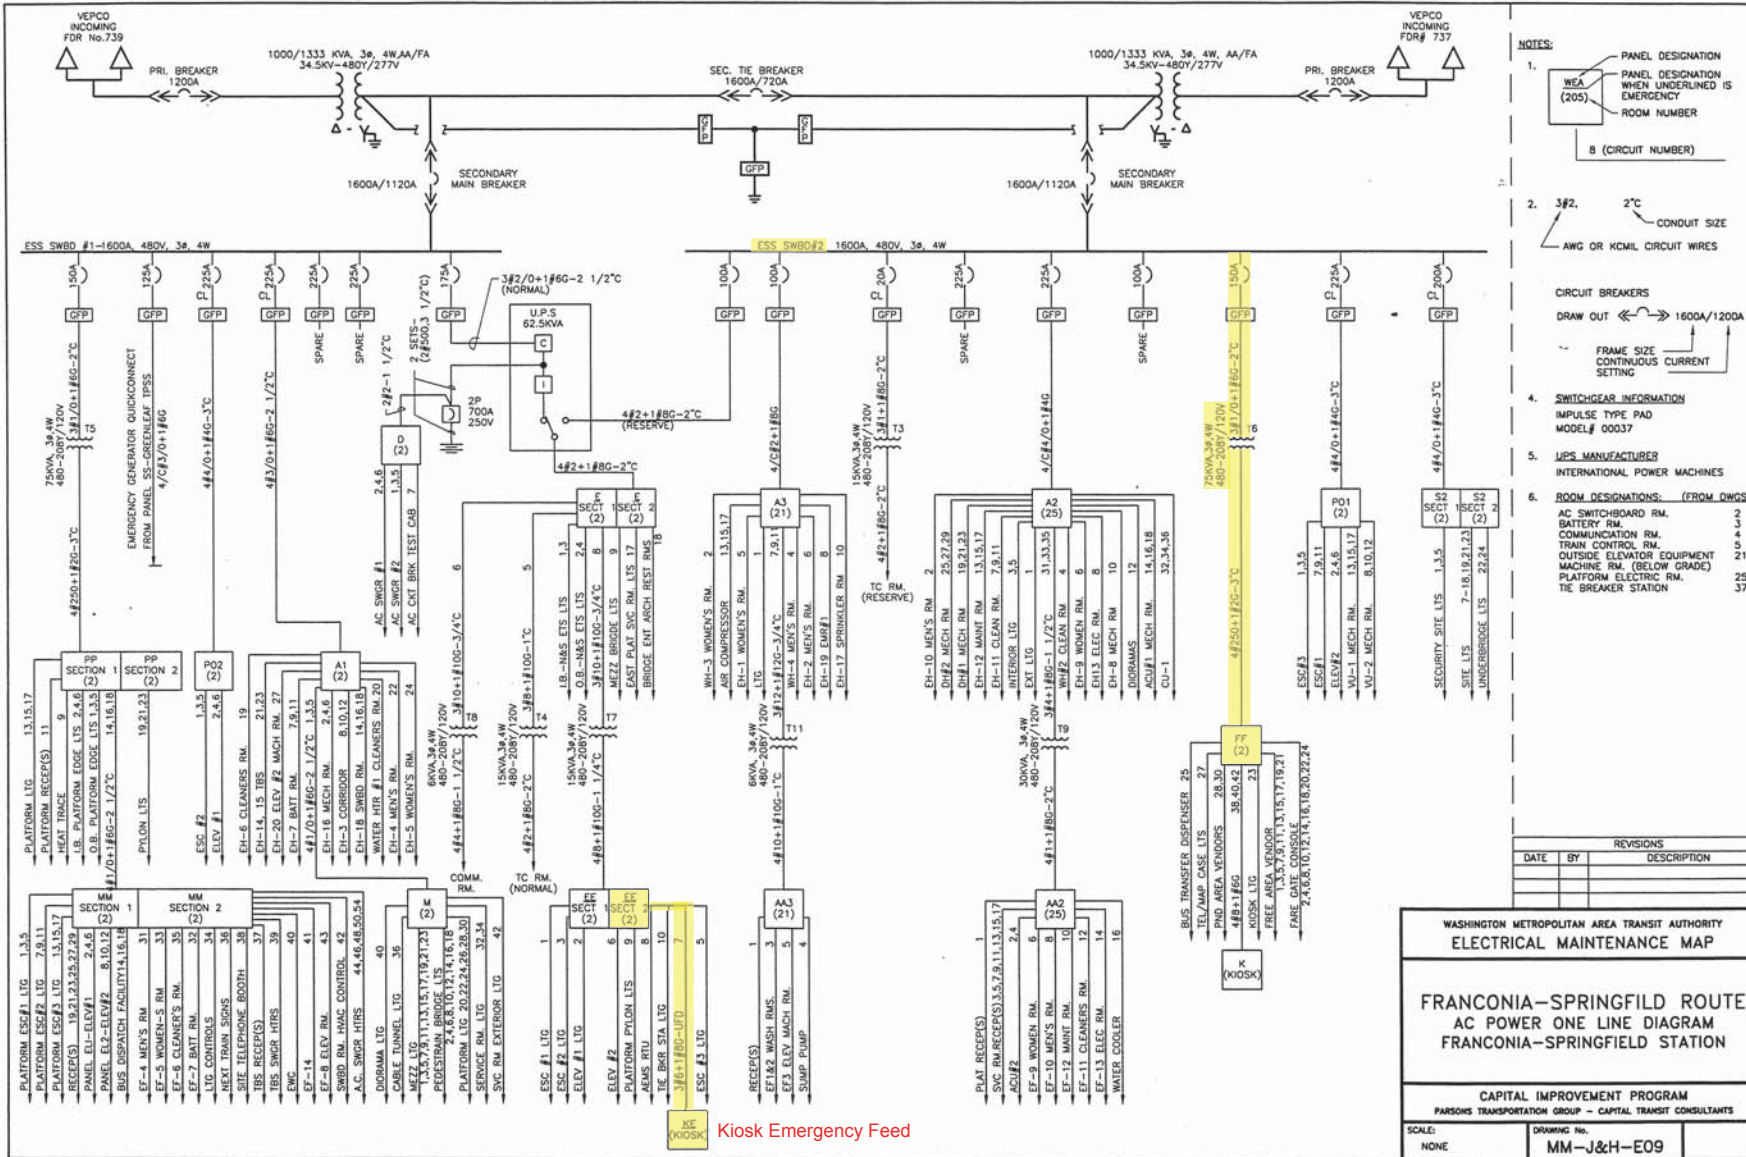

KE KIOSK Kiosk Emergency Feed

- NOTES:
- PANEL DESIGNATION
 - PANEL DESIGNATION WHEN UNDERLINED IS EMERGENCY
 - ROOM NUMBER

8 (CIRCUIT NUMBER)
 - 3#2, 2°C CONDUIT SIZE
 - AWG OR KCMIL CIRCUIT WIRES
 - CIRCUIT BREAKERS
 - DRAW OUT → 1600A/1200A
 - FRAME SIZE CONTINUOUS CURRENT SETTING
 - SWITCHGEAR INFORMATION
 - IMPULSE TYPE PAD MODEL# 00037
 - UPS MANUFACTURER
 - INTERNATIONAL POWER MACHINES
 - ROOM DESIGNATIONS: (FROM DWGS.)
 - AC SWITCHBOARD RM. 1,3,5
 - BATTERY RM. 2
 - COMMUNICATION RM. 3
 - TRAIN CONTROL RM. 4
 - OUTSIDE ELEVATOR EQUIPMENT MACHINE RM. (BELOW GRADE) 5
 - PLATFORM ELECTRIC RM. 6
 - TIE BREAKER STATION 7
 - SECURITY SITE LITS. 1,3,5
 - SITE LITS 7-18,19,21,23
 - UNDERGROUND LITS 22,24

REVISIONS		
DATE	BY	DESCRIPTION

WASHINGTON METROPOLITAN AREA TRANSIT AUTHORITY
ELECTRICAL MAINTENANCE MAP

FRANCONIA-SPRINGFIELD ROUTE
AC POWER ONE LINE DIAGRAM
FRANCONIA-SPRINGFIELD STATION

CAPITAL IMPROVEMENT PROGRAM
PARSONS TRANSPORTATION GROUP - CAPITAL TRANSIT CONSULTANTS

SCALE: NONE DRAWING NO: MM-J&H-E09

Pre-inspection Field Verification 10/9/2014

J03 Notes:
-Power conductor run - AFC Panel FF to Kiosk: ~175'
-Handhole ~100' away from Kiosk