



ELECTRICAL AND DATA CABLE INSTALLATION

for

Washington Metropolitan Area Transit Authority

Contract Number FQ17021

VOLUME 4

**Pre-Inspection Reports
Part 2b
Green and Yellow Lines**

November 13, 2016

Final Submission

WASHINGTON METROPOLITAN AREA TRANSIT AUTHORITY

**VOLUME 4
PRE-INSPECTION REPORTS
PART 2B
GREEN & YELLOW LINES
TABLE OF CONTENTS**

PAGE NO.

| | | |
|----|--|-----|
| 1 | MIR_C09_CRYSTAL CITY_MZ045 | 3 |
| 2 | MIR_C10_REAGAN NATIONAL AIRPORT (SOUTH MEZZ)_MZ046 | 12 |
| 3 | MIR_C10_REAGAN NATIONAL AIRPORT (NORTH MEZZ)_MZ093 | 19 |
| 4 | MIR_C10_REAGAN NATIONAL AIRPORT (MINI MEZZ)_MZ093M | |
| 5 | MIR_C12_BRADDOCK ROAD_MZ047 | 37 |
| 6 | MIR_C13_KING STREET-OLD TOWN_MZ048 | 47 |
| 7 | MIR_C13_KING STREET-OLD TOWN (NEW ENTRANCE)_MZ048M | |
| 8 | MIR_C13_KING STREET-OLD TOWN (NORTH MEZZ)_MZ112 | 64 |
| 9 | MIR_C15_HUNTINGTON (NORTH MEZZANINE)_MZ050 | 77 |
| 10 | MIR_C15_HUNTINGTON (SOUTH MEZZANINE)_MZ051 | 89 |
| 11 | MIR_E01_MOUNT VERNON SQUARE_MZ070 | 95 |
| 12 | MIR_E02_SHAW-HOWARD U (SOUTH MEZZANINE)_MZ071 | 107 |
| 13 | MIR_E02_SHAW-HOWARD U (NORTH MEZZANINE)_MZ072 | 122 |
| 14 | MIR_E03_U STREET (EAST MEZZANINE)_MZ073 | 132 |
| 15 | MIR_E03_U STREET (WEST MEZZANINE)_MZ074 | 146 |
| 16 | MIR_E05_GEORGIA AVENUE_MZ076 | 163 |
| 17 | MIR_E07_WEST HYATTSVILLE_MZ077 | 175 |
| 18 | MIR_E08_PRINCE GEORGE'S PLAZA_MZ078 | 186 |
| 19 | MIR_E09_COLLEGE PARK_MZ079 | 196 |
| 20 | MIR_E10_GREENBELT_MZ080 | 207 |
| 21 | MIR_F02_ARCHIVES_MZ081 | 217 |
| 22 | MIR_F03_L'ENFANT PLAZA (NORTH MEZZANINE)_MZ082 | 228 |
| 23 | MIR_F04_WATERFRONT_MZ083 | 248 |
| 24 | MIR_F05_NAVY YARD-BALLPARK (WEST MEZZANINE)_MZ105 | 268 |
| 25 | MIR_F06_ANACOSTIA (NORTH MEZZANINE)_MZ085 | 278 |
| 26 | MIR_F06_ANACOSTIA (SOUTH MEZZANINE)_MZ106 | 292 |
| 27 | MIR_F07_CONGRESS HEIGHTS_MZ086 | 310 |
| 28 | MIR_F08_SOUTHERN AVENUE_MZ107 | 323 |
| 29 | MIR_F09_NAYLOR ROAD_MZ087 | 332 |
| 30 | MIR_F11_BRANCH AVENUE_MZ089 | 344 |

Pre-Inspection Mezzanine Walkthrough Checklist

| | | | |
|-------------------------|---------------------------------------|------------------------|---------------------------------|
| Date: 10/09/2014 | Station Name: C09 Crystal City | Mezzanine # 045 | Completed By: Tino Sahoo |
|-------------------------|---------------------------------------|------------------------|---------------------------------|

| Check | Task | Equipment | Room ID | Notes |
|-------------------------------------|--|---|------------------------------|---|
| <input checked="" type="checkbox"/> | Verify electrical power design matches the field/record. Identify locations of the electrical equipment. | Electrical Source Panel Name/Number: M Source Breaker Name/Number: Circuit #17 Electrical AFC Panel Name/Number: Panel 2MM | C302 C302 C302 | S.O. Request: SOURCE PANELS: SWBD FB4 (AFC Source); SWBD FB1 and SWBD FB2 (Common Trough Source SWBDS.) Breakers: + |
| <input checked="" type="checkbox"/> | Is there a disconnect switch connected to the AFC electrical power panel? Low or High voltage SMNT/POWR escorts required? | Disconnect Name/Number: N/A SMNT/POWR escorts: HIGH Voltage | | Panel M (Circuit #8) on SWBD FB4 (West Side); Panel 1MPO (Circuit #3) on SWBD FB1 (East Side); Panel 2MPO (Circuit #1) on SWBD FB1 (East Side); Panel 4MPO (Circuit #7) on SWBD FB2 (East Side) |
| <input checked="" type="checkbox"/> | Check if there is a shared raceway between AFC Panel and Kiosk and identify additional source panels to de-energize | Do AFC Panel loads feed into a shared raceway e.g. trench or trough? If Yes, specify source panels in notes. YES (see notes) | | Shared trough for feed panels located at Track #2 East and West ends. Panels "M", "1MPO", "2MPO", "4MPO", and "2MM" feed into trough. |
| <input checked="" type="checkbox"/> | Identify the assumed pathway of the duct, the location of the handholes, manholes and boxes and accessibility or special escort requirement? | PLNT <input checked="" type="checkbox"/> COMM / IT <input type="checkbox"/> ELES <input type="checkbox"/> RAIL <input type="checkbox"/> CMNT <input type="checkbox"/> Other Access/Support: MECH (Chiller Plant Access) | | |
| <input checked="" type="checkbox"/> | Identify handhole or manhole access requirement. | Required PLNT Support for handhole/manhole access? YES (see notes) Identified Conduit/Duct Transition to mezzanine level? YES | | Transition may be very difficult. Need Mech escort for access to room C206 (Chiller Plant); junction box inside this room. |

Emergency Power Verification

| Check | Task | YES | NO | NA | Comments |
|-------------------------------------|--|--------------------------|--------------------------|-------------------------------------|----------|
| <input checked="" type="checkbox"/> | Verification of the electrical plan to the existing schematic if the AFC electrical panel is connected to a Automatic Transfer Switch (ATS) / emergency power source | <input type="checkbox"/> | <input type="checkbox"/> | <input checked="" type="checkbox"/> | |

Notes and Discrepancies:

| | | |
|-------------------|---------------------------|-------------------|
| Sign Off | GFP Representative | WMATA PRGM |
| Name: | Tino Sahoo | |
| Signature: | | |
| Date: | | |

Photo #1: C09 Crystal City – Common trough in Room C302



Photo #2: C09 Crystal City – AFC Panel 2MM feeding into common trough in Room C302



Photo #3: C09 Crystal City – AFC Panel 2MM feeding into common trough in Room C302



Photo #4: C09 Crystal City – Other panels feeding into common trough in Room C302



Photo #5: C09 Crystal City – Common trough in Room C302



Photo #6: C09 Crystal City – Common trough in Room C302



Photo #7: C09 Crystal City – Conduits top feeding into AFC panel 2MM



Photo #8: C09 Crystal City – Conduits and trough in machine room C206



Photo #9: C09 Crystal City – Source breaker for AFC Panel 2MM on Panel M

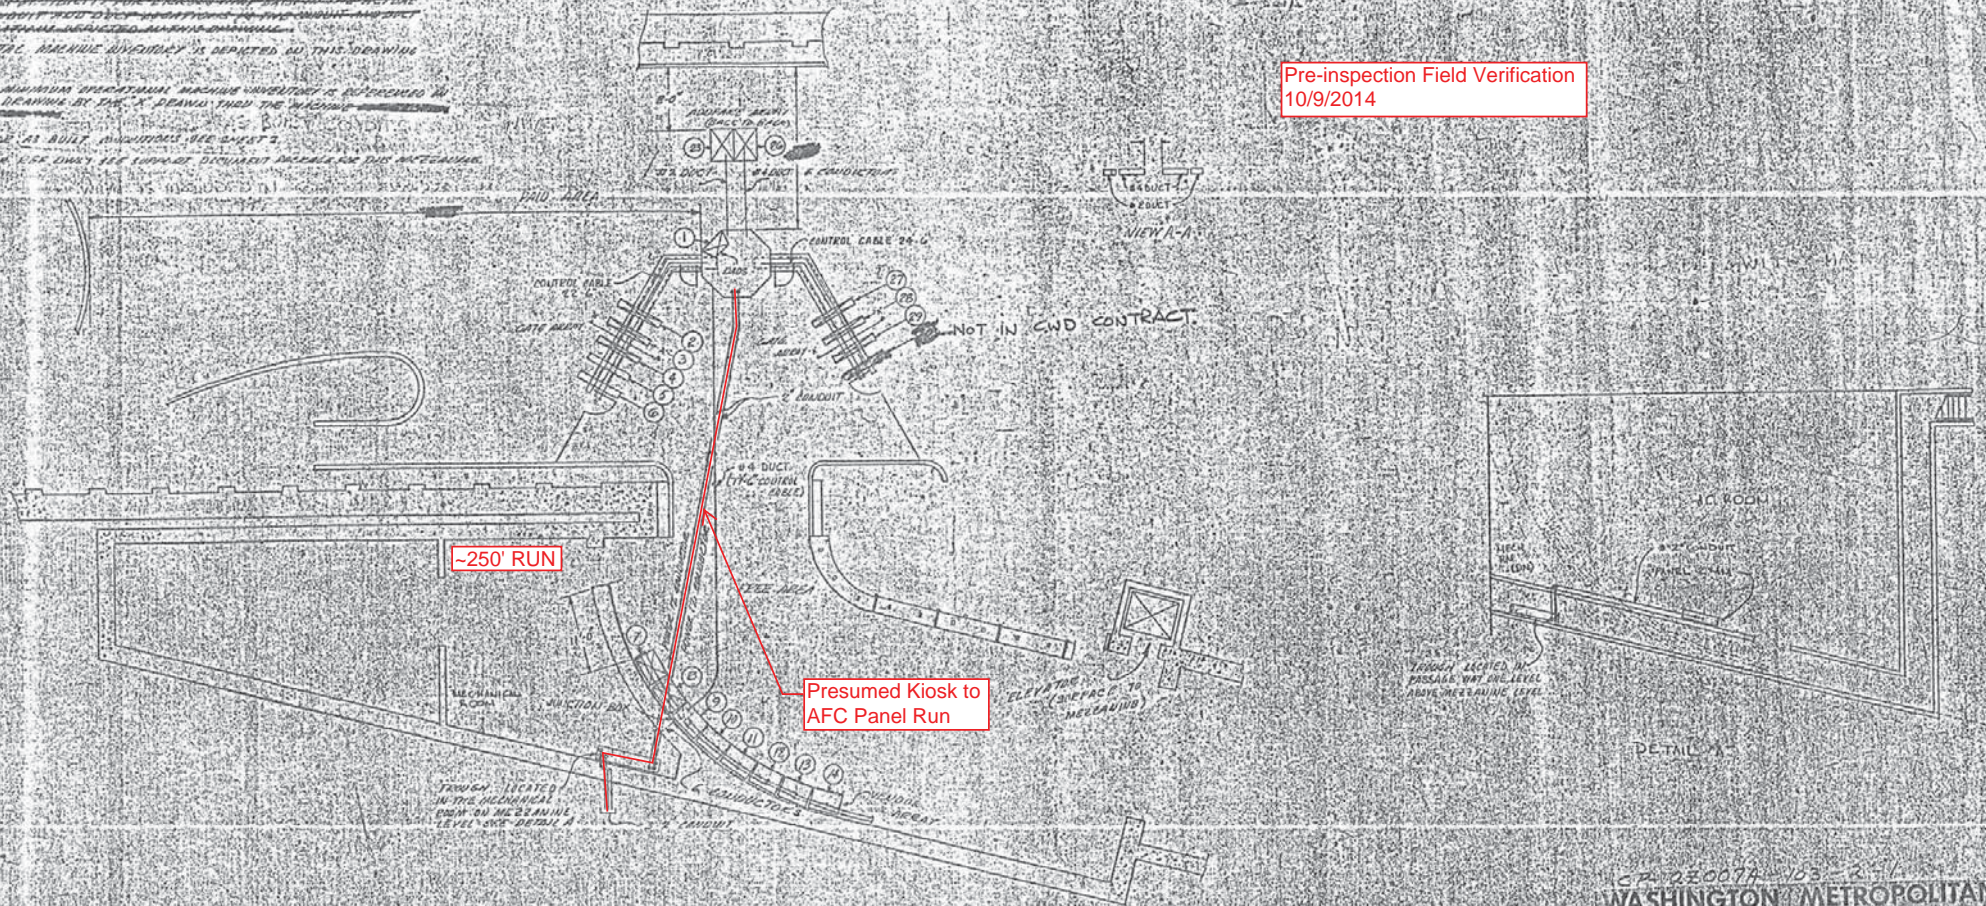


Photo #10: C09 Crystal City – Source breakers on Panel FB1 for panels feeding into common trough



NOTES:
 1. ALL INFORMATION CONCERNING DUCTS AND CONDUITS IS BASED ON INFORMATION SUPPLIED TO CUBIC WESTERN DATA BY WIMATA. CUBIC WESTERN DATA ASSUMES ALL INFORMATION IS CORRECT AND COMPLETE. THE CONTRACTOR SHALL VERIFY ALL INFORMATION FROM THE FIELD PRIOR TO THE START OF WORK. ANY DISCREPANCIES SHALL BE REPORTED IMMEDIATELY TO THE ARCHITECT.
 2. TOTAL MACHINE WEIGHTS IS DEPICTED IN THIS DRAWING.
 3. THE MAXIMUM WEIGHTS MACHINE WEIGHTS IS DEPICTED IN THIS DRAWING BY THE 'X' DRAWN THROUGH THE MACHINE WEIGHTS.
 4. ALL DUCT INSTALLATIONS SEE SHEET 2.
 5. FOR USE ONLY SEE SUPPORT DOCUMENTS REGARDING THIS PROJECT.

Pre-inspection Field Verification
 10/9/2014



-250' RUN

Presumed Kiosk to
 AFC Panel Run

PRIORITY REQUESTS: ARE AIRCRAFT GROUND FOR BOTH ESCALATORS (STREET TO MEZANINE) AND THE ELEVATOR THAT RISE FROM THE STREET LEVEL TO THE MEZANINE.

INSTALLATION PLAN

APPROVED & NOTICED
 WASHINGTON METROPOLITAN AREA TRANSIT AUTHORITY
 APPROVED BY: [Signature]
 DATE: 12-1-76

CP 2E007A-103-21
 WASHINGTON METROPOLITAN AREA TRANSIT AUTHORITY

| | |
|-----------------|--------------------|
| CONTRACT NUMBER | CUBIC WESTERN DATA |
| DATE | 12-1-76 |
| PROJECT NAME | CONST. OF STATION |
| PROJECT NUMBER | WFO WACOMBS |
| DRAWING NUMBER | 926-0376 |
| SHEET | 1 OF 1 |

Pre-inspection Field Verification
10/9/2014

| EXISTING PANEL "2MM" ✓ | | | | | | | | | | | |
|------------------------|-----|-----|----------------|-----|-----|---------------------------------------|-----|-----|------------------|-----------------|--------------------------------|
| AMPERES: 300 | | | VOLTS: 120/208 | | | MOUNTING: SURFACE | | | | | |
| MANS: 200AMCB | | | PHASE: 3 | | | LOCATION: ELEC. EQUIPMENT ROOM C302 ✓ | | | | | |
| RATING: 16KAC | | | WIRE: 4 | | | SECTION: 1 OF 1 | | | | | |
| LOAD DESCRIPTION | KVA | AMP | POLE | NO. | NO. | POLE | AMP | KVA | LOAD DESCRIPTION | | |
| EXISTING VENDOR | 0.8 | 20 | 1 | A | - | 2 | 1 | 20 | 0.8 | EXISTING VENDOR | |
| EXISTING VENDOR | 0.8 | 20 | 1 | 3 | - | B | 4 | 1 | 20 | 0.8 | EXISTING VENDOR |
| EXISTING VENDOR | 0.8 | 20 | 1 | 5 | - | C | 6 | 1 | 20 | 0.8 | SPARE |
| EXISTING VENDOR | 0.8 | 20 | 1 | 7 | A | - | 8 | 1 | 20 | 0.8 | EXISTING VENDOR |
| EXISTING VENDOR | 0.8 | 20 | 1 | 9 | - | B | 10 | 1 | 20 | 0.8 | EXISTING VENDOR |
| EXISTING VENDOR | 0.8 | 20 | 1 | 11 | - | C | 12 | 1 | 20 | 0.8 | SPARE |
| EXISTING VENDOR | 0.8 | 20 | 1 | 13 | A | - | 14 | 1 | 20 | 0.8 | EXISTING VENDOR |
| EXISTING VENDOR | 0.8 | 20 | 1 | 15 | - | B | 16 | 1 | 20 | 0.8 | EXISTING VENDOR |
| EXISTING VENDOR | 0.8 | 20 | 1 | 17 | - | C | 18 | 1 | 20 | 0.8 | EXISTING VENDOR |
| EXISTING VENDOR | 0.8 | 20 | 1 | 19 | A | - | 20 | 1 | 20 | 0.8 | EXISTING VENDOR |
| EXISTING VENDOR | 0.8 | 20 | 1 | 21 | - | B | 22 | 1 | 20 | 0.8 | NEW KIOSK RECEPT. (IT & NEPP) |
| EXISTING VENDOR | 0.8 | 20 | 1 | 23 | - | C | 24 | 1 | 20 | 0.8 | SPARE (KIOSK) |
| EXISTING VENDOR | 0.8 | 20 | 1 | 25 | A | - | 26 | 1 | 20 | 0.8 | SPARE |
| EXISTING VENDOR | 0.8 | 20 | 1 | 27 | - | B | 28 | 1 | 20 | 0.8 | SPARE |
| EXISTING VENDOR | 0.8 | 20 | 1 | 29 | - | C | 30 | 1 | 20 | 0.8 | SPARE |
| EXISTING VENDOR | 0.8 | 20 | 1 | 31 | A | - | 32 | 1 | 20 | 0.8 | EXISTING VENDOR |
| EXISTING VENDOR | 0.8 | 20 | 1 | 33 | - | B | 34 | 1 | 20 | 0.8 | SPARE |
| SPACE | 0.0 | - | - | 35 | - | C | 36 | 1 | 20 | 0.8 | EXISTING VENDOR |
| SPACE | 0.0 | - | - | 37 | A | - | 38 | 3 | 30 | 2.9 | EXIST. KIOSK LOAD CENTER "RES" |
| SPACE | 0.0 | 20 | 1 | 39 | - | B | 40 | - | - | 2.5 | |
| SPACE | 0.0 | 20 | 1 | 41 | - | C | 42 | - | - | 2.5 | |

NOTES: 1. CONNECT NEW FEEDER TO EXISTING SPARE 20 A, 1P CB
2. CB TO BE RESERVED FOR FUTURE AFC

LOAD SUMMARY

| | | |
|-------------------------------------|-----------------|----------------------------------|
| LIGHTS | 0.0 x 125% | 0.0 KVA |
| RECEPTACLES, FIRST 10 KVA | 10.0 x 100% | 10.0 KVA |
| RECEPTACLES | 12.8 x 50% | 6.4 KVA |
| MISC. APPLIANCES | 0.0 x 100% | 0.0 KVA |
| LARGEST MOTOR | 0.0 x 125% | 0.0 KVA |
| MOTORS | 0.0 x 100% | 0.0 KVA |
| HEAT | 3.0 x 125% | 3.8 KVA |
| AC | 4.5 x 100% | 4.5 KVA |
| WATER HEATING | 0.0 x 125% | 0.0 KVA |
| TOTAL CONNECTED LOAD | 30.3 KVA | TOTAL DEMAND KVA 24.7 KVA |
| | | TOTAL DEMAND AMP 68.8 AMP |
| CONNECTED LOAD PHASE SUMMARY | | |
| PHASE A: | 11.7 KVA | |
| PHASE B: | 10.8 KVA | |
| PHASE C: | 8.1 KVA | |

NOTES: A. EXISTING PANEL "2MM" IS FED FROM 277/480V, 3Ø, 4W EXISTING PANEL "M" LOCATED IN ELEC. EQUIPMENT RM. C302, CIRCUIT #17-250A/3P VIA 150KVA TRANSFORMER.
B. EXISTING WIRING FED FROM BOTTOM OF PANEL BY:
* 1-3" C. TO TRANSFORMER (WIRING FILL >40%).
EXISTING WIRING FED FROM TOP OF PANEL BY:
* 4-1 1/2" C. (3-WIRING FILL >40%)(1-WIRING FILL >20%).

CONTRACT NO
14-FQ10060-CENI-24

| DESIGNED <u>C. MO</u> | DATE <u>08-14</u> | REFERENCE DRAWINGS | | REVISIONS | |
|-----------------------|-------------------|--------------------|-------------|-----------|----|
| | | NUMBER | DESCRIPTION | DATE | BY |
| DRAWN <u>C. MO</u> | DATE <u>08-14</u> | | | | |
| CHECKED <u>B. DUB</u> | DATE <u>08-14</u> | | | | |
| APPROVED <u>MA</u> | DATE | | | | |


WASHINGTON METROPOLITAN AREA TRANSIT AUTHORITY
DEPARTMENT OF TRANSIT INFRASTRUCTURE AND ENGINEERING SERVICES
OFFICE OF INFRASTRUCTURE RENEWAL PROGRAM



APPROVED _____ SUBMITTED _____ PROJECT MANAGER

NEW ELECTRONIC PAY PROGRAM (NEPP) IN METRO STATIONS
CRYSTAL CITY
PANEL SCHEDULE

SCALE: NOT TO SCALE
DRAWING NO: C09-E-102

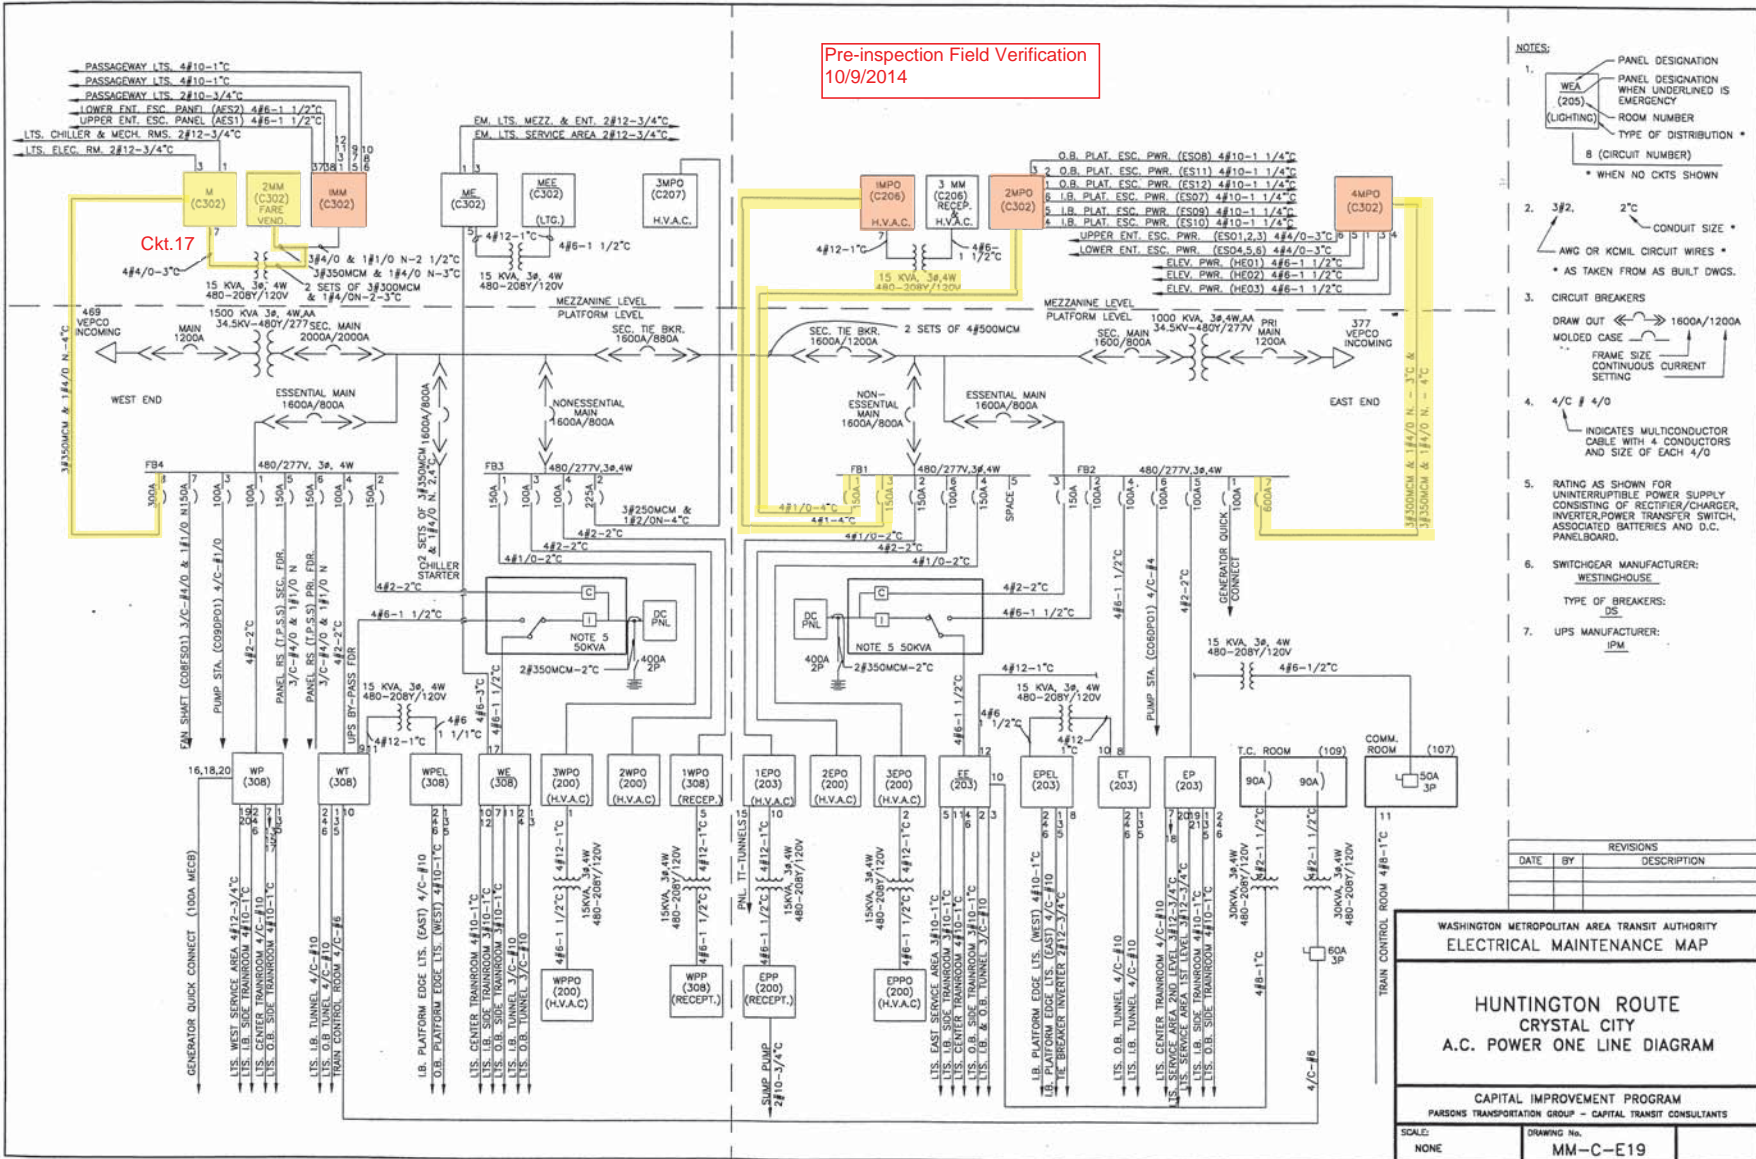

Orange box = Panels that feed into common trough and need to be de-energized

Pre-Inspection Mezzanine Walkthrough Checklist

| | | | |
|-------------------------|---|------------------------|---------------------------------|
| Date: 10/07/2014 | Station Name: C10 Reagan Airport South | Mezzanine # 046 | Completed By: Tino Sahoo |
|-------------------------|---|------------------------|---------------------------------|

| Check | Task | Equipment | Room ID | Notes |
|-------------------------------------|--|--|------------------------------|--|
| <input checked="" type="checkbox"/> | Verify electrical power design matches the field/record. Identify locations of the electrical equipment. | Electrical Source Panel Name/Number: Panel SLE Source Breaker Name/Number: Circuit #1 Disconnect switch 'Train Control Power' Electrical AFC Panel Name/Number: F, Train Control Power Panel | C116 C116 C108 | Source Panel: SLE (AFC Source Panel) (Rm C116) Breakers: Circuit #1 on Panel SLE Disconnect switch 'Train Control Power' Affected Panels: F (Rm C108) AFC Panel Train Control Power Panel (Rm C108) |
| <input checked="" type="checkbox"/> | Is there a disconnect switch connected to the AFC electrical power panel? Low or High voltage SMNT/POWR escorts required? | Disconnect Name/Number: N/A SMNT/POWR escorts: LOW Voltage | | |
| <input checked="" type="checkbox"/> | Check if there is a shared raceway between AFC Panel and Kiosk and identify additional source panels to de-energize | Do AFC Panel loads feed into a shared raceway e.g. trench or trough? If Yes, specify source panels in notes. YES (see notes) | | Shares trough with Train Control Power Panel which is sourced from Panel SLE Circuit #10 or has 'Train Control Power' Disconnect Switch. |
| <input checked="" type="checkbox"/> | Identify the assumed pathway of the duct, the location of the handholes, manholes and boxes and accessibility or special escort requirement? | PLNT <input checked="" type="checkbox"/> COMM / IT <input type="checkbox"/> ELES <input type="checkbox"/> RAIL <input type="checkbox"/> CMNT <input type="checkbox"/> Other Access/Support: ATC | | |
| <input checked="" type="checkbox"/> | Identify handhole or manhole access requirement. | Required PLNT Support for handhole/manhole access? YES (see notes) Identified Conduit/Duct Transition to mezzanine level? YES | | All conduits/duct on same level. |

Emergency Power Verification

| Check | Task | YES | NO | NA | Comments |
|-------------------------------------|--|--------------------------|--------------------------|-------------------------------------|----------|
| <input checked="" type="checkbox"/> | Verification of the electrical plan to the existing schematic if the AFC electrical panel is connected to a Automatic Transfer Switch (ATS) / emergency power source | <input type="checkbox"/> | <input type="checkbox"/> | <input checked="" type="checkbox"/> | |

Notes and Discrepancies:

| | | |
|-------------------|---------------------------|-------------------|
| Sign Off | GFP Representative | WMATA PRGM |
| Name: | Tino Sahoo | Oscar Ilgan |
| Signature: | | |
| Date: | 10/07/14 | |

Photo #1: C10 Reagan Airport South – Handholes at Mezzanine & Kiosk



Photo #2: C10 Reagan Airport South – Handholes in hallway to Station Facility Rooms



Photo #3: C10 Reagan Airport South – Panel SLE in Room C116



Photo #4: C10 Reagan Airport South – Panel SLE Schedule

PANEL SLE 120/208V
SPECIAL SERVICES DIVISION

CENTRULANI
TOTAL ELECTRICAL SYSTEM
24 HOUR EMERGENCY-TESTING-

| CIR. NO. | SERVING | CIR. NO. |
|--------------|--|----------|
| 1 | Panel F | |
| 2 | | |
| 3 | <i>Moved to #10</i> Train Control Rm.#5 (Spare) | |
| 4 | Spare | |
| 5 | Next Train Lts. Inbound Track | |
| 6 | Fut. (Next Train Lts.) Inbound | |
| 7 | Next Train Lts. Inbound Track | |
| 8 | Fut. (Next Train Lts.) Inbound | |
| 9 | Spare | |
| 10 | Spare TRAIN CONTROL Rm#5 | |

| EXISTING PANEL "F"(North) | | | | | | | | | | | | | |
|---------------------------|-----|----------------|------|----------------------------------|------|-----|-----|------|-----|-----|-------------------------------|----------|------|
| AMPERES: 225 | | VOLTS: 120/208 | | MOUNTING: SURFACE | | | | | | | | | |
| MANS: 22BAMCB | | PHASE: 3 | | LOCATION: ELEC EQUIPMENT RM. 119 | | | | | | | | | |
| RATING: 10K AC | | WIRE: 4 | | SECTION: 1 OF 1 | | | | | | | | | |
| LOAD DESCRIPTION | KVA | AMP | POLE | CKT BKRS | | NO. | NO. | POLE | AMP | KVA | LOAD DESCRIPTION | CKT BKRS | |
| | | | | NO. | POLE | | | | | | | NO. | POLE |
| SPARE | 0.0 | 20 | 1 | 1 | A | - | 2 | 3 | 20 | 3.3 | EXIST. LOAD CENTER 'KES' | | |
| EXISTING VENDOR | 0.8 | 20 | 1 | 3 | B | - | 4 | - | - | 3.3 | | | |
| EXISTING VENDOR | 0.8 | 20 | 1 | 5 | - | C | 6 | - | - | 3.3 | | | |
| EXISTING VENDOR | 0.8 | 20 | 1 | 7 | A | - | 8 | 9 | 20 | 0.8 | EXISTING VENDOR | | |
| SPARE | 0.0 | 20 | 1 | 9 | B | - | 10 | - | - | 0.8 | | | |
| SPARE | 0.0 | 20 | 1 | 11 | - | C | 12 | - | - | 0.8 | | | |
| EXISTING VENDOR | 0.8 | 20 | 1 | 13 | A | - | 14 | 1 | 20 | 0.8 | EXISTING VENDOR | | |
| EXISTING VENDOR | 0.8 | 20 | 1 | 15 | B | - | 16 | 1 | 20 | 0.8 | EXISTING VENDOR | | |
| EXISTING VENDOR | 0.8 | 20 | 1 | 17 | - | C | 18 | 1 | 20 | 0.8 | EXISTING VENDOR | | |
| EXISTING VENDOR | 0.8 | 20 | 1 | 19 | A | - | 20 | 1 | 20 | 0.8 | EXISTING VENDOR | | |
| EXISTING VENDOR | 0.8 | 20 | 1 | 21 | B | - | 22 | 1 | 20 | 0.8 | EXISTING VENDOR | | |
| EXISTING VENDOR | 0.8 | 20 | 1 | 23 | - | C | 24 | 1 | 20 | 0.0 | SPARE | | |
| EXISTING VENDOR | 0.8 | 20 | 1 | 25 | A | - | 26 | 1 | 20 | 0.8 | NEW KIOSK RECEPT. (IT & NEPP) | 1 | |
| EXISTING VENDOR | 0.8 | 20 | 1 | 27 | B | - | 28 | 1 | 20 | 0.8 | SPARE (KIOSK) | 1&2 | |
| SPARE | 0.0 | 20 | 1 | 29 | - | C | 30 | 1 | 20 | 0.0 | SPARE | | |
| EXISTING VENDOR | 0.8 | 20 | 1 | 31 | A | - | 32 | - | - | 0.0 | SPARE | | |
| SPARE | 0.0 | 20 | 1 | 33 | B | - | 34 | - | - | 0.0 | SPARE | | |
| EXISTING VENDOR | 0.8 | 20 | 1 | 35 | - | C | 36 | - | - | 0.0 | SPARE | | |
| EXISTING VENDOR | 0.8 | 20 | 1 | 37 | A | - | 38 | - | - | 0.0 | SPARE | | |
| EXISTING VENDOR | 0.8 | 20 | 1 | 39 | B | - | 40 | - | - | 0.0 | SPARE | | |
| EXISTING VENDOR | 0.8 | 20 | 1 | 41 | - | C | 42 | - | - | 0.0 | SPARE | | |

NOTES: 1. CONNECT NEW FEEDER TO EXISTING SPARE 20A, 1P CB
2. CB TO BE RESERVED FOR FUTURE AFC

LOAD SUMMARY

| | | |
|-------------------------------------|-----------------|------------------------------------|
| LIGHTS | 0.0 x 125% | 0.0 KVA |
| RECEPTACLES, FIRST 10 KVA | 10.0 x 100% | 10.0 KVA |
| RECEPTACLES | 12.4 x 50% | 6.2 KVA |
| MISC. APPLIANCES | 0.0 x 100% | 0.0 KVA |
| LARGEST MOTOR | 0.0 x 125% | 0.0 KVA |
| MOTORS | 0.0 x 100% | 0.0 KVA |
| HEAT | 3.0 x 125% | 3.8 KVA |
| AC | 4.5 x 100% | 4.5 KVA |
| WATER HEATING | 0.0 x 125% | 0.0 KVA |
| TOTAL CONNECTED LOAD | 29.9 KVA | TOTAL DEMAND KVA 24.8 KVA |
| | | TOTAL DEMAND AMPS 67.8 AMPS |
| CONNECTED LOAD PHASE SUMMARY | | |
| PHASE A: | 11.3 KVA | |
| PHASE B: | 8.7 KVA | |
| PHASE C: | 8.9 KVA | |

- NOTES: A. EXISTING PANEL "F" IS FED FROM 277/480V, 3ø, 4W EXISTING PANEL "HM1" LOCATED IN ELEC. EQUIPMENT 119, CIRCUIT #25-150/3P VIA 75KVA TRANSFORMER (SEE ATTACHED DWG. MM-C-E22).
- B. EXISTING WIRING FED FROM BOTTOM OF PANEL BY:
- 2-6 1/2" x 1 1/2" FLOOR DUCT (1-WIRING FILL >40%)(1-WIRING FILL >10%).
 - 3-1/2" C. (2-WIRING FILL >40%)(1-EMPTY CONDUIT).
- EXISTING WIRING FED FROM TOP OF PANEL BY:
- 1-4" C. TO TRANSFORMER (WIRING FILL >40%).
 - 3-1/2" C. (WIRING FILL >40%).
 - 1-#12 WIRING.

| EXISTING PANEL "F"(South) | | | | | | | | | | | | | |
|---------------------------|-----|----------------|------|-----------------------------------|------|-----|-----|------|-----|-----|-------------------------------|----------|------|
| AMPERES: 225 | | VOLTS: 120/208 | | MOUNTING: SURFACE | | | | | | | | | |
| MANS: 200AMCB | | PHASE: 3 | | LOCATION: ELEC EQUIPMENT RM. C108 | | | | | | | | | |
| RATING: 10K AC | | WIRE: 4 | | SECTION: 1 OF 1 | | | | | | | | | |
| LOAD DESCRIPTION | KVA | AMP | POLE | CKT BKRS | | NO. | NO. | POLE | AMP | KVA | LOAD DESCRIPTION | CKT BKRS | |
| | | | | NO. | POLE | | | | | | | NO. | POLE |
| EXISTING VENDOR | 0.8 | 20 | 1 | 1 | A | - | 2 | 1 | 20 | 0.8 | EXISTING VENDOR | | |
| EXISTING VENDOR | 0.8 | 20 | 1 | 3 | B | - | 4 | 1 | 20 | 0.8 | EXISTING VENDOR | | |
| EXISTING VENDOR | 0.8 | 20 | 1 | 5 | - | C | 6 | 1 | 20 | 0.8 | EXISTING VENDOR | | |
| EXISTING VENDOR | 0.8 | 20 | 1 | 7 | A | - | 8 | 1 | 20 | 0.8 | EXISTING VENDOR | | |
| EXISTING VENDOR | 0.8 | 20 | 1 | 9 | B | - | 10 | 1 | 20 | 0.8 | EXISTING VENDOR | | |
| EXISTING VENDOR | 0.8 | 20 | 1 | 11 | - | C | 12 | 1 | 20 | 0.8 | EXISTING VENDOR | | |
| EXISTING VENDOR | 0.8 | 20 | 1 | 13 | A | - | 14 | 1 | 20 | 0.8 | EXISTING VENDOR | | |
| EXISTING VENDOR | 0.8 | 20 | 1 | 15 | B | - | 16 | 1 | 20 | 0.8 | EXISTING VENDOR | | |
| EXISTING VENDOR | 0.8 | 20 | 1 | 17 | - | C | 18 | 1 | 20 | 0.8 | EXISTING VENDOR | | |
| EXISTING VENDOR | 0.8 | 20 | 1 | 19 | A | - | 20 | 1 | 20 | 0.8 | EXISTING VENDOR | | |
| EXISTING VENDOR | 0.8 | 20 | 1 | 21 | B | - | 22 | 1 | 20 | 0.8 | NEW KIOSK RECEPT. (IT & NEPP) | 1 | |
| EXISTING VENDOR | 0.8 | 20 | 1 | 23 | - | C | 24 | 1 | 20 | 0.0 | SPARE (KIOSK) | 1&2 | |
| EXISTING VENDOR | 0.8 | 20 | 1 | 25 | A | - | 26 | 1 | 20 | 0.0 | SPARE | | |
| EXISTING VENDOR | 0.8 | 20 | 1 | 27 | B | - | 28 | 1 | 20 | 0.0 | SPARE | | |
| EXISTING VENDOR | 0.8 | 20 | 1 | 29 | - | C | 30 | 1 | 20 | 0.0 | SPARE | | |
| EXISTING VENDOR | 0.8 | - | - | 31 | A | - | 32 | 1 | 20 | 0.0 | SPARE | | |
| SPARE | 0.0 | - | - | 33 | B | - | 34 | 1 | 20 | 0.0 | SPARE | | |
| SPARE | 0.0 | - | - | 35 | - | C | 36 | 1 | 20 | 0.0 | SPARE | | |
| EXISTING VENDOR | 0.8 | - | - | 37 | A | - | 38 | 3 | 30 | 2.9 | EXIST. LOAD CENTER 'KES' | | |
| SPARE | 0.0 | - | - | 39 | B | - | 40 | - | - | 2.5 | | | |
| EXISTING VENDOR | 0.8 | - | - | 41 | - | C | 42 | - | - | 2.5 | | | |

NOTES: 1. CONNECT NEW FEEDER TO EXISTING SPARE 20A, 1P CB
2. CB TO BE RESERVED FOR FUTURE AFC

LOAD SUMMARY

| | | |
|-------------------------------------|-----------------|------------------------------------|
| LIGHTS | 0.0 x 125% | 0.0 KVA |
| RECEPTACLES, FIRST 10 KVA | 10.0 x 100% | 10.0 KVA |
| RECEPTACLES | 12.8 x 50% | 6.4 KVA |
| MISC. APPLIANCES | 0.0 x 100% | 0.0 KVA |
| LARGEST MOTOR | 0.0 x 125% | 0.0 KVA |
| MOTORS | 0.0 x 100% | 0.0 KVA |
| HEAT | 3.0 x 125% | 3.8 KVA |
| AC | 4.5 x 100% | 4.5 KVA |
| WATER HEATING | 0.0 x 125% | 0.0 KVA |
| TOTAL CONNECTED LOAD | 30.3 KVA | TOTAL DEMAND KVA 24.7 KVA |
| | | TOTAL DEMAND AMPS 66.8 AMPS |
| CONNECTED LOAD PHASE SUMMARY | | |
| PHASE A: | 11.7 KVA | |
| PHASE B: | 8.9 KVA | |
| PHASE C: | 9.7 KVA | |

- NOTES: A. EXISTING PANEL "F" IS FED FROM 120/208V, 3ø, 4W EXISTING SWBD. "SLE" LOCATED IN AC SWBD. BATTERY RM. C116, CIRCUIT #2-200/3P (SEE ATTACHED DWG. MM-C-E22).
- B. EXISTING WIRING FED FROM TOP OF PANEL BY:
- 1-3/4" C. (WIRING FILL >40%).
 - 1-#12 WIRING.
- EXISTING WIRING FED FROM BOTTOM OF PANEL BY:
- 2-4" C. TO TRANSFORMER (WIRING FILL >40%).

Pre-inspection Field Verification 10/07/2014

| DESIGNED: C NSO | DATE: 09-14 | REFERENCE DRAWINGS | | REVISIONS | |
|-----------------|-------------|--------------------|-------------|-----------|----|
| | | NUMBER | DESCRIPTION | DATE | BY |
| DRAWN: C NSO | 09-14 | | | | |
| CHECKED: B IDLE | 09-14 | | | | |
| APPROVED: N/A | DATE: | | | | |

WASHINGTON METROPOLITAN AREA TRANSIT AUTHORITY

DEPARTMENT OF TRANSIT INFRASTRUCTURE AND ENGINEERING SERVICES

OFFICE OF INFRASTRUCTURE RENEWAL PROGRAM

GFP A CONSULTING ENGINEERING PARTNERSHIP JOINT VENTURE


APPROVED _____ SUBMITTED _____ PROJECT MANAGER

NEW ELECTRONIC PAY PROGRAM (NEPP) IN METRO RAIL STATIONS NATIONAL AIRPORT - NORTH & SOUTH PANEL SCHEDULES

CONTRACT NO. 14-FQ10060-CENI-24

SCALE: NOT TO SCALE DRAWING NO. C10-E-102

D:\ELECT\NewMaintMap\VC-Route\MM-C-E22.dwg Wed Jun 21 16:22:44 2000 LP

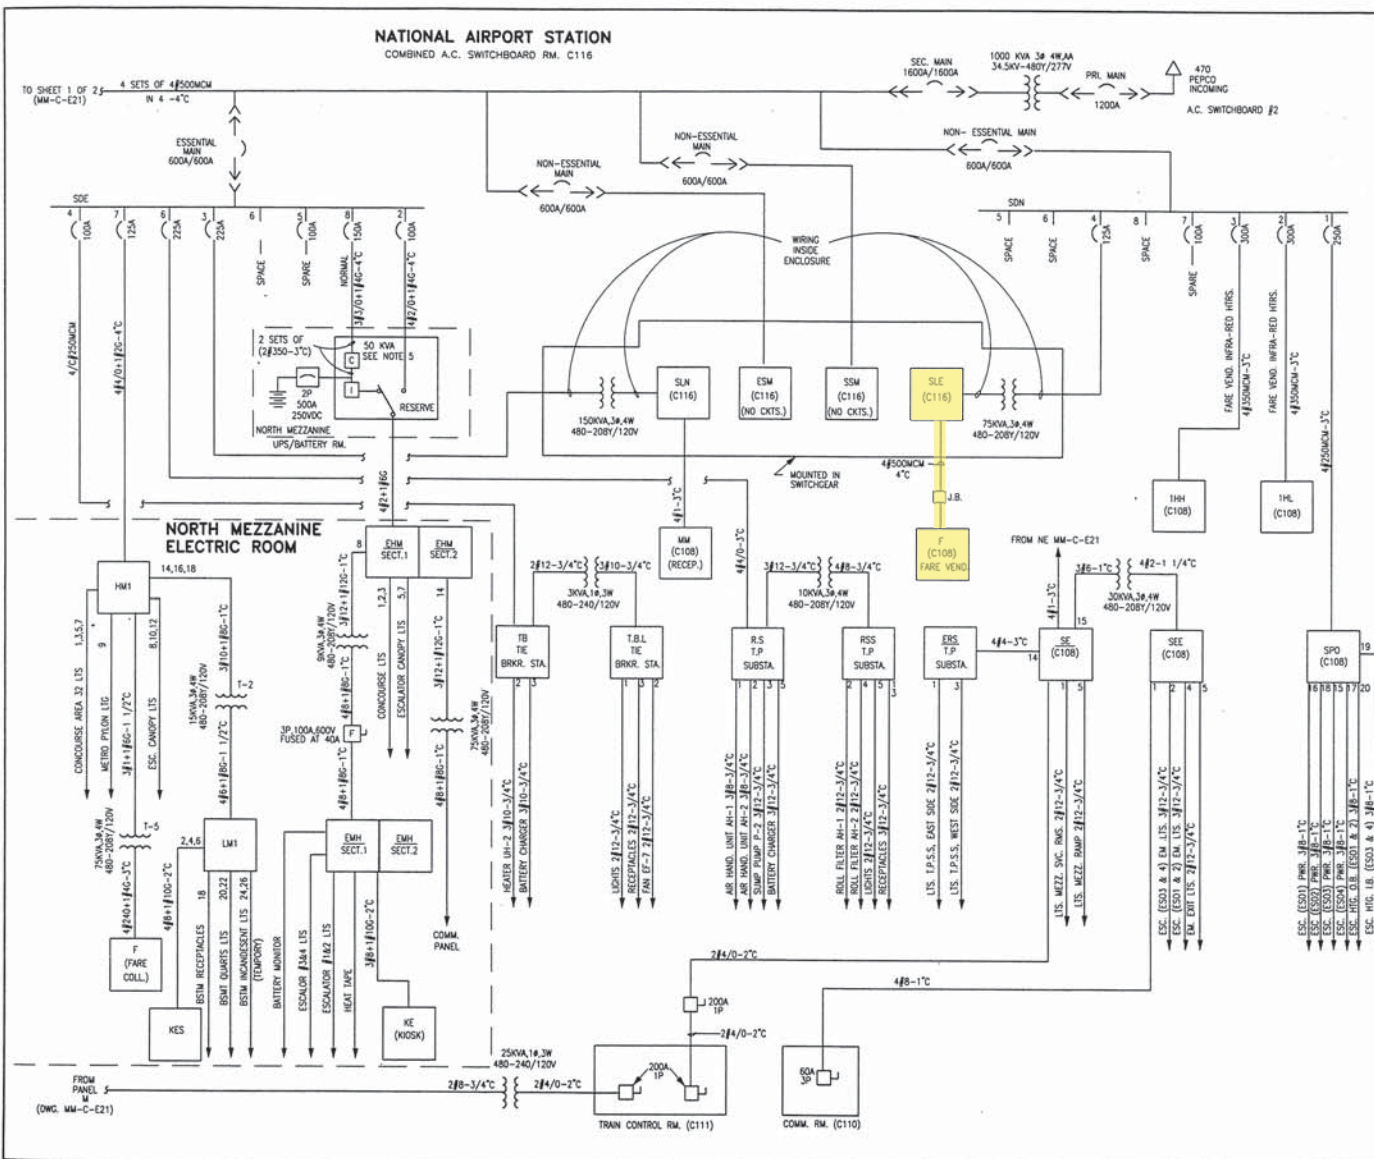

- NOTES:**
- 1. PANEL DESIGNATION
 - WEA (205) PANEL DESIGNATION WHEN UNDERLINED IS EMERGENCY (LIGHTING)
 - ROOM NUMBER
 - TYPE OF DISTRIBUTION
 - 8 (CIRCUIT NUMBER)
 - * WHEN NO CKTS SHOWN
 - 3/2, 2" CONDUIT SIZE
 - AWG OR KCMIL CIRCUIT WIRES
 - * AS TAKEN FROM AS BUILT DWGS.
 - 3. CIRCUIT BREAKERS
 - DRAW OUT ← 1600A/1200A MOLDED CASE
 - FRAME SIZE CONTINUOUS CURRENT SETTING
 - 4. 4/0 # 4/0 INDICATES MULTICONDUCTOR CABLE WITH 4 CONDUCTORS AND SIZE OF EACH 4/0
 - 5. RATING AS SHOWN FOR UNINTERRUPTIBLE POWER SUPPLY CONSISTING OF RECTIFIER/CHARGER, INVERTER, POWER TRANSFER SWITCH, ASSOCIATED BATTERIES AND D.C. PANELBOARD.
 - 4. SWITCHGEAR MANUFACTURER: GENERAL ELECTRIC
 - TYPE OF BREAKERS AK
 - 3. UPS MANUFACTURER: IEM

| REVISIONS | | |
|-----------|----|-------------|
| DATE | BY | DESCRIPTION |
| | | |
| | | |

WASHINGTON METROPOLITAN AREA TRANSIT AUTHORITY
ELECTRICAL MAINTENANCE MAP

HUNTINGTON ROUTE
NATIONAL AIRPORT STATION
A.C. POWER ONE LINE DIAGRAM
SHEET 2 OF 2

CAPITAL IMPROVEMENT PROGRAM
PARSONS TRANSPORTATION GROUP - CAPITAL TRANSIT CONSULTANTS

| | |
|--------|-------------|
| SCALE: | DRAWING No. |
| NONE | MM-C-E22 |

Pre-inspection Field Verification 10/07/2014

Pre-Inspection Mezzanine Walkthrough Checklist

| | | | |
|-------------------------|---|------------------------|---------------------------------|
| Date: 10/07/2014 | Station Name: C10 Reagan Airport North | Mezzanine # 093 | Completed By: Tino Sahoo |
|-------------------------|---|------------------------|---------------------------------|

| Check | Task | Equipment | Room ID | Notes |
|-------------------------------------|--|---|---------------------------|---|
| <input checked="" type="checkbox"/> | Verify electrical power design matches the field/record. Identify locations of the electrical equipment. | Electrical Source Panel Name/Number: HM1 Source Breaker Name/Number: 'PNL F TS' Electrical AFC Panel Name/Number: F | 119 119 119 | Emergency circuits are: Circuits 2,4,6 of source panel LM1 to de-energize KES Panel. Disconnect switch for Panels EMH Sect 1 and EMH Sect 2. **Neither of these could be verified or found in field. |
| <input checked="" type="checkbox"/> | Is there a disconnect switch connected to the AFC electrical power panel? Low or High voltage SMNT/POWR escorts required? | Disconnect Name/Number: N/A SMNT/POWR escorts: HIGH and LOW | | S.O.: Source Panels: HM1 (Rm 119) AFC Source Panel LM1 (Rm 119) KES Source Panel EMH Sect 1 (Rm 119) KE (Kiosk) Source Panel EMH Sect 2 (Rm 119) KE (Kiosk) Source Panel |
| <input checked="" type="checkbox"/> | Check if there is a shared raceway between AFC Panel and Kiosk and identify additional source panels to de-energize | Do AFC Panel loads feed into a shared raceway e.g. trench or trough? If Yes, specify source panels in notes. NO | C106 | Breakers: 'PNL F TS' of Panel HM1 Circuits 2,4,6 of Panel LM1 'Disconnect Switch' for Panels EMH Sect 1 and EMH Sect 2. |
| <input checked="" type="checkbox"/> | Identify the assumed pathway of the duct, the location of the handholes, manholes and boxes and accessibility or special escort requirement? | PLNT <input checked="" type="checkbox"/> COMM / IT <input type="checkbox"/> ELES <input type="checkbox"/> RAIL <input type="checkbox"/> CMNT <input type="checkbox"/> Other Access/Support: AFC | | Affected Panels: F (AFC Panel) KES (Kiosk Panel) in Kiosk KE (Kiosk Panel) in Kiosk |
| <input checked="" type="checkbox"/> | Identify handhole or manhole access requirement. | Required PLNT Support for handhole/manhole access? YES (see notes) Identified Conduit/Duct Transition to mezzanine level? YES | | All conduits/duct are on same level. |

Emergency Power Verification

| Check | Task | YES | NO | NA | Comments |
|-------------------------------------|--|--------------------------|--------------------------|-------------------------------------|----------|
| <input checked="" type="checkbox"/> | Verification of the electrical plan to the existing schematic if the AFC electrical panel is connected to a Automatic Transfer Switch (ATS) / emergency power source | <input type="checkbox"/> | <input type="checkbox"/> | <input checked="" type="checkbox"/> | |

Notes and Discrepancies:

| | | |
|-------------------|---------------------------|-------------------|
| Sign Off | GFP Representative | WMATA PRGM |
| Name: | Tino Sahoo | |
| Signature: | | |
| Date: | 10/07/14 | |

Picture 1: C10 Reagan Airport North – Handhole at Mezzanine



Picture 2: C10 Reagan Airport North – Handholes at Mini-Mezzanine



Picture 3: C10 Reagan Airport North – Handholes at Mini-Mezzanine



Picture 4: C10 Reagan Airport North – Handholes at Mini-Mezzanine



Picture 5: C10 Reagan Airport North – Handholes at Mini-Mezzanine



Picture 6: C10 Reagan Airport North – Handholes at Mini-Mezzanine



Picture 7: C10 Reagan Airport North – Handhole in Room 119



Picture 8: C10 Reagan Airport North – Panel F in Room 119



Picture 9: C10 Reagan Airport North – Panel F in Room 119



Picture 10: C10 Reagan Airport North – Panel F Schedule

| F: ESSENTIAL | | | |
|------------------|-----------------------------------|---------------------|--------|
| METRO | | | |
| VOLTAGE: 120/208 | | | |
| PHASE: 3 PHASE | | WIRES: 4 WIRE | |
| 1 | TICKET DISPENSER | ESC 3&4 SIDE LIGHTS | 2 |
| 3 | T-BANK | ESC 3&4 SIDE LIGHTS | 4 |
| 6 | T-BANK | ESC 3&4 SIDE LIGHTS | 6 |
| 7 | EF-M-6 | ESC 1&2 SIDE LIGHTS | 8 |
| 9 | --- | ESC 1&2 SIDE LIGHTS | 10 |
| 11 | --- | ESC 1&2 SIDE LIGHTS | 12 |
| 13 | --- FAREGATE # 20 | VENDOR # 30 | --- 14 |
| 16 | --- FAREGATE # 19 | VENDOR # 50 | --- 16 |
| 17 | --- FAREGATE # 18 | VENDOR # 51 | --- 18 |
| 19 | --- SPARE | SP PIDS | 22- 20 |
| 21 | --- FAREGATE # 13 | SP SM TRIP # 2 | 22 |
| 23 | --- FAREGATE # 12 | SP SM TRIP # 2 | 24 |
| 25 | --- FAREGATE # 11 | SP | --- 26 |
| 27 | --- FAREGATE # 10 | SP | --- 28 |
| 29 | --- SPARE | SP | --- 30 |
| 31 | --- VENDOR SMART Cakes | SP | --- 32 |
| 33 | --- VENDOR # 35 | SP | --- 34 |
| 35 | --- VENDOR # 34 | SP | --- 36 |
| 37 | --- VENDOR # 33 | SP | --- 38 |
| --- | --- VENDOR # 32 | SP | --- 40 |
| --- | --- VENDOR # 31 | SP | --- 42 |

Picture 11: C10 Reagan Airport North – Panel F – Ducts below Panel



Picture 12: C10 Reagan Airport North – Panel HM1 in Room 119



Picture 13: C10 Reagan Airport North – Panel HM1 in Room 119



Picture 14: C10 Reagan Airport North – Panel HM1 Schedule

| HM1 ESSENTIAL | | | |
|------------------|---------------------------------|----------------------|----|
| METRO | | | |
| VOLTAGE: 120/208 | | | |
| PHASE: 3 PHASE | | WIRES: 4 WIRE | |
| 1 | CONCOURSE LTS | S | 2 |
| 3 | CONCOURSE LTS | S | 4 |
| 5 | CONCOURSE LTS | S | 6 |
| X | CONCOURSE LTS RM 201 | ESCALATOR CANOPY LTS | 8 |
| 9 | RM 201 | ESCALATOR CANOPY LTS | 10 |
| 11 | S PANEL EC | ESCALATOR CANOPY LTS | 12 |
| 13 | S FIRE EQUIP AND PANEL | PNL LM1 T-2 | 14 |
| 15 | --- | | 16 |
| 17 | --- | | 18 |
| 19 | --- | | 18 |
| 21 | --- { Panel WC | CRAWL SPACE LTS. --- | 20 |
| 23 | --- | | 22 |
| 25 | --- | | 24 |
| 27 | --- | | 26 |
| 29 | --- | | 28 |
| 31 | --- | | 30 |
| 33 | --- | | 32 |
| 35 | --- | | 34 |
| 37 | --- | | 36 |
| 39 | --- | | |


NETWORK CONTAINING DUCTS AND CONDUITS IS SHOWN
 ABOVE SUPPLIED TO PUBLIC WORKS BY W.M.A.T.A.

ON 10/7/14, IT WAS DETERMINED BY THE FIELD PERSONNEL THAT THE
 QUANTITIES WERE GIVEN TO CUBIC WESTERN DATA BY W.M.A.T.A.
 AND THE QUANTITIES WERE GIVEN TO CUBIC WESTERN DATA BY W.M.A.T.A.
 AND THE QUANTITIES WERE GIVEN TO CUBIC WESTERN DATA BY W.M.A.T.A.
 AND THE QUANTITIES WERE GIVEN TO CUBIC WESTERN DATA BY W.M.A.T.A.



Panel F

AC Service Room

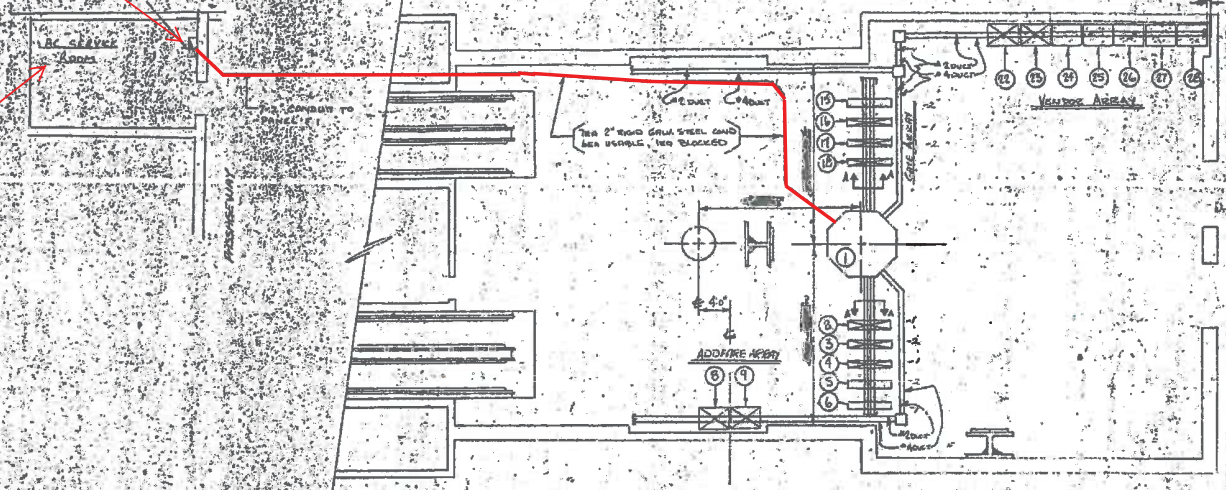

NO. 1 INSTALLATION PLAN
 SCALE: 1/8" = 1'-0" U.O.M. 1/6

Pre-Inspection Field
 Verification 10/07/2014

CP 2007A-104-2-0
 WASHINGTON METROPOLITAN
 AREA TRANSIT AUTHORITY

WASHINGTON METROPOLITAN
 AREA TRANSIT AUTHORITY
 APPROVED AS CORRECTED
 RESUBMITTAL REQUIRED
 Approval Does Not Represent the Contractor
 of the Authority, for the Accuracy of
 this Drawing or for Full Compliance
 with the Contract Requirements.
 BY: *William J. Burns*

CONTRACT NUMBER
 2007A

CUBIC WESTERN DATA
 10/07/2014

REVISIONS
 1. 10/07/2014
 2. 10/07/2014
 3. 10/07/2014
 4. 10/07/2014
 5. 10/07/2014
 6. 10/07/2014
 7. 10/07/2014
 8. 10/07/2014
 9. 10/07/2014
 10. 10/07/2014

926-0379

| EXISTING PANEL "F"(North) | | | | | | | | | | |
|---------------------------|-----|----------------|------|----------------------------------|-----|------|-----|-----|------------------|-------------------------------|
| AMPERES: 225 | | VOLTS: 120/208 | | MOUNTING: SURFACE | | | | | | |
| MANS: 22BAMCB | | PHASE: 3 | | LOCATION: ELEC EQUIPMENT RM. 119 | | | | | | |
| RATING: 10KAC | | WIRE: 4 | | SECTION: 1 OF 1 | | | | | | |
| LOAD DESCRIPTION | KVA | AMP | POLE | NO. | NO. | POLE | AMP | KVA | LOAD DESCRIPTION | |
| SPARE | 0.0 | 20 | 1 | 1 | A | - | 2 | 3 | 3.3 | EXIST. LOAD CENTER 'KES' |
| EXISTING VENDOR | 0.8 | 20 | 1 | 3 | B | - | 4 | - | 3.3 | |
| EXISTING VENDOR | 0.8 | 20 | 1 | 5 | - | C | 6 | - | 3.3 | |
| EXISTING VENDOR | 0.8 | 20 | 1 | 7 | A | - | 8 | 9 | 20 | EXISTING VENDOR |
| SPARE | 0.0 | 20 | 1 | 9 | B | - | 10 | - | 0.8 | |
| SPARE | 0.0 | 20 | 1 | 11 | - | C | 12 | - | 0.8 | |
| EXISTING VENDOR | 0.8 | 20 | 1 | 13 | A | - | 14 | 1 | 20 | EXISTING VENDOR |
| EXISTING VENDOR | 0.8 | 20 | 1 | 15 | B | - | 16 | 1 | 20 | EXISTING VENDOR |
| EXISTING VENDOR | 0.8 | 20 | 1 | 17 | - | C | 18 | 1 | 20 | EXISTING VENDOR |
| EXISTING VENDOR | 0.8 | 20 | 1 | 19 | A | - | 20 | 1 | 20 | EXISTING VENDOR |
| EXISTING VENDOR | 0.8 | 20 | 1 | 21 | B | - | 22 | 1 | 20 | EXISTING VENDOR |
| EXISTING VENDOR | 0.8 | 20 | 1 | 23 | - | C | 24 | 1 | 20 | SPARE |
| EXISTING VENDOR | 0.8 | 20 | 1 | 25 | A | - | 26 | 1 | 20 | NEW KIOSK RECEPT. (IT & NEPP) |
| EXISTING VENDOR | 0.8 | 20 | 1 | 27 | B | - | 28 | 1 | 20 | SPARE (KIOSK) |
| SPARE | 0.0 | 20 | 1 | 29 | - | C | 30 | 1 | 20 | SPARE |
| EXISTING VENDOR | 0.8 | 20 | 1 | 31 | A | - | 32 | - | 0.0 | SPARE |
| SPARE | 0.0 | 20 | 1 | 33 | B | - | 34 | - | 0.0 | SPARE |
| EXISTING VENDOR | 0.8 | 20 | 1 | 35 | - | C | 36 | - | 0.0 | SPARE |
| EXISTING VENDOR | 0.8 | 20 | 1 | 37 | A | - | 38 | - | 0.0 | SPARE |
| EXISTING VENDOR | 0.8 | 20 | 1 | 39 | B | - | 40 | - | 0.0 | SPARE |
| EXISTING VENDOR | 0.8 | 20 | 1 | 41 | - | C | 42 | - | 0.0 | SPARE |

NOTES: 1. CONNECT NEW FEEDER TO EXISTING SPARE 20A, 1P CB
2. CB TO BE RESERVED FOR FUTURE AFC

LOAD SUMMARY

| | | |
|-------------------------------------|-----------------|------------------------------------|
| LIGHTS | 0.0 x 125% | 0.0 KVA |
| RECEPTACLES, FIRST 10 KVA | 10.0 x 100% | 10.0 KVA |
| RECEPTACLES | 12.4 x 50% | 6.2 KVA |
| MISC. APPLIANCES | 0.0 x 100% | 0.0 KVA |
| LARGEST MOTOR | 0.0 x 125% | 0.0 KVA |
| MOTORS | 0.0 x 100% | 0.0 KVA |
| HEAT | 3.0 x 125% | 3.8 KVA |
| AC | 4.5 x 100% | 4.5 KVA |
| WATER HEATING | 0.0 x 125% | 0.0 KVA |
| TOTAL CONNECTED LOAD | 29.9 KVA | TOTAL DEMAND KVA 24.8 KVA |
| | | TOTAL DEMAND AMPS 67.8 AMPS |
| CONNECTED LOAD PHASE SUMMARY | | |
| PHASE A: | 11.3 KVA | |
| PHASE B: | 8.7 KVA | |
| PHASE C: | 8.9 KVA | |

NOTES: A. EXISTING PANEL "F" IS FED FROM 277/480V, 3ø, 4W EXISTING PANEL "HM1" LOCATED IN ELEC. EQUIPMENT 119, CIRCUIT #25-150/3P VIA 75KVA TRANSFORMER (SEE ATTACHED DWG. MM-C-E22).

- B. EXISTING WIRING FED FROM BOTTOM OF PANEL BY:
- 2-6 1/2" x 1 1/2" FLOOR DUCT (1-WIRING FILL >40%)(1-WIRING FILL >10%).
 - 3-1/2" C. (2-WIRING FILL >40%)(1-EMPTY CONDUIT).
- EXISTING WIRING FED FROM TOP OF PANEL BY:
- 1-4" C. TO TRANSFORMER (WIRING FILL >40%).
 - 3-1/2" C. (WIRING FILL >40%).
 - 1-#12 WIRING.

Pre-inspection Field Verification 10/07/2014

| EXISTING PANEL "F"(South) | | | | | | | | | | |
|---------------------------|-----|----------------|------|-----------------------------------|-----|------|-----|-----|------------------|-------------------------------|
| AMPERES: 225 | | VOLTS: 120/208 | | MOUNTING: SURFACE | | | | | | |
| MANS: 200AMCB | | PHASE: 3 | | LOCATION: ELEC EQUIPMENT RM. C108 | | | | | | |
| RATING: 10KAC | | WIRE: 4 | | SECTION: 1 OF 1 | | | | | | |
| LOAD DESCRIPTION | KVA | AMP | POLE | NO. | NO. | POLE | AMP | KVA | LOAD DESCRIPTION | |
| EXISTING VENDOR | 0.8 | 20 | 1 | 1 | A | - | 2 | 1 | 20 | EXISTING VENDOR |
| EXISTING VENDOR | 0.8 | 20 | 1 | 3 | B | - | 4 | 1 | 20 | EXISTING VENDOR |
| EXISTING VENDOR | 0.8 | 20 | 1 | 5 | - | C | 6 | 1 | 20 | EXISTING VENDOR |
| EXISTING VENDOR | 0.8 | 20 | 1 | 7 | A | - | 8 | 1 | 20 | EXISTING VENDOR |
| EXISTING VENDOR | 0.8 | 20 | 1 | 9 | B | - | 10 | 1 | 20 | EXISTING VENDOR |
| EXISTING VENDOR | 0.8 | 20 | 1 | 11 | - | C | 12 | 1 | 20 | EXISTING VENDOR |
| EXISTING VENDOR | 0.8 | 20 | 1 | 13 | A | - | 14 | 1 | 20 | EXISTING VENDOR |
| EXISTING VENDOR | 0.8 | 20 | 1 | 15 | B | - | 16 | 1 | 20 | EXISTING VENDOR |
| EXISTING VENDOR | 0.8 | 20 | 1 | 17 | - | C | 18 | 1 | 20 | EXISTING VENDOR |
| EXISTING VENDOR | 0.8 | 20 | 1 | 19 | A | - | 20 | 1 | 20 | EXISTING VENDOR |
| SPARE | 0.0 | 20 | 1 | 21 | B | - | 22 | 1 | 20 | NEW KIOSK RECEPT. (IT & NEPP) |
| EXISTING VENDOR | 0.8 | 20 | 1 | 23 | - | C | 24 | 1 | 20 | SPARE (KIOSK) |
| EXISTING VENDOR | 0.8 | 20 | 1 | 25 | A | - | 26 | 1 | 20 | SPARE |
| EXISTING VENDOR | 0.8 | 20 | 1 | 27 | B | - | 28 | 1 | 20 | SPARE |
| EXISTING VENDOR | 0.8 | 20 | 1 | 29 | - | C | 30 | 1 | 20 | SPARE |
| EXISTING VENDOR | 0.8 | - | - | 31 | A | - | 32 | 1 | 20 | SPARE |
| SPARE | 0.0 | - | - | 33 | B | - | 34 | 1 | 20 | SPARE |
| SPARE | 0.0 | - | - | 35 | - | C | 36 | 1 | 20 | SPARE |
| EXISTING VENDOR | 0.8 | - | - | 37 | A | - | 38 | 3 | 20 | EXIST. LOAD CENTER 'KES' |
| SPARE | 0.0 | - | - | 39 | B | - | 40 | - | 2.5 | |
| EXISTING VENDOR | 0.8 | - | - | 41 | - | C | 42 | - | 2.5 | |

NOTES: 1. CONNECT NEW FEEDER TO EXISTING SPARE 20A, 1P CB
2. CB TO BE RESERVED FOR FUTURE AFC

LOAD SUMMARY

| | | |
|-------------------------------------|-----------------|------------------------------------|
| LIGHTS | 0.0 x 125% | 0.0 KVA |
| RECEPTACLES, FIRST 10 KVA | 10.0 x 100% | 10.0 KVA |
| RECEPTACLES | 12.8 x 50% | 6.4 KVA |
| MISC. APPLIANCES | 0.0 x 100% | 0.0 KVA |
| LARGEST MOTOR | 0.0 x 125% | 0.0 KVA |
| MOTORS | 0.0 x 100% | 0.0 KVA |
| HEAT | 3.0 x 125% | 3.8 KVA |
| AC | 4.5 x 100% | 4.5 KVA |
| WATER HEATING | 0.0 x 125% | 0.0 KVA |
| TOTAL CONNECTED LOAD | 30.3 KVA | TOTAL DEMAND KVA 24.7 KVA |
| | | TOTAL DEMAND AMPS 66.8 AMPS |
| CONNECTED LOAD PHASE SUMMARY | | |
| PHASE A: | 11.7 KVA | |
| PHASE B: | 8.9 KVA | |
| PHASE C: | 9.7 KVA | |

NOTES: A. EXISTING PANEL "F" IS FED FROM 120/208V, 3ø, 4W EXISTING SWDB. "SLE" LOCATED IN AC SWDB. BATTERY RM. C116, CIRCUIT #2-200/3P (SEE ATTACHED DWG. MM-C-E22).

- B. EXISTING WIRING FED FROM TOP OF PANEL BY:
- 1-3/4" C. (WIRING FILL >40%).
 - 1-#12 WIRING.
- EXISTING WIRING FED FROM BOTTOM OF PANEL BY:
- 2-4" C. TO TRANSFORMER (WIRING FILL >40%).

| DESIGNED: C NSG | DATE: 09-14 | REFERENCE DRAWINGS | | REVISIONS | |
|-----------------|-------------|--------------------|-------------|-----------|----|
| | | NUMBER | DESCRIPTION | DATE | BY |
| DRAWN: C NSG | 09-14 | | | | |
| CHECKED: B IDLE | 09-14 | | | | |
| APPROVED: NA | DATE | | | | |

WASHINGTON METROPOLITAN AREA TRANSIT AUTHORITY
DEPARTMENT OF TRANSIT INFRASTRUCTURE AND ENGINEERING SERVICES
OFFICE OF INFRASTRUCTURE RENEWAL PROGRAM

GFP A CONSULTING FIRM/PROJECT JOINT VENTURE

APPROVED _____ SUBMITTED _____ PROJECT MANAGER


CONTRACT NO. 14-FQ10060-CENI-24

NEW ELECTRONIC PAY PROGRAM (NEPP) IN METRO RAIL STATIONS NATIONAL AIRPORT - NORTH & SOUTH PANEL SCHEDULES

SCALE: NOT TO SCALE DRAWING NO: C10-E-102

D:\ELECT\NewMaintMap\VC-Route\MM-C-E22.dwg Wed Jun 21 16:22:44 2000 LP

NATIONAL AIRPORT STATION
COMBINED A.C. SWITCHBOARD RM. C116

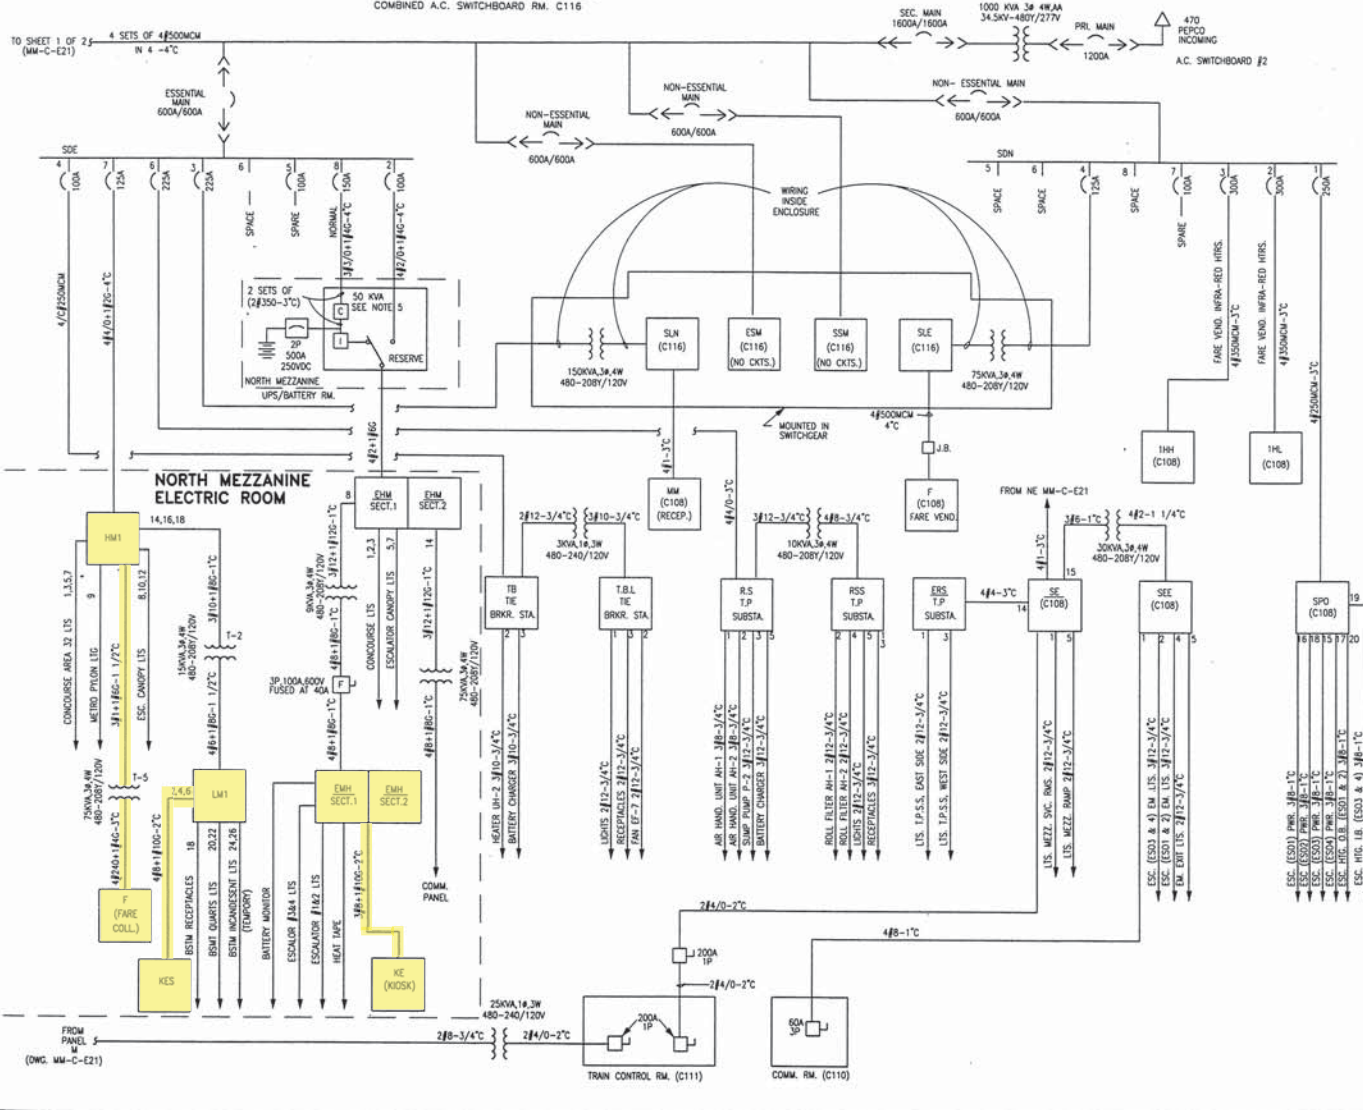

- NOTES:
1. PANEL DESIGNATION
WEA (205)
(LIGHTING)
ROOM NUMBER
TYPE OF DISTRIBUTION
8 (CIRCUIT NUMBER)
* WHEN NO CKTS SHOWN
 2. 3/2, 2" CONDUIT SIZE
AWG OR KCMIL CIRCUIT WIRES
* AS TAKEN FROM AS BUILT DWGS.
 3. CIRCUIT BREAKERS
DRAW OUT
MOLDED CASE
FRAME SIZE
CONTINUOUS CURRENT SETTING
 4. 4/0 # 4/0
INDICATES MULTICONDUCTOR CABLE WITH 4 CONDUCTORS AND SIZE OF EACH 4/0
 5. RATING AS SHOWN FOR UNINTERRUPTIBLE POWER SUPPLY CONSISTING OF RECTIFIER/CHARGER, INVERTER, POWER TRANSFER SWITCH, ASSOCIATED BATTERIES AND D.C. PANELBOARD.
 6. SWITCHGEAR MANUFACTURER: GENERAL ELECTRIC
TYPE OF BREAKERS: AK
 7. UPS MANUFACTURER: IEM

| REVISIONS | | |
|-----------|----|-------------|
| DATE | BY | DESCRIPTION |
| | | |
| | | |
| | | |

WASHINGTON METROPOLITAN AREA TRANSIT AUTHORITY
ELECTRICAL MAINTENANCE MAP

HUNTINGTON ROUTE
NATIONAL AIRPORT STATION
A.C. POWER ONE LINE DIAGRAM
SHEET 2 OF 2

CAPITAL IMPROVEMENT PROGRAM
PARSONS TRANSPORTATION GROUP - CAPITAL TRANSIT CONSULTANTS

| | |
|-------------|----------------------|
| SCALE: NONE | DRAWING No. MM-C-E22 |
|-------------|----------------------|

Pre-inspection Field Verification 10/07/2014

Pre-Inspection Mezzanine Walkthrough Checklist

REVISION 1

| Date: 10/07/2014 | Station Name: C12 Braddock Road | Mezzanine #: MZ047 | Completed By: Tino Sahoo | |
|-------------------------------------|--|--|--------------------------|---|
| Check | Task | Equipment | Room ID | Notes |
| <input checked="" type="checkbox"/> | Verify that electrical power design matches the field/record. Identify locations of the electrical equipment. | Electrical Source Panel Name/Number: SWBD #2 Source Breaker Name/Number: "Panel F" Electrical AFC Panel Name/Number: Panel F | C111 C111 C111 | |
| <input checked="" type="checkbox"/> | Verify if disconnect switch is connected to the AFC electrical power panel. Low or High voltage SMNT/POWR escorts requirements? | Disconnect Name/Number: N/A SMNT/POWR escorts: HIGH AND LOW VOLTAGE | | |
| <input checked="" type="checkbox"/> | Check if there is a shared raceway between AFC Panel and Kiosk and identify additional source panels to be de-energized. | Do AFC Panel loads feed into a shared raceway e.g. trench or trough? If Yes, specify source panels in notes. NO | | |
| <input checked="" type="checkbox"/> | Identify the assumed pathway of duct / conduit, the location of the handholes, manholes and boxes and accessibility or special escort requirement? | PLNT <input type="checkbox"/> COMM / IT <input type="checkbox"/> ELES <input type="checkbox"/> RAIL <input type="checkbox"/> CMNT <input type="checkbox"/> Other Access/Support: | | One handhole in corridor at mezzanine level (cover loose) |
| <input checked="" type="checkbox"/> | Identify handhole or manhole access requirement. | Required PLNT Mason for handhole/manhole access? NO Identified Conduit/Duct Transition to mezzanine level? YES | | Conduit/duct transition on multiple levels |

| Emergency Power Verification | | | | |
|-------------------------------------|--|--|----------------------|-------|
| Check | Task | Equipment | Room ID | Notes |
| <input checked="" type="checkbox"/> | Verify if AFC electrical panel is connected to an Automatic Transfer Switch (ATS). | ATS Name/Number: | | |
| <input checked="" type="checkbox"/> | Verification of Kiosk Emergency Panel(s) (KE, KES, KESS, etc) | Source Panel Name/Number: SEL Source Breaker Name/Number: Breaker #2 Panel Name/Number: KE | C111 C11 Kiosk | |


| | | |
|---------------------------------|---|-------------------|
| Notes and Discrepancies: | | |
| Sign Off | GFP Representative | WMATA PRGM |
| Name: | Tino Sahoo | |
| Signature: |  | |
| Date: | 10/07/2014 | |

Photo #1: C12 Braddock Road – Mezzanine area

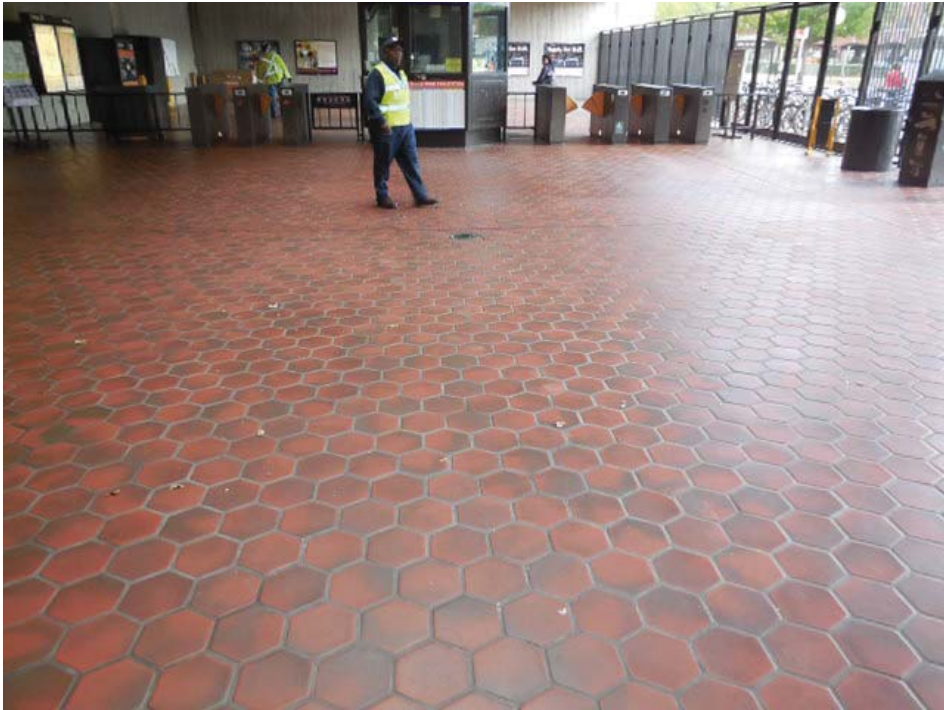


Photo #2: C12 Braddock Road – Handhole in Mezzanine area



Photo #3: C12 Braddock Road – Handhole in corridor



Photo #4: C12 Braddock Road – Ducts to Bottom of Panel F in Room C111



Photo #5: C12 Braddock Road – Panel F in Room C111


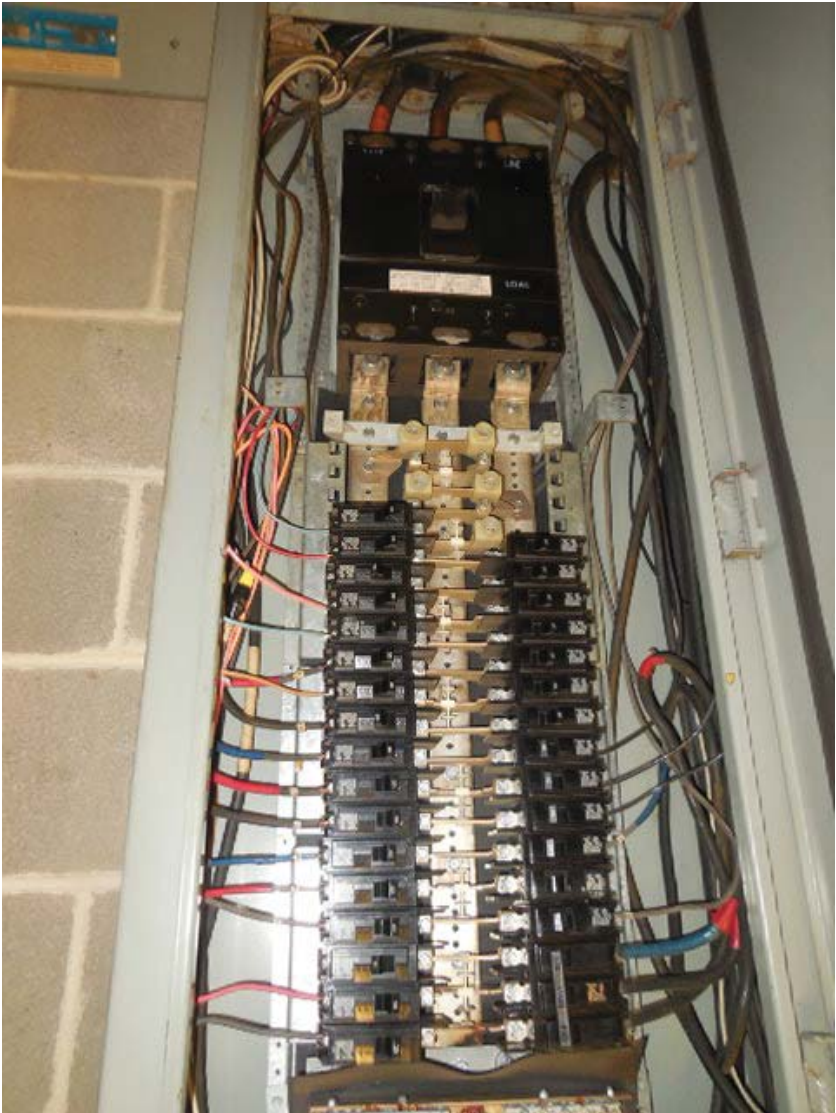


Photo #6: C12 Braddock Road – Panel F schedule in Room C111


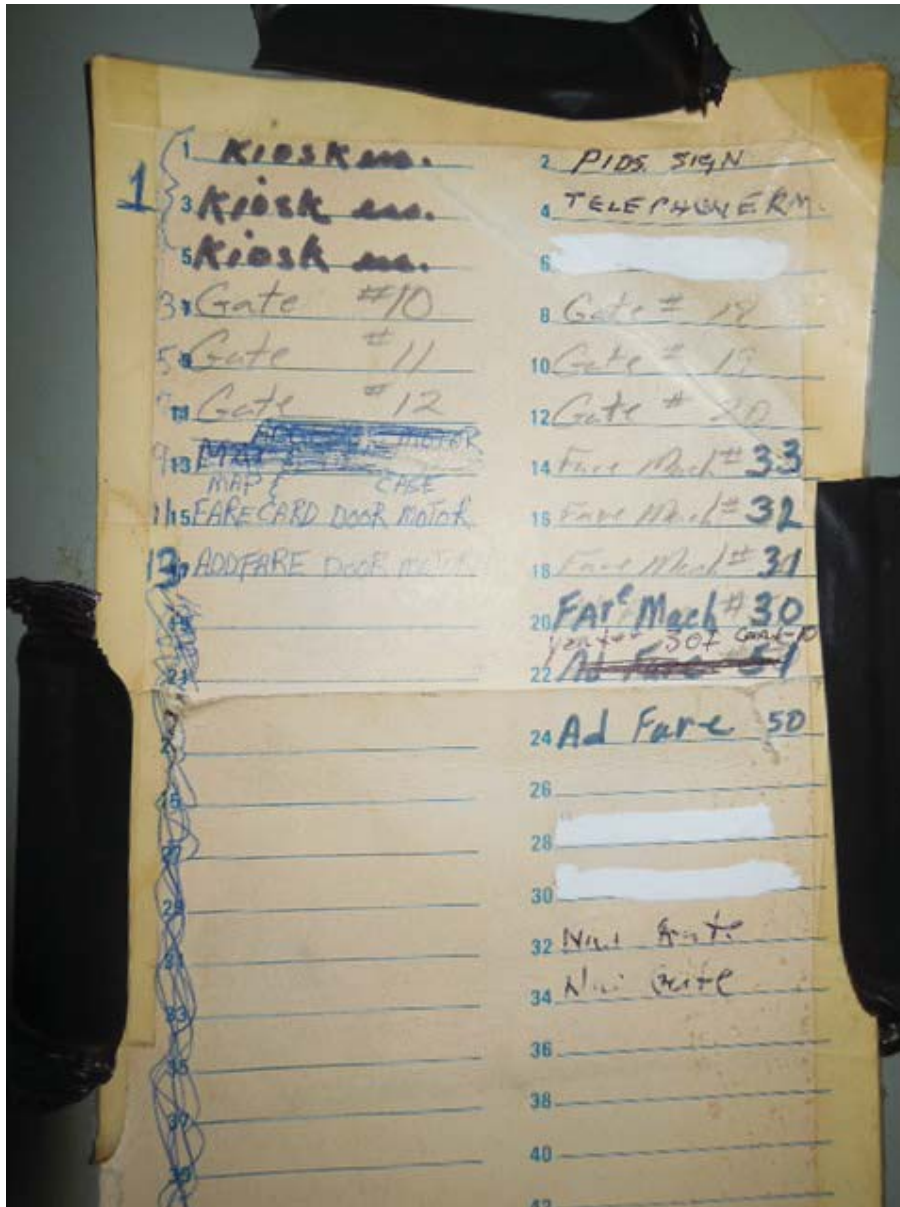


NOTES

1. THE MINIMUM OPERATIONAL MACHINE INVENTORY IS REFERENCED ON THIS DRAWING BY THE "X" DRAWN THROUGH THE MACHINE.
2. FOR REFERENCE DRAWINGS USED SEE SUPPORT DOCUMENTATION PACKAGE FOR THIS MEZZANINE.


⊳ (X) INDICATES POSITION NO. [X] INDICATES AISLE NO.

Pre-inspection Field Verification
10/7/2014

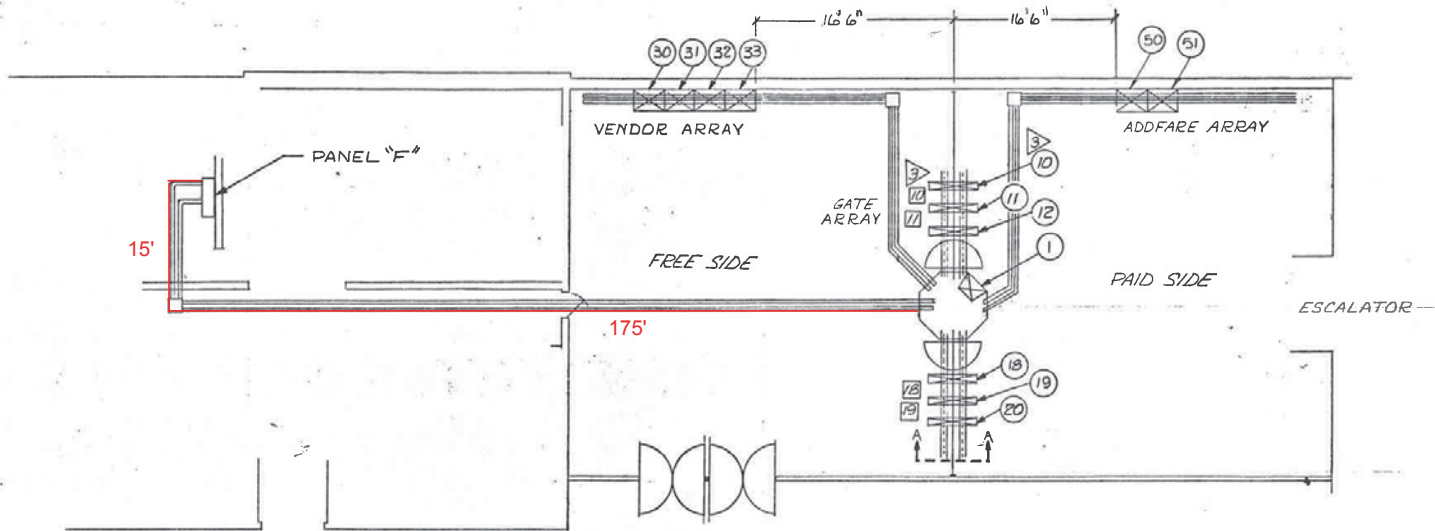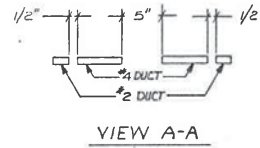

| PANEL F | | | | | |
|--------------|--------------|------------|---------------------|---------------------|-----------------|
| POSITION NO. | MACHINE TYPE | SERIAL NO. | CIRCUIT BREAKER NO. | BREAKER SIZE (AMPS) | WIRE SIZE (AWG) |
| 1 | DADS | DS 8070 | KIOSK | 20 | |
| 10 | EXIT GATE | GX 4074 | 7 | 20 | 6 |
| 11 | REV GATE | GR 7263 | 9 | 20 | 6 |
| 12 | A GATE | GA 5048 | 11 | 20 | 6 |
| 18 | B GATE | GB 6055 | 8 | 20 | 6 |
| 19 | REV GATE | GR 7255 | 10 | 20 | 6 |
| 20 | ENTRY GATE | GN 3073 | 12 | 20 | 6 |
| 30 | VENDOR | FV 1315 | 20 | 20 | 8 |
| 31 | VENDOR | FV 1328 | 18 | 20 | 8 |
| 32 | VENDOR | FV 1338 | 16 | 20 | 8 |
| 33 | VENDOR | FV 1327 | 14 | 20 | 8 |
| 50 | ADDFARE | AM 2132 | 24 | 20 | 8 |
| 51 | ADDFARE | AM 2125 | 22 | 20 | 8 |

- 1 INSTALLATION PLAN

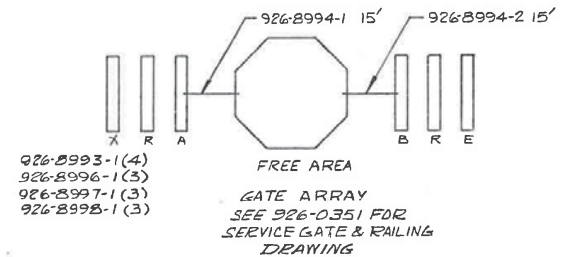

DO NOT SCALE DRAWING
UNLESS OTHERWISE SPECIFIED
DIMENSIONS ARE IN INCHES
DECIMALS: 1/16" 0.0625" 1/8" 0.125" 3/16" 0.1875" 1/4" 0.25" 5/16" 0.3125" 3/8" 0.375" 7/16" 0.4375" 1/2" 0.5" 9/16" 0.5625" 5/8" 0.625" 11/16" 0.6875" 3/4" 0.75" 13/16" 0.8125" 7/8" 0.875" 15/16" 0.9375" 1" 1.0000"

CONTRACT NUMBER
D A1
DRAWING NUMBER
926-0420
SHEET 1 OF 1

TITLE
INSTALLATION PLAN
BADDOCK BRAD STATION

CODE IDENT NO.
94987

D 926-0420-5

Pre-inspection Field Verification
10/7/2014

| EXISTING PANEL "F" ✓ | | | | | | | | | | |
|---------------------------------|-----|-----|------------------|----------|----------|------------------------------|-----|------------------|-----|-----------------|
| AMPERES: 225 | | | VOLTAGE: 120/208 | | | MOUNTING: SURFACE | | | | |
| WANS: 225AMCB | | | PHASE: 3 | | | LOCATION: AC SWBD RM. C111 ✓ | | | | |
| RATING: 10KAC | | | WIRE: 4 | | | SECTION: 1 OF 1 | | | | |
| LOAD DESCRIPTION | KVA | AMP | POLE | CKT. NO. | CKT. NO. | CKT. AMP | KVA | LOAD DESCRIPTION | | |
| EXIST. LOAD CENTER "YES" | 2.0 | 20 | 3 | 1 | A - | 2 | 1 | 20 | 0.0 | EXISTING VENDOR |
| | 2.5 | - | - | 3 | - B - | 4 | 1 | 20 | 0.0 | EXISTING VENDOR |
| | | | | 5 | - - C | 8 | 1 | 30 | 0.0 | SPARE |
| EXISTING VENDOR | 0.0 | 30 | 1 | 7 | A - | 8 | 1 | 20 | 0.0 | EXISTING VENDOR |
| SPARE | 0.0 | 20 | 1 | 9 | - B - | 10 | 1 | 20 | 0.0 | EXISTING VENDOR |
| EXISTING VENDOR | 0.0 | 20 | 1 | 11 | - - C | 12 | 1 | 20 | 0.0 | EXISTING VENDOR |
| EXISTING VENDOR | 0.0 | 20 | 1 | 13 | A - | 14 | 1 | 20 | 0.0 | EXISTING VENDOR |
| EXISTING VENDOR | 0.0 | 20 | 1 | 15 | - B - | 16 | 1 | 20 | 0.0 | EXISTING VENDOR |
| EXISTING VENDOR | 0.0 | 20 | 1 | 17 | - - C | 18 | 1 | 20 | 0.0 | EXISTING VENDOR |
| 1 NEW KNOBK RECEPT. (IT & NEPP) | 0.0 | 20 | 1 | 19 | A - | 20 | 1 | 20 | 0.0 | EXISTING VENDOR |
| 1&2 SPARE (KNOBK) | 0.0 | 20 | 1 | 21 | - B - | 22 | 1 | 20 | 0.0 | EXISTING VENDOR |
| SPARE | 0.0 | 20 | 1 | 23 | - - C | 24 | 1 | 20 | 0.0 | EXISTING VENDOR |
| SPARE | 0.0 | 20 | 1 | 25 | A - | 26 | 1 | 20 | 0.0 | EXISTING VENDOR |
| SPARE | 0.0 | 20 | 1 | 27 | - B - | 28 | 1 | 20 | 0.0 | EXISTING VENDOR |
| SPARE | 0.0 | 20 | 1 | 29 | - - C | 30 | 1 | 20 | 0.0 | SPARE |
| SPACE | 0.0 | - | - | 31 | A - | 32 | 1 | 20 | 0.0 | EXISTING VENDOR |
| SPACE | 0.0 | - | - | 33 | - B - | 34 | 1 | 20 | 0.0 | EXISTING VENDOR |
| SPACE | 0.0 | - | - | 35 | - - C | 36 | - | - | 0.0 | SPACE |
| SPACE | 0.0 | - | - | 37 | A - | 38 | - | - | 0.0 | SPACE |
| SPACE | 0.0 | - | - | 39 | - B - | 40 | - | - | 0.0 | SPACE |
| SPACE | 0.0 | - | - | 41 | - - C | 42 | - | - | 0.0 | SPACE |

NOTES: 1. CONNECT NEW FEEDER TO EXISTING SPARE 20A, 1 PCB
2. CB TO BE RESERVED FOR FUTURE A/F

LOAD SUMMARY

| | | |
|-------------------------------------|-----------------|----------------------------------|
| LIGHTS | 0.0 x 125% | 0.0 KVA |
| RECEPTACLES, FIRST 10 KVA | 10.0 x 100% | 10.0 KVA |
| RECEPTACLES | 0.0 x 50% | 4.0 KVA |
| MISC. APPLIANCES | 0.0 x 100% | 0.0 KVA |
| LARGEST MOTOR | 0.0 x 125% | 0.0 KVA |
| MOTORS | 0.0 x 100% | 0.0 KVA |
| HEAT | 3.0 x 125% | 3.8 KVA |
| AC | 4.5 x 100% | 4.5 KVA |
| WATER HEATING | 0.0 x 125% | 0.0 KVA |
| TOTAL CONNECTED LOAD | 20.0 KVA | TOTAL DEMAND KVA 22.5 KVA |
| | | TOTAL DEMAND AMP 61.8 AMP |
| CONNECTED LOAD PHASE SUMMARY | | |
| PHASE A: | 10.1 KVA | |
| PHASE B: | 8.1 KVA | |
| PHASE C: | 7.3 KVA | |

NOTES: A. EXISTING PANEL "F" IS FED FROM 277/480V, 3ø, 4W EXISTING SWBD. "F2" LOCATED IN AC SWBD RM. C111, -CIRCUIT-
#1-125/3P VIA 75KVA TRANSFORMER (SEE ATTACHED DWG. MM-C-E23).
B. EXISTING WIRING FED FROM BOTTOM OF PANEL BY:
* 2-6 1/2"x 1 1/2" FLOOR DUCT (1-WIRING FILL >40%)(1-WIRING FILL >20%).
EXISTING WIRING FED FROM LEFT SIDE OF PANEL BY:
* 1-4" C. TO TRANSFORMER (WIRING FILL >40%).
EXISTING WIRING FED FROM TOP OF PANEL BY:
* 1-#12 WIRING.

Breaker "Panel F"
(Breaker #1) - 125/3P

CONTRACT No
14-FQ10060-CENI-24

| DESIGNED: C. HED | DATE: 08-14 | REFERENCE DRAWINGS | | REVISIONS | |
|------------------|-------------|--------------------|-------------|-----------|----|
| | | NUMBER | DESCRIPTION | DATE | BY |
| DRAWN: C. HED | DATE: 08-14 | | | | |
| CHECKED: B. HED | DATE: 08-14 | | | | |
| APPROVED: N/A | DATE: | | | | |


WASHINGTON METROPOLITAN AREA TRANSIT AUTHORITY
DEPARTMENT OF TRANSIT INFRASTRUCTURE AND ENGINEERING SERVICES
OFFICE OF INFRASTRUCTURE RENEWAL PROGRAM

GFP A General Financial Partners JOINT VENTURE

APPROVED _____ SUBMITTED _____ PROJECT MANAGER

NEW ELECTRONIC PAY PROGRAM (NEPP)
IN METRO RAIL STATIONS
BRADDOCK ROAD
PANEL SCHEDULE

SCALE: NOT TO SCALE
DRAWING NO: C12-E-102

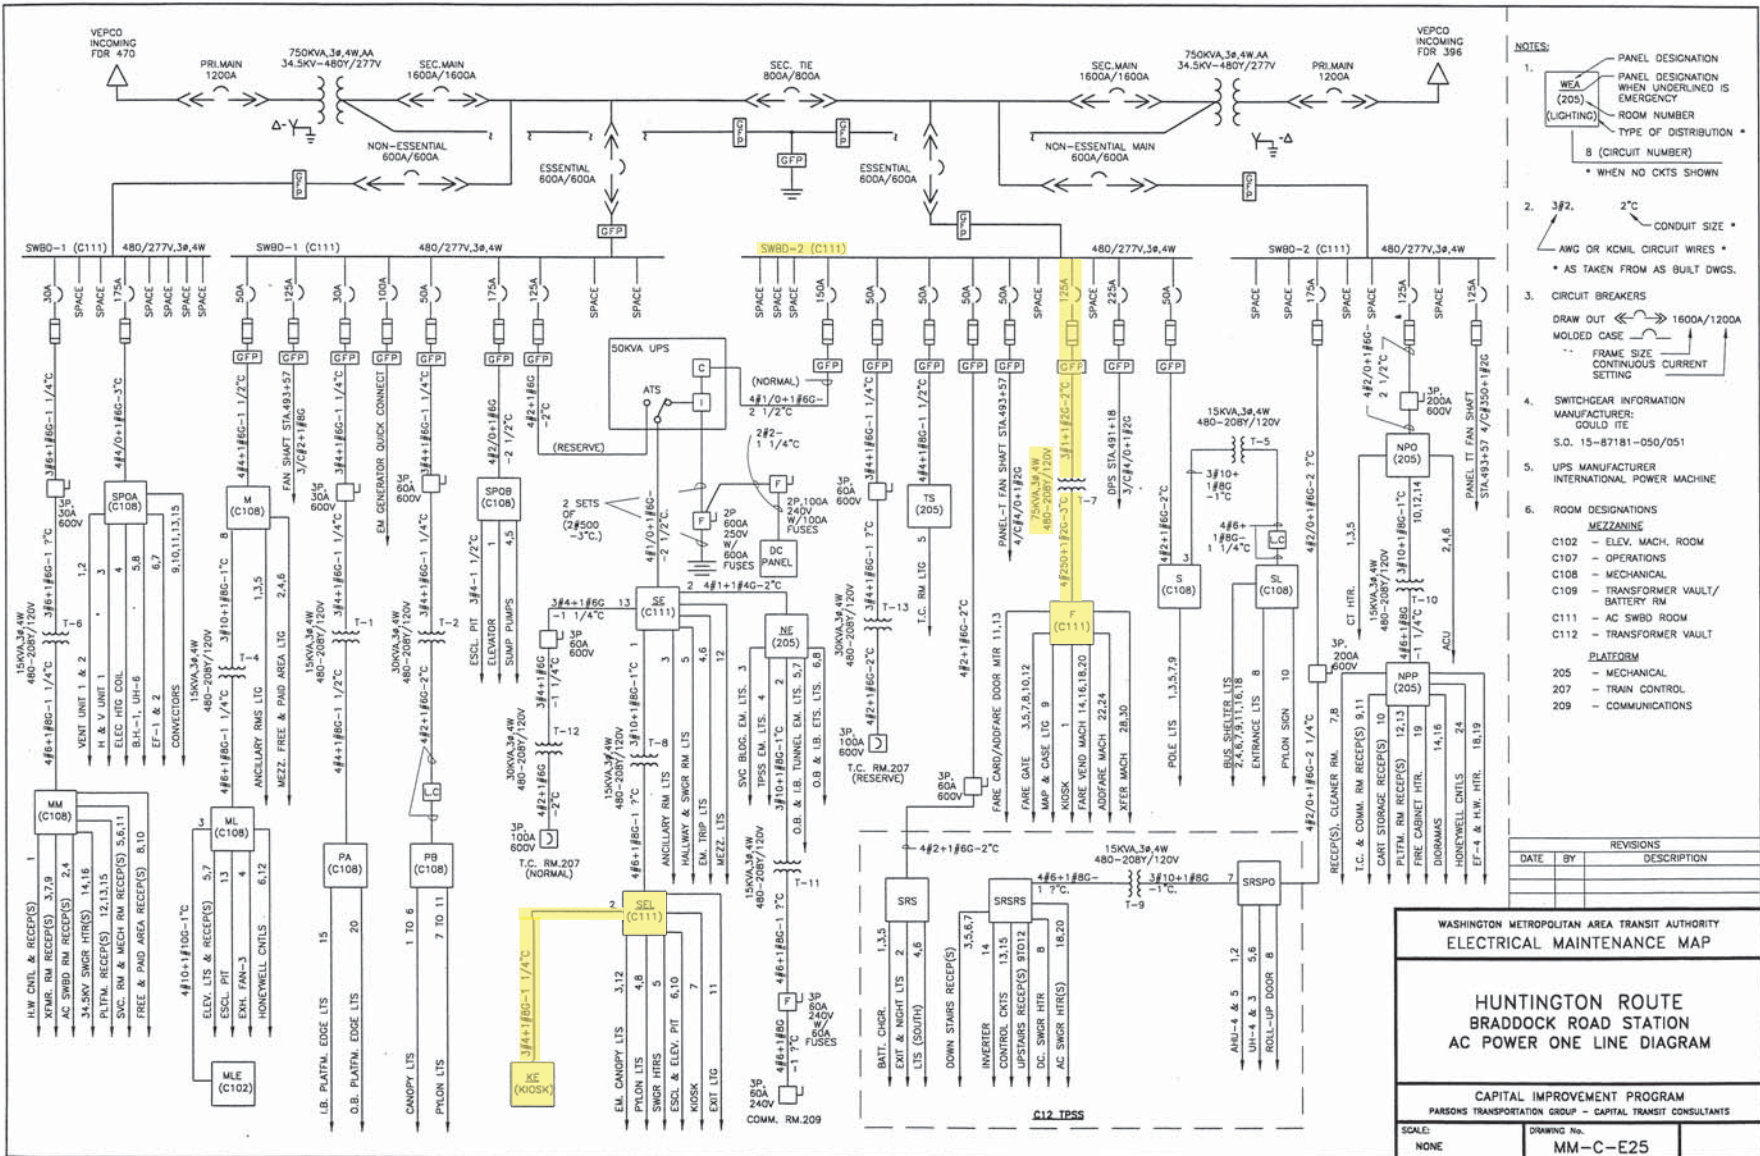

Pre-inspection Field Verification 10/7/2014

Pre-Inspection Mezzanine Walkthrough Checklist

| | | | |
|-------------------------|--|------------------------|---------------------------------|
| Date: 10/07/2014 | Station Name: C13 King Street (South) | Mezzanine # 048 | Completed By: Tino Sahoo |
|-------------------------|--|------------------------|---------------------------------|

| Check | Task | Equipment | Room ID | Notes |
|-------------------------------------|--|--|------------------------------|--|
| <input checked="" type="checkbox"/> | Verify electrical power design matches the field/record. Identify locations of the electrical equipment. | Electrical Source Panel Name/Number: Essential Main B (AFC) EL (Kiosk Emergency) Source Breaker Name/Number: Ckt. #7: "Panel F1 & F2" (AFC), Ckt. #1 (KE) Electrical AFC Panel Name/Number: F1 and F2 / KE | C103 C103 C103 | Emergency Circuit: Source Panel EL, Circuit #1 to de-energize KE (Kiosk) Panel |
| <input checked="" type="checkbox"/> | Is there a disconnect switch connected to the AFC electrical power panel? Low or High voltage SMNT/POWR escorts required? | Disconnect Name/Number: N/A SMNT/POWR escorts: HIGH AND LOW VOLTAGE | | High and Low Voltage escorts are required |
| <input checked="" type="checkbox"/> | Check if there is a shared raceway between AFC Panel and Kiosk and identify additional source panels to de-energize | Do AFC Panel loads feed into a shared raceway e.g. trench or trough? If Yes, specify source panels in notes. NO | | |
| <input checked="" type="checkbox"/> | Identify the assumed pathway of the duct, the location of the handholes, manholes and boxes and accessibility or special escort requirement? | PLNT <input checked="" type="checkbox"/> COMM / IT <input type="checkbox"/> ELES <input type="checkbox"/> RAIL <input type="checkbox"/> CMNT <input type="checkbox"/> Other Access/Support: AFC | | |
| <input checked="" type="checkbox"/> | Identify handhole or manhole access requirement. | Required PLNT Support for handhole/manhole access? YES (see notes) Identified Conduit/Duct Transition to mezzanine level? YES | | All conduits and ducts are on one level. Over 200' run. |

Emergency Power Verification

| Check | Task | YES | NO | NA | Comments |
|-------------------------------------|--|--------------------------|--------------------------|-------------------------------------|----------|
| <input checked="" type="checkbox"/> | Verification of the electrical plan to the existing schematic if the AFC electrical panel is connected to a Automatic Transfer Switch (ATS) / emergency power source | <input type="checkbox"/> | <input type="checkbox"/> | <input checked="" type="checkbox"/> | |

Notes and Discrepancies:

| | | |
|-------------------|---------------------------|-------------------|
| Sign Off | GFP Representative | WMATA PRGM |
| Name: | Tino Sahoo | |
| Signature: | | |
| Date: | 10/7/14 | |

Photo #1: C13 King Street (South) – Kiosk at mezzanine level



Photo #2: C13 King Street (South) – Free Side of Mezzanine level, presumed path of power duct

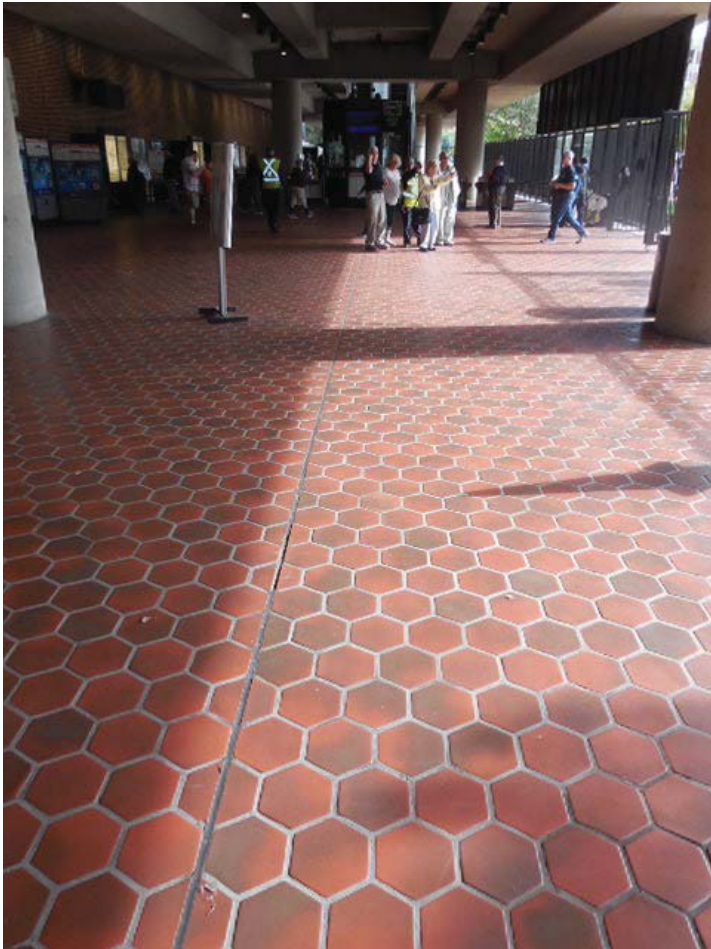


Photo #3: C13 King Street (South) – Handholes in mezzanine floor



Photo #4: C13 King Street (South) – Handholes in mezzanine floor



Photo #5: C13 King Street (South) – Mini-mezzanine mezzanine area



Photo #6: C13 King Street (South) – Mini-mezzanine mezzanine faregate array and floor handhole



Photo #7: C13 King Street (South) – Handhole in mezzanine floor



Photo #8: C13 King Street (South) – Switchboard circuit label for Panels F1 and F2



Photo #9: C13 King Street (South) – Ducts and conduits into panels F1 and F2 in Room C103



Photo #10: C13 King Street (South) – Panel F1 in Room C103



Photo #11: C13 King Street (South) – Schedule of Panel F1 in Room C103

| PANEL F-1 MACHINES | | FEED FROM |
|--------------------|--|--------------------------|
| 1 | FARE VEND MACH SMART CARD MACH | 22 FUT FARE VEND MACH |
| 2 | FARE VEND MACH SPACE | 23 KIOSK LTG ✓ |
| 3 | FARE VEND MACH SPACE | 24 HEAT TRACING ✓ |
| 4 | FARE VEND MACH | 25 KIOSK RECEIPT ✓ |
| 5 | FARE VEND MACH | 26 SPARE |
| 6 | FARE VEND MACH | 27 SPARE |
| 7 | FARE VEND MACH mech Demand 7/30/06 | 28 SPARE |
| 8 | FARE VEND MACH removed 7-20-08 | 29 SPARE |
| 9 | FARE VEND MACH | 30 SPARE |
| 10 | FARE VEND MACH | 31 SPACE |
| 11 | FARE VEND MACH | 32 SPACE |
| 12 | FARE VEND MACH | 33 |
| 13 | FARE VEND MACH | 34) Smart Trip Vending M |
| 14 | FARE VEND MACH | 35) Smart Trip Machine |
| 15 | FARE VEND MACH | 36 |
| 16 | FARE VEND MACH | 37 |
| 17 | FUT FARE VEND MACH | 38 |
| 18 | FUT FARE VEND MACH | 39 |
| 19 | FUT FARE VEND MACH | 40 |
| 20 | FUT FARE VEND MACH | 41 |
| 21 | FUT FARE VEND MACH | 42 |

D INC PC. NO. 12 1110-01 30 CRKT ON BACK

Photo #12: C13 King Street (South) – Panel F2 in Room C103



Photo #13: C13 King Street (South) – Schedule of Panel F2 in Room C103

| PANEL F-2 | | FED FROM |
|-----------|--|----------------------------|
| ✓ | FARE VEND MACH ^{GR 10} 22 | KIOSK HAC Panel |
| 2 | FARE VEND MACH ^{GR 18} 23 | FUT FARE VEND MACH |
| 3 | FARE VEND MACH ^{GR 11} 24 | KIOSK HAC Panel |
| 4 | FARE VEND MACH GR 10 25 | SPARE |
| 5 | FARE VEND MACH ^{GR 12} 26 | SPARE |
| 6 | FARE VEND MACH ^{GR 20} 27 | SPARE |
| 7 | FARE COLL MACH ^{GR 13} 28 | SPARE ^{AM 51} ? |
| 8 | FARE VEND MACH ^{GR 21} 29 | SUMP PUMP |
| 9 | FARE COLL MACH ^{GR 14} 30 | SPARE ^{AM 50} ? |
| 10 | FARE VEND MACH ^{GR 15} 31 | SPACE |
| 11 | FARE COLL MACH ^{GR 15} 32 | SPACE |
| ✓ | FARE VEND MACH ^{GR 23} 33 | SPACE |
| x | FARE COLL MACH ^{EXHAUST FAN} 34 | SPACE |
| 14 | TRANSFER MACH 35 | SPACE |
| k | FARE COLL MACH ^{OUTLET} 36 | SPACE |
| 16 | FARE VEND MACH ^{TRANSFER MACH} 37 | |
| 17 | FUT FARE VEND MACH 38 | |
| 18 | FUT FARE VEND MACH 39 | |
| 19 | FUT FARE VEND MACH 40 | |
| 20 | KIOSK HAC Panel 41 | |
| 21 | FUT FARE VEND MACH 42 | |

GOULD INC.



PC. NO. 12-1110.01

30 CRKT ON BACK

NOTES:


1. THE MINIMUM OPERATIONAL MACHINE INVENTORY IS REFERENCED ON THIS DRAWING BY THE "X" DRAWN THROUGH THE MACHINE.
 2. FOR REFERENCE DRAWINGS USED SEE SUPPORT DOCUMENTATION PACKAGE FOR THIS MEZZANINE.
- ③ (X) INDICATES POSITION NO. (X) INDICATES AISLE NO.

Pre-inspection Field Verification
10/7/2014

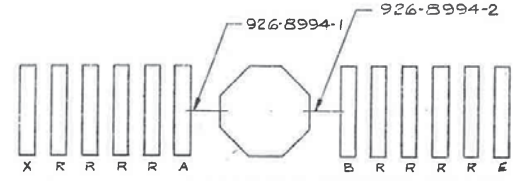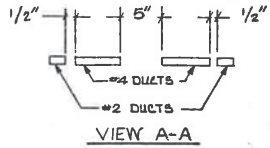

GATE ARRAY ROTATED 90° CCW
SEE 926-0361 FOR SERVICE
GATE & RAILING DRAWING
FREE AREA

- 926-8998-1 (9)
- 926-8996-1 (9)
- 926-8997-1 (9)
- 926-8993-1 (10)

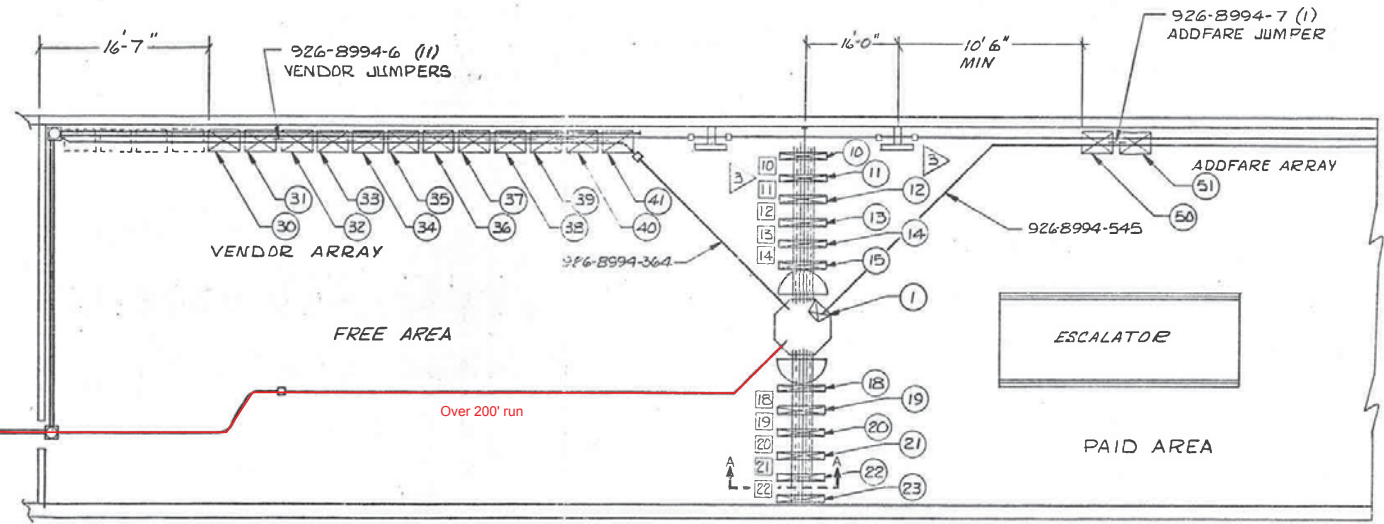

DN. TO A.C. SW6R. RM.

Over 200' run

| PANEL F1 | | | | | |
|--------------|--------------|------------|---------------------|---------------------|-----------------|
| POSITION NO. | MACHINE TYPE | SERIAL NO. | CIRCUIT BREAKER NO. | BREAKER SIZE (AMPS) | WIRE SIZE (AWG) |
| 1 | DADS | 8072 | KIOSK | 20 | 10 |
| 10 | EXIT GATE | GX 4066 | | 20 | 10 |
| 11 | REV GATE | GR 7267 | | 20 | 10 |
| 12 | REV GATE | GR 7269 | | 20 | 10 |
| 13 | REV GATE | GR 7307 | | 20 | 10 |
| 14 | REV GATE | GR 7306 | | 20 | 10 |
| 15 | A GATE | GA 5049 | | 20 | 10 |
| 16 | B GATE | GB 6048 | | 20 | 10 |
| 19 | REV GATE | GR - 7268 | | 20 | 10 |
| 20 | REV GATE | GR - 7271 | | 20 | 10 |
| 21 | REV GATE | GR - 7270 | | 20 | 10 |
| 22 | REV GATE | GR - 7272 | | 20 | 10 |
| 30 | VENDOR | FV - 1047 | | 20 | 8 |
| 31 | VENDOR | FV - 1331 | | 20 | 8 |
| 32 | VENDOR | FV - 1317 | | 20 | 8 |
| 33 | VENDOR | FV - 1330 | | 20 | 8 |
| 34 | VENDOR | FV - 1324 | | 20 | 8 |
| 35 | VENDOR | FV - 1332 | | 20 | 8 |
| 36 | VENDOR | FV - 1310 | | 20 | 8 |
| 37 | VENDOR | FV - 1333 | | 20 | 8 |
| 38 | VENDOR | FV - 1325 | | 20 | 8 |
| 39 | VENDOR | FV - 1318 | | 20 | 6 |
| 40 | VENDOR | FV - 1291 | | 20 | 6 |
| 41 | VENDOR | FV - 1326 | | 20 | 6 |
| 50 | ADDFARE | AM - 2174 | | 20 | 6 |
| 51 | ADDFARE | AM - 2119 | | 20 | 6 |
| 23 | ENTRY | GN - 3075 | | 20 | 10 |

-1 INSTALLATION PLAN

REDRAWN 7-27-82
BY J. ETHERIDGE

DO NOT SCALE DRAWING

UNLESS OTHERWISE SPECIFIED DIMENSIONS ARE IN INCHES

DATE: 11/13/02

CONTRACT NUMBER: D 81

DRAWING NUMBER: 926-0418

SHEET 1 OF 1

TITLE: INSTALLATION PLAN
KING STREET STATION

CODE IDENT. NO. 94987

926-0418 (48)

| EXISTING PANEL "F1" ✓ | | | | | | | | | | | | | | |
|-------------------------------|-----|-----|----------------|---------|-------|------------------------------|------------------|----------|-----|-----------------|------------------|--|--|--|
| AMPERES: 150 | | | VOLTS: 120/208 | | | MOUNTING: SURFACE | | | | | | | | |
| MAINS: 150AMCB | | | PHASE: 3 | | | LOCATION: AC SWBD RM. C103 ✓ | | | | | | | | |
| RATING: 10K AC | | | WIRE: 4 | | | SECTION: 1 OF 1 | | | | | | | | |
| LOAD DESCRIPTION | KVA | AMP | POLE | CKT NO. | | KVA | LOAD DESCRIPTION | CKT BKRS | | KVA | LOAD DESCRIPTION | | | |
| | | | | NO. | POLE | | | NO. | AMP | | | | | |
| EXISTING VENDOR | 0.8 | 20 | 1 | 1 | A - - | 2 | 1 | 20 | 0.0 | SPARE | | | | |
| EXISTING VENDOR | 0.8 | 20 | 1 | 3 | - B - | 4 | 1 | 20 | 0.0 | SPARE | | | | |
| EXISTING VENDOR | 0.8 | 20 | 1 | 5 | - - C | 6 | 1 | 20 | 0.0 | SPARE | | | | |
| NEW KIOSK RECEPT. (IT & NEPP) | 0.8 | 20 | 1 | 7 | A - - | 8 | 1 | 20 | 0.8 | EXISTING VENDOR | | | | |
| SPARE (KIOSK) | 0.0 | 20 | 1 | 9 | - B - | 10 | 1 | 20 | 0.8 | EXISTING VENDOR | | | | |
| EXISTING VENDOR | 0.8 | 20 | 1 | 11 | - - C | 12 | 1 | 20 | 0.8 | EXISTING VENDOR | | | | |
| SPARE | 0.0 | 20 | 1 | 13 | A - - | 14 | 1 | 20 | 0.0 | SPARE | | | | |
| SPARE | 0.0 | 20 | 1 | 15 | - B - | 16 | 1 | 20 | 0.0 | SPARE | | | | |
| EXISTING VENDOR | 0.8 | 20 | 1 | 17 | - - C | 18 | 1 | 20 | 0.8 | EXISTING VENDOR | | | | |
| EXISTING VENDOR | 0.8 | 20 | 1 | 19 | A - - | 20 | 1 | 20 | 0.8 | EXISTING VENDOR | | | | |
| EXISTING VENDOR | 0.8 | 20 | 1 | 21 | - B - | 22 | 1 | 20 | 0.8 | EXISTING VENDOR | | | | |
| EXISTING VENDOR | 0.8 | 20 | 1 | 23 | - - C | 24 | 1 | 20 | 0.8 | EXISTING VENDOR | | | | |
| EXISTING VENDOR | 0.8 | 20 | 1 | 25 | A - - | 26 | 1 | 20 | 0.8 | EXISTING VENDOR | | | | |
| SPARE | 0.0 | 20 | 1 | 27 | - B - | 28 | 1 | 20 | 0.8 | EXISTING VENDOR | | | | |
| SPARE | 0.0 | 20 | 1 | 29 | - - C | 30 | 1 | 20 | 0.0 | SPACE | | | | |
| SPACE | 0.0 | - | - | 31 | A - - | 32 | - | - | 0.0 | SPACE | | | | |
| SPACE | 0.0 | - | - | 33 | - B - | 34 | - | - | 0.0 | SPACE | | | | |
| SPACE | 0.0 | - | - | 35 | - - C | 36 | - | - | 0.0 | SPACE | | | | |

NOTES: 1. CONNECT NEW FEEDER TO EXISTING SPARE 20A, 1P CB
2. CB TO BE RESERVED FOR FUTURE AFC

| LOAD SUMMARY | | | |
|---------------------------|-------------|-------------------|-----------|
| LIGHTS | 0.0 x 125% | | 0.0 KVA |
| RECEPTACLES, FIRST 10 KVA | 10.0 x 100% | | 10.0 KVA |
| RECEPTACLES | 5.2 x 50% | | 2.8 KVA |
| MISC APPLIANCES | 0.0 x 100% | | 0.0 KVA |
| LARGEST MOTOR | 0.0 x 125% | | 0.0 KVA |
| MOTORS | 0.0 x 100% | | 0.0 KVA |
| HEAT | 0.0 x 125% | | 0.0 KVA |
| AC | 5.0 x 100% | | 0.0 KVA |
| WATER HEATING | 0.0 x 125% | | 0.0 KVA |
| TOTAL CONNECTED LOAD | 16.2 KVA | TOTAL DEMAND KVA | 12.8 KVA |
| | | TOTAL DEMAND AMPS | 38.0 AMPS |

| CONNECTED LOAD PHASE SUMMARY | |
|------------------------------|---------|
| PHASE A: | 5.8 KVA |
| PHASE B: | 4.0 KVA |
| PHASE C: | 5.8 KVA |

NOTES: A. EXISTING PANEL "F1" IS FED FROM 277/480V, 3Ø, 4W EXISTING SWBD, "ESSENTIAL MAIN B" LOCATED IN AC SWBD C103, CIRCUIT #7-175/3P VIA 112KVA TRANSFORMER (SEE ATTACHED DWG. MM-C-E26).
B. EXISTING WIRING FED FROM TOP OF PANEL BY:
* 1-6 1/2" x 1 1/2" BUS DUCT (WIRING FILL >40%).
* 2-3/4" C. (WIRING FILL >40%).
EXISTING WIRING FED FROM BOTTOM OF PANEL BY:
* 1-C" C. TO WIRE TROUGH (WIRING FILL >40%).

| EXISTING PANEL "F2" ✓ | | | | | | | | | | | | | | |
|-------------------------------|-----|-----|----------------|---------|-------|-------------------------------------|------------------|----------|-----|--------------------------|------------------|--|--|--|
| AMPERES: 150 | | | VOLTS: 120/208 | | | MOUNTING: SURFACE | | | | | | | | |
| MAINS: 150AMCB | | | PHASE: 3 | | | LOCATION: AC SWBD BATTERY RM C103 ✓ | | | | | | | | |
| RATING: 10K AC | | | WIRE: 4 | | | SECTION: 1 OF 1 | | | | | | | | |
| LOAD DESCRIPTION | KVA | AMP | POLE | CKT NO. | | KVA | LOAD DESCRIPTION | CKT BKRS | | KVA | LOAD DESCRIPTION | | | |
| | | | | NO. | POLE | | | NO. | AMP | | | | | |
| EXISTING VENDOR | 0.8 | 20 | 1 | 1 | A - - | 2 | 1 | 20 | 0.8 | EXISTING VENDOR | | | | |
| EXISTING VENDOR | 0.8 | 20 | 1 | 3 | - B - | 4 | 1 | 20 | 0.8 | EXISTING VENDOR | | | | |
| EXISTING VENDOR | 0.8 | 20 | 1 | 5 | - - C | 6 | 1 | 20 | 0.8 | EXISTING VENDOR | | | | |
| EXISTING VENDOR | 0.8 | 20 | 1 | 7 | A - - | 8 | 1 | 20 | 0.8 | EXISTING VENDOR | | | | |
| EXISTING VENDOR | 0.8 | 20 | 1 | 9 | - B - | 10 | 1 | 20 | 0.8 | EXISTING VENDOR | | | | |
| EXISTING VENDOR | 0.8 | 20 | 1 | 11 | - - C | 12 | 1 | 20 | 0.8 | EXISTING VENDOR | | | | |
| EXISTING VENDOR | 0.8 | 20 | 1 | 13 | A - - | 14 | 1 | 20 | 0.0 | SPARE | | | | |
| EXISTING VENDOR | 0.8 | 20 | 1 | 15 | - B - | 16 | 1 | 20 | 0.8 | EXISTING VENDOR | | | | |
| EXISTING VENDOR | 0.8 | 20 | 1 | 17 | - - C | 18 | 1 | 20 | 0.8 | EXISTING VENDOR | | | | |
| NEW KIOSK RECEPT. (IT & NEPP) | 0.8 | 20 | 1 | 17 | - - C | 18 | 1 | 20 | 0.8 | EXISTING VENDOR | | | | |
| SPARE (KIOSK) | 0.0 | 20 | 1 | 19 | A - - | 20 | 1 | 20 | 2.0 | EXIST. LOAD CENTER "KES" | | | | |
| SPARE | 0.0 | 20 | 1 | 21 | - B - | 22 | 1 | 20 | 2.5 | | | | | |
| SPARE | 0.0 | 20 | 1 | 23 | - - C | 24 | 1 | 20 | 2.5 | | | | | |
| SPARE | 0.0 | 20 | 1 | 25 | A - - | 26 | 1 | 20 | 0.8 | EXISTING VENDOR | | | | |
| SPARE | 0.0 | 20 | 1 | 27 | - B - | 28 | 1 | 20 | 0.8 | EXISTING VENDOR | | | | |
| SPARE | 0.0 | 20 | 1 | 29 | - - C | 30 | 1 | 20 | 0.0 | SPACE | | | | |
| SPACE | 0.0 | - | - | 31 | A - - | 32 | - | - | 0.0 | SPACE | | | | |
| SPACE | 0.0 | - | - | 33 | - B - | 34 | - | - | 0.0 | SPACE | | | | |
| SPACE | 0.0 | - | - | 35 | - - C | 36 | - | - | 0.0 | SPACE | | | | |

NOTES: 1. CONNECT NEW FEEDER TO EXISTING SPARE 20A, 1P CB
2. CB TO BE RESERVED FOR FUTURE AFC

| LOAD SUMMARY | | | |
|---------------------------|-------------|-------------------|-----------|
| LIGHTS | 0.0 x 125% | | 0.0 KVA |
| RECEPTACLES, FIRST 10 KVA | 10.0 x 100% | | 10.0 KVA |
| RECEPTACLES | 5.0 x 50% | | 2.8 KVA |
| MISC APPLIANCES | 0.0 x 100% | | 0.0 KVA |
| LARGEST MOTOR | 0.0 x 125% | | 0.0 KVA |
| MOTORS | 0.0 x 100% | | 0.0 KVA |
| HEAT | 3.0 x 125% | | 3.8 KVA |
| AC | 4.5 x 100% | | 4.5 KVA |
| WATER HEATING | 0.0 x 125% | | 0.0 KVA |
| TOTAL CONNECTED LOAD | 23.1 KVA | TOTAL DEMAND KVA | 21.1 KVA |
| | | TOTAL DEMAND AMPS | 68.5 AMPS |

| CONNECTED LOAD PHASE SUMMARY | |
|------------------------------|---------|
| PHASE A: | 7.7 KVA |
| PHASE B: | 8.1 KVA |
| PHASE C: | 7.3 KVA |

NOTES: A. EXISTING PANEL "F2" IS FED FROM 277/480V, 3Ø, 4W EXISTING SWBD, "ESSENTIAL MAIN B" LOCATED IN AC SWBD C103, CIRCUIT #7-175/3P VIA 112KVA TRANSFORMER (SEE ATTACHED DWG. MM-C-E26).
B. EXISTING WIRING FED FROM TOP OF PANEL BY:
* 1-6 1/2" x 1 1/2" BUS DUCT (WIRING FILL >40%).
* 1-3/4" C. (WIRING FILL >40%).
EXISTING WIRING FED FROM BOTTOM OF PANEL BY:
* 1-4" C. TO TRANSFORMER (WIRING FILL >40%).

Pre-inspection Field Verification
10/7/2014

CONTRACT NO
14-FQ10060-CENI-24

| DESIGNED: C. HED | DATE: 08-14 | REFERENCE DRAWINGS | | REVISIONS | |
|------------------|-------------|--------------------|-------------|-----------|----|
| | | NUMBER | DESCRIPTION | DATE | BY |
| DRAWN: C. HED | DATE: 08-14 | | | | |
| CHECKED: B. BULL | DATE: 08-14 | | | | |
| APPROVED: N/A | DATE: | | | | |


WASHINGTON METROPOLITAN AREA TRANSIT AUTHORITY
DEPARTMENT OF TRANSIT INFRASTRUCTURE AND ENGINEERING SERVICES
OFFICE OF INFRASTRUCTURE RENEWAL PROGRAM



APPROVED _____ SUBMITTED _____ PROJECT MANAGER


NEW ELECTRONIC PAY PROGRAM (NEPP)
IN METRO-RAIL STATIONS
KING STREET - NORTH & SOUTH
PANEL SCHEDULES

SCALE: NOT TO SCALE
DRAWING NO: C13-E-102

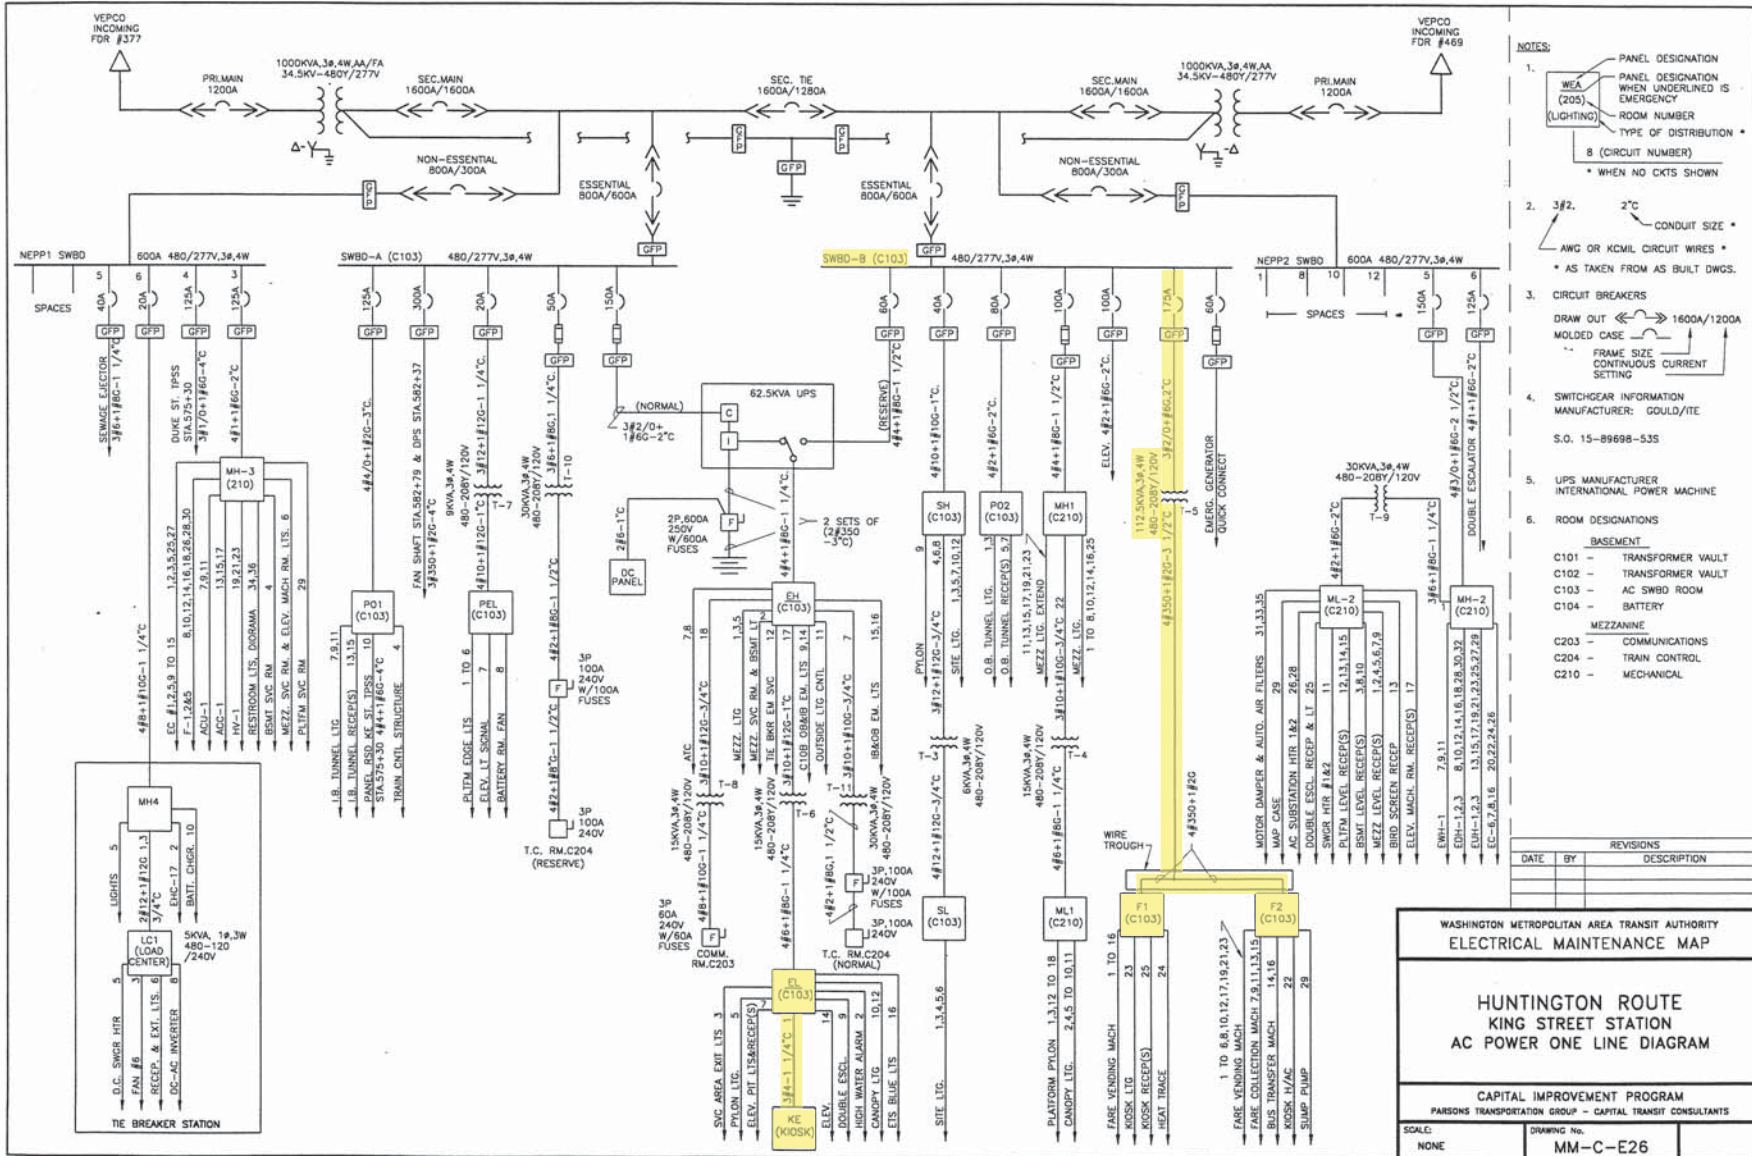

Pre-inspection Field Verification
10/7/2014

Pre-Inspection Mezzanine Walkthrough Checklist

| Date: 01/15/2015 | | Station Name: King Street North - C13 | | Mezzanine #: MZ112 | | Completed By: Tino Sahoo | |
|-------------------------------------|--|--|----------------------|---|-------------------|---------------------------------|--|
| Check | Task | Equipment | Room ID | Notes | | | |
| <input checked="" type="checkbox"/> | Verify that electrical power design matches the field/record. Identify locations of the electrical equipment. | Electrical Source Panel Name/Number: NESS Source Breaker Name/Number: "Panel NF" Electrical AFC Panel Name/Number: NF | N201 N201 N201 | S.O. Request: Source Panel - Panel NES Breaker: Breaker "Trans T-7" Panels Affected: Panel NF, Panel NES, Panel NESS | | | |
| <input checked="" type="checkbox"/> | Verify if disconnect switch is connected to the AFC electrical power panel. Low or High voltage SMNT/POWR escorts requirements? | Disconnect Name/Number: SMNT/POWR escorts: HIGH Voltage | | | | | |
| <input checked="" type="checkbox"/> | Check if there is a shared raceway between AFC Panel and Kiosk and identify additional source panels to be de-energized. | Do AFC Panel loads feed into a shared raceway e.g. trench or trough? If Yes, specify source panels in notes. YES (see notes) | | AFC Panel NF shares a trough with Panels NES and NESS. | | | |
| <input checked="" type="checkbox"/> | Identify the assumed pathway of duct / conduit, the location of the handholes, manholes and boxes and accessibility or special escort requirement? | PLNT <input checked="" type="checkbox"/> COMM / IT <input type="checkbox"/> ELES <input checked="" type="checkbox"/> RAIL <input type="checkbox"/> CMNT <input type="checkbox"/> Other Access/Support: | | | | | |
| <input checked="" type="checkbox"/> | Identify handhole or manhole access requirement. | Required PLNT Mason for handhole/manhole access? YES (see notes) Identified Conduit/Duct Transition to mezzanine level? YES | | Conduit/ducts on multiple levels. AFC Panel Room N201 is two floors above Mezzanine. | | | |
| Emergency Power Verification | | | | | | | |
| Check | Task | Equipment | Room ID | Notes | | | |
| <input checked="" type="checkbox"/> | Verify if AFC electrical panel is connected to an Automatic Transfer Switch (ATS). | ATS Name/Number: | | | | | |
| <input checked="" type="checkbox"/> | Verification of Kiosk Emergency Panel(s) (KE, KES, KESS, etc) | Source Panel Name/Number: Source Breaker Name/Number: Panel Name/Number: | | | | | |
| Notes and Discrepancies: | | | | | | | |
| Sign Off | | GFP Representative | | | WMATA PRGM | | |
| Name: | | Tino Sahoo | | | | | |
| Signature: | |  | | | | | |
| Date: | | 01/15/2015 | | | | | |

King Street North Photo #1 – AFC Panel NF located in Electrical Room #N201



King Street North Photo #2 – “Panel NF” Panel Schedule - Electrical Room #N201

CIRCUIT DIRECTORY
PANEL NF - 208/120V - 3PH - 4 WIRE - 225 AMP

| | | | | | |
|----|-------------------------|------------------------|----|-----------------|----|
| 1 | Fare Vending | 31 | 2 | Kiosh Panel NKE | 5 |
| 3 | Fare Vending | 30 | 4 | Kiosh Panel NKE | 5 |
| 5 | Fare Vending | 50 | 6 | Kiosh Panel NKE | 5 |
| 7 | Fare Vending | 51 | 8 | Fare Vending | |
| 9 | Bus Transfer | MARK 122201 | 10 | Fare Vending | 10 |
| 11 | Bus Transfer | MARK 122201 | 12 | Fare Vending | 11 |
| 13 | Map & Tele. Case | | 14 | Fare Vending | 12 |
| 15 | Map & Tele. Case | | 16 | Fare Vending | 13 |
| 17 | | | 18 | SMARTTRIP New | |
| 19 | | | 20 | | |
| 21 | Electric Rm. Receptacle | | 22 | | |
| 23 | | | 24 | | |
| 25 | | | 26 | | |
| 27 | | | 28 | | |
| 29 | | | 30 | | |
| 31 | | | 32 | | |
| 33 | | | 34 | | |
| 35 | | | | | |
| 37 | | | | | |

King Street North Photo #3 – “Panel NF” Side Feed Conduits into Shared Trough - Electrical Room #N201




King Street North Photo #4 – Shared Trough for AFC Panel NF, Source Panel NESS, and Panel NES



King Street North Photo #5 – Source Panel NESS Panel Schedule - Electrical Room #N201

CIRCUIT DIRECTORY
PANEL NESS - 208/120V - 4 WIRE - 225 AMP

| | | | |
|----|-------------------|----|-----------|
| 1 | Lighting | 2 | Lighting |
| 3 | Lighting | 4 | Lighting |
| 5 | Lighting | 6 | Lighting |
| 7 | Lighting | 8 | Lighting |
| 9 | Lighting | 10 | Lighting |
| 11 | Lighting | 12 | Lighting |
| 13 | Receptacle | 14 | Lighting |
| 15 | EF-1, 2 & 4 | 16 | UH-1 |
| 17 | HTR - 1 | 18 | UH-1 |
| 19 | HTR - 2 | 20 | UH-2 |
| 21 | HTR - 3 | 22 | UH-2 |
| 23 | EWC - 1 | 24 | UH-3 |
| 25 | EF -3 | 26 | UH-3 |
| 27 | Heat Trace | 28 | Spare |
| 29 | Heat Trace | 30 | Spare |
| 31 | Heat Trace | 32 | Spare |
| 33 | Heat Trace | 34 | Panel EL1 |
| 35 | HTR - 4 | 36 | Panel EL1 |
| 37 | Contactor Control | 38 | Panel EL1 |
| 39 | | 40 | |
| 41 | | 42 | |



King Street North Photo #6 – Panel NES which feeds Panel NESS Panel Schedule- Electrical Room #N201



NO POSTAGE
NECESSARY
IF MAILED
IN THE
UNITED STATES


CIRCUIT DIRECTORY
PANEL NES - 480/277V - 3PH - 4 WIRE - 400 AMP

| | | | |
|----|------------|----|----------|
| 1 | Elevator 2 | 2 | |
| 3 | Elevator 2 | 4 | |
| 5 | Elevator 2 | 6 | |
| 7 | Elevator 3 | 8 | Lighting |
| 9 | Elevator 3 | 10 | Lighting |
| 11 | Elevator 3 | 12 | Lighting |
| 13 | WH-1 | 14 | Panel |
| 15 | WH-2 | 16 | |
| 17 | WH-2 | 18 | |
| 19 | AC-1 | 20 | |
| 21 | AC-1 | 22 | |
| 23 | AC-1 | 24 | |
| 25 | AC-2 | 26 | |
| 27 | AC-2 | 28 | |
| 29 | AC-2 | 30 | |
| 31 | WH-2 | 32 | |
| 33 | | 34 | |
| 35 | | 36 | |
| 37 | | 38 | |
| 39 | | 40 | |
| 41 | | 42 | |

King Street North Photo #7 – Panel NES Main Breaker (Service Disconnect) used to de-energize Panel NES, Panel NESS and AFC Panel NF as all three panels share trough.



King Street North Photo #8 – Manholes in Mezzanine Area used for Routing of Power Conductor from Electrical Room two Floors Up to Mezzanine

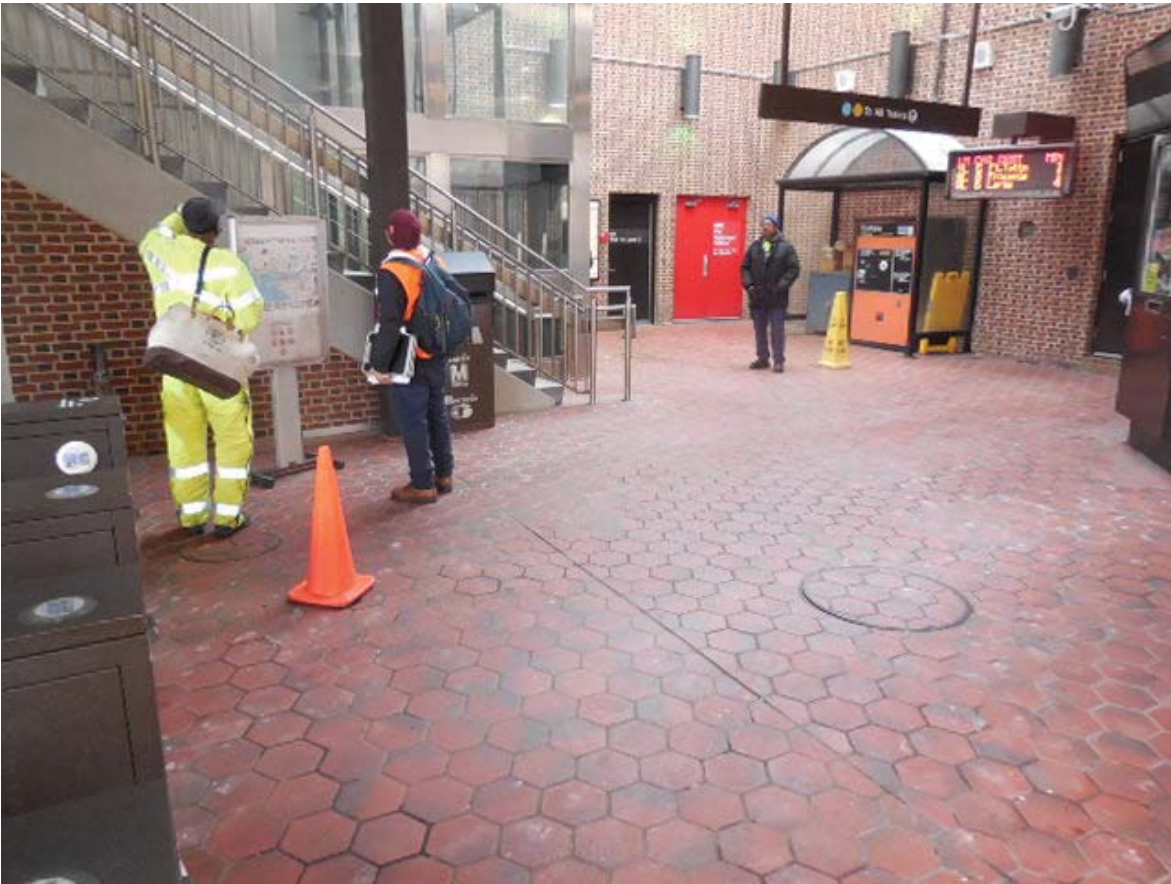


King Street North #9 – Handhole in Mezzanine Area used for Routing of Power Conductors from AFC Panel to Kiosk



NOTES:

1. ALL EQUIPMENT IS NEW UNLESS OTHERWISE NOTED.
2. PROVIDE CONCRETE ENCASED FFC CONDUITS FOR ELECTRICAL CIRCUITS SERVING GROUND LEVEL LOADS. SEE DWG. E-08.
3. INSTALL PAVEMENT WITHIN COVER CURBLES.
4. PROVIDE CONDUITS ENCASED IN CONCRETE UNDER FLOOR SLAB FROM MAIN TO LOADS REQUIRING ELECTRICAL POWER CONNECTION INCLUDING LIGHTED HANDRAIL. COORDINATE ROUTING WITH OTHER CONDUITS, PIPING AND UTILITIES. SEE DWG. E-08.
5. INSTALL 1/2" Ø INSULATED GROUNDING CABLE IN 1" CONDUIT TO GROUND BUS BAR IN LOFT LEVEL ELECTRICAL ROOM AND MAKE CONNECTIONS.
6. PROVIDE CONTINUOUS CONDUITS BETWEEN GROUND LEVEL TO SUB-BASIN LOCATION IN ELEC. ROOM ON LOFT LEVEL.
7. POWER AND COMM. UNDERFLOOR DUCT ROUTING AND INSTALLATION SHALL BE IN ACCORDANCE WITH "MATA STANDARDS" SEE COMMUNICATION DRAWINGS FOR UNDER FLOOR DUCT LAYOUT.
8. DISCONNECT SWITCHES FOR ELEVATOR'S MAIN POWER SUPPLY. SEE DWG. E-08.
9. DISCONNECT SWITCHES FOR ELEVATOR CAB.
10. INSTANTANEOUS WATER HEATER WH SHALL BE PROVIDED WITH COND. AND PLUG TO MATCH RECEPTACLE.
11. JUNCTION FOR HEAT TRACE SHALL BE LOCATED MID-POINT OF PIPE RUN. COORDINATE WITH MECHANICAL/PLUMBING.
12. 2" CONDENSATE COLLECTOR SHALL BE MOUNTED 18" AFT OUT FUSION TO THE WALL.
13. COORDINATE LOCATION OF RECEPTACLE WITH THE CONTROL PANEL OF SP-1.
14. CONTROL PANEL PROVIDED UNDER DIVISION 15.

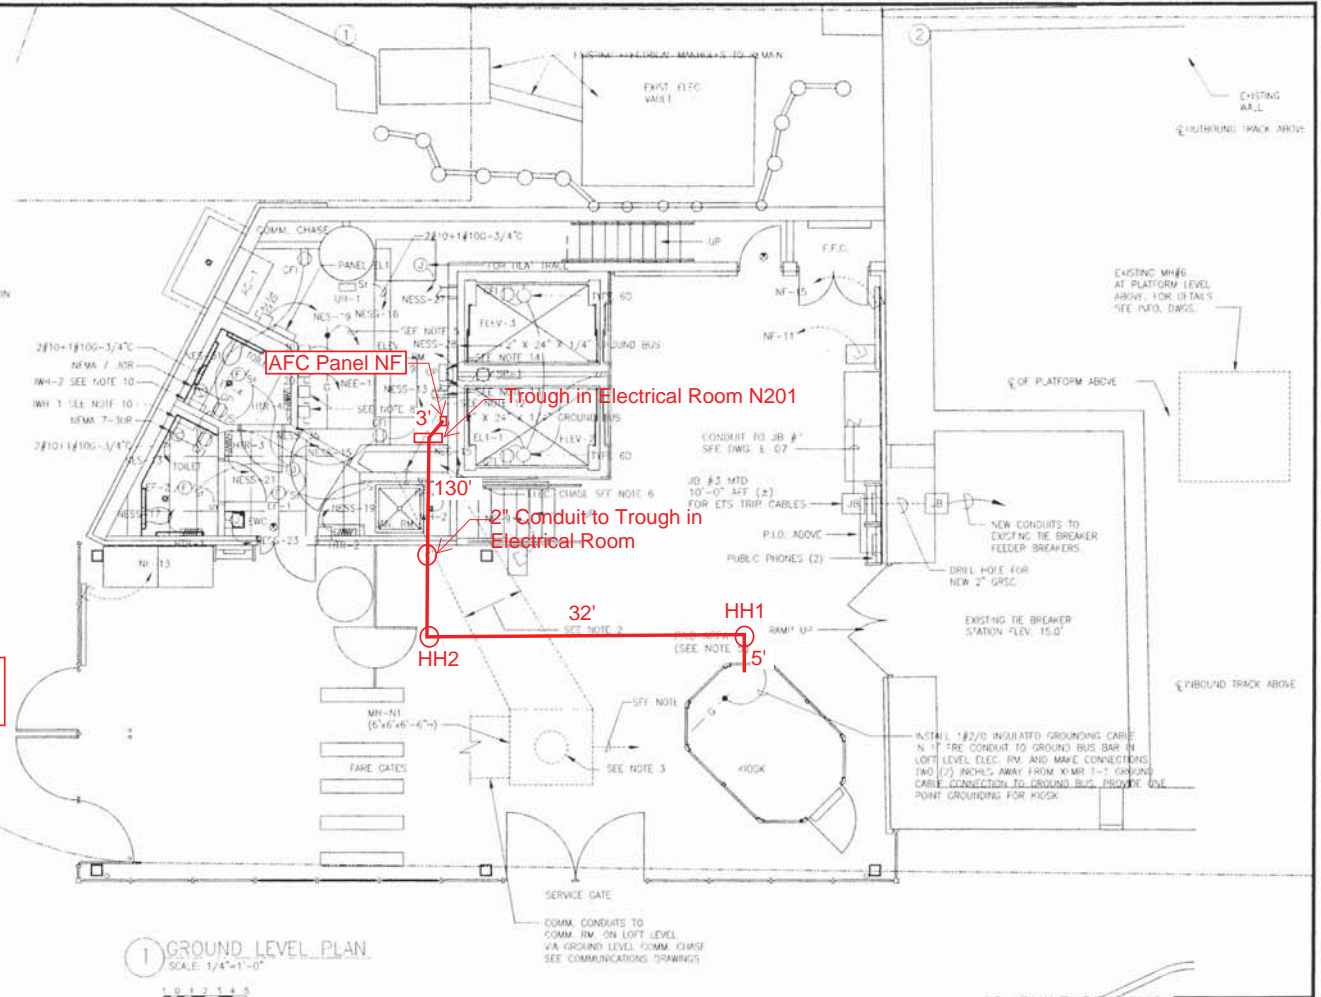

Pre-inspection Field Verification
1/15/2015

1 GROUND LEVEL PLAN
SCALE: 1/4"=1'-0"

AS-BUILT DRAWING
AUGUST 16, 2007

| DESIGNED | DATE | REFERENCE DRAWINGS | | REVISIONS | | DATE | BY | DESCRIPTION |
|----------|------------|--------------------|-------------|-----------|-------------|------|----|-------------|
| | | NUMBER | DESCRIPTION | DATE | DESCRIPTION | | | |
| DESIGNED | 08/16/2007 | | | | | | | |
| DRAWN | | | | | | | | |
| CHECKED | | | | | | | | |
| APPROVED | | | | | | | | |

WASHINGTON METROPOLITAN AREA TRANSIT AUTHORITY

URS
2020 K STREET N.W. SUITE 300
WASHINGTON, DC 20006
TELE. 202.872.0277

GRUNLEY-WALSH
11910 Parkman Drive, Suite U
Rockville, MD 20852

HUNTINGTON ROUTE
KING STREET STATION


GROUND LEVEL PLAN

SCALE: 1/4"=1'-0"

DRAWING NO: C10L-E-05

CONTRACT NO: IC1011

M1121-147

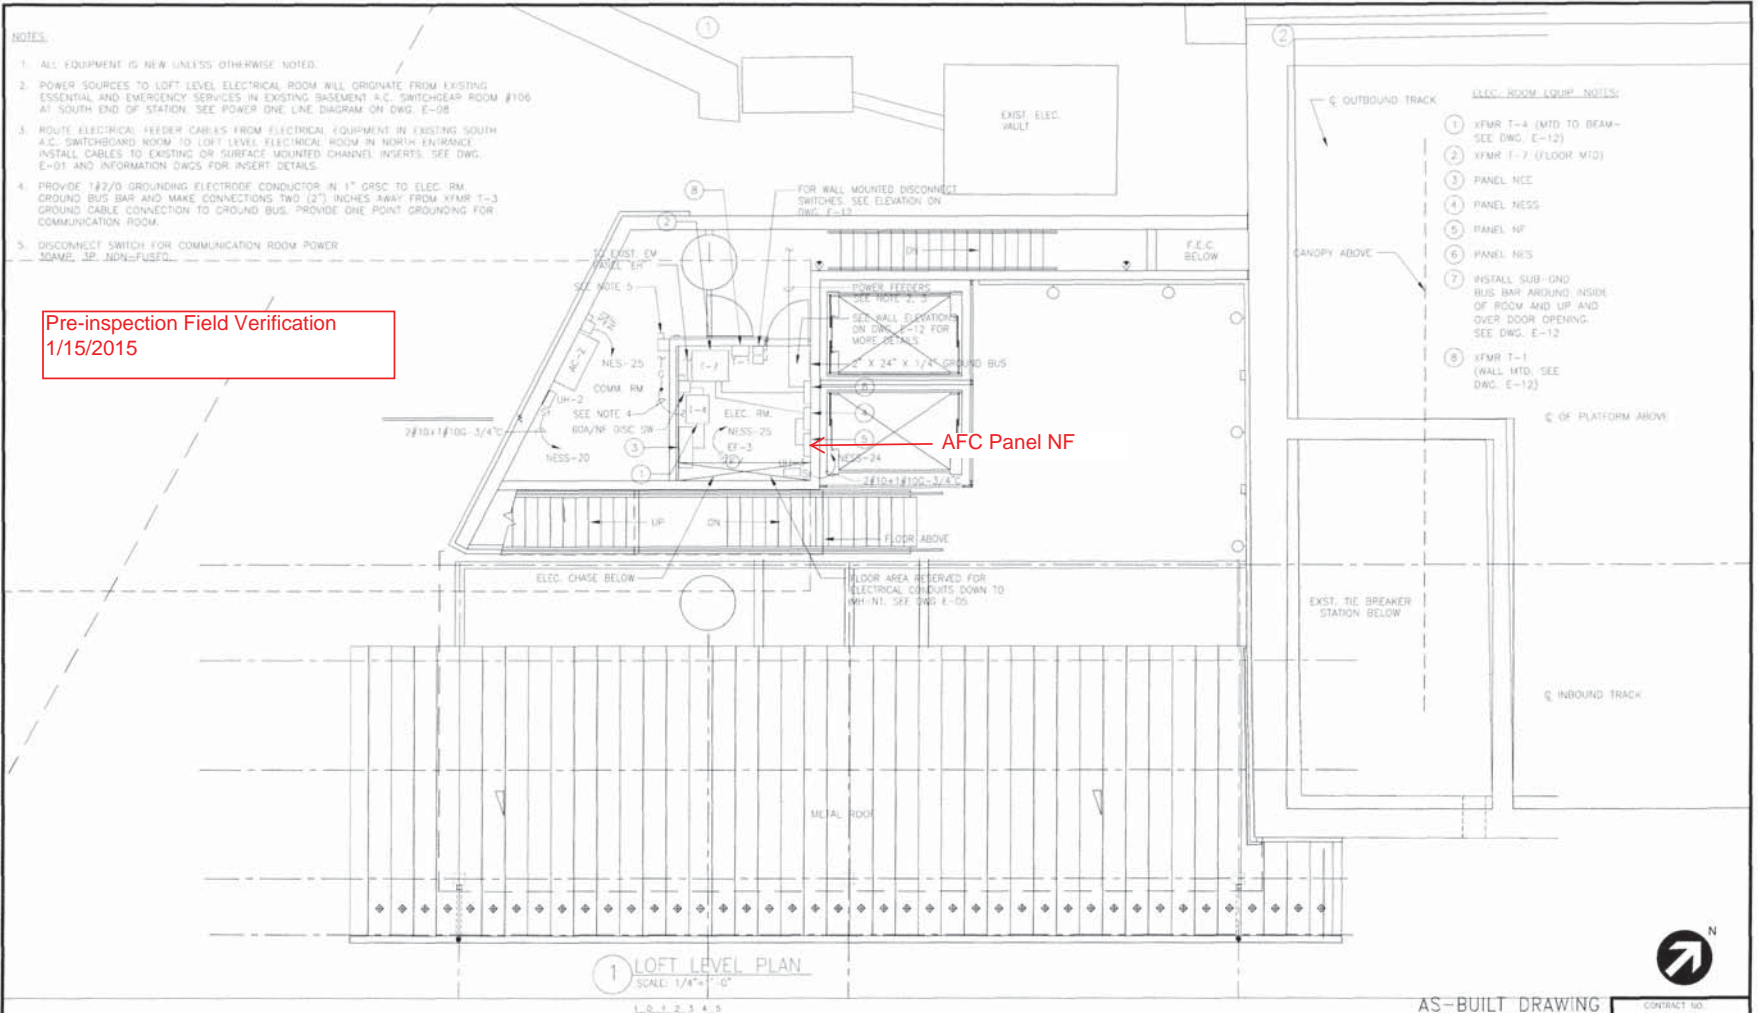

Pre-inspection Field Verification
1/15/2015

AFC Panel NF

- ELEC. ROOM EQUIP. NOTES:
- 1 XFMR T-4 (MTD TO BEAM- SEE DWG. E-12)
 - 2 XFMR T-7 (FLOOR MTD)
 - 3 PANEL NCE
 - 4 PANEL NESC
 - 5 PANEL NF
 - 6 PANEL NES
 - 7 INSTALL SUB-GRD BUS BAR AROUND INSIDE OF ROOM AND UP AND OVER DOOR OPENING. SEE DWG. E-12
 - 8 XFMR T-1 (WALL MTD. SEE DWG. E-12)

1 LOFT LEVEL PLAN
SCALE: 1/4" = 1'-0"

AS-BUILT DRAWING
AUGUST 16, 2007

CONTRACT NO.
1C1011

| DESIGNED | DATE | REFERENCE DRAWINGS | | REVISIONS | | DATE | BY | DESCRIPTION |
|----------|------|--------------------|-------------|-----------|-----|------|-----|-------------|
| | | NUMBER | DESCRIPTION | DATE | BY | | | |
| ... | ... | ... | ... | ... | ... | ... | ... | ... |

WASHINGTON METROPOLITAN AREA TRANSIT AUTHORITY

URS 2020 K STREET N.W. SUITE 300
WASHINGTON, DC 20006
TELE. 702.872.0277

GRUNLEY-WALSH
11910 Parkman Drive, Suite U
Rockville, MD 20852

HUNTINGTON ROUTE
KING STREET STATION

LOFT LEVEL PLAN


SCALE: 1/4" = 1'-0"

DRAWING NO.
C10L-E-06

M1121-148

1. PROJECT: 2007-01-01 METRO AREA TRANSIT AUTHORITY (MTA) - HUNTINGTON ROUTE KING STREET STATION ELECTRICAL AS-BUILT DRAWING (E-06) - 11/15/2007

Pre-inspection Field Verification
1/15/2015

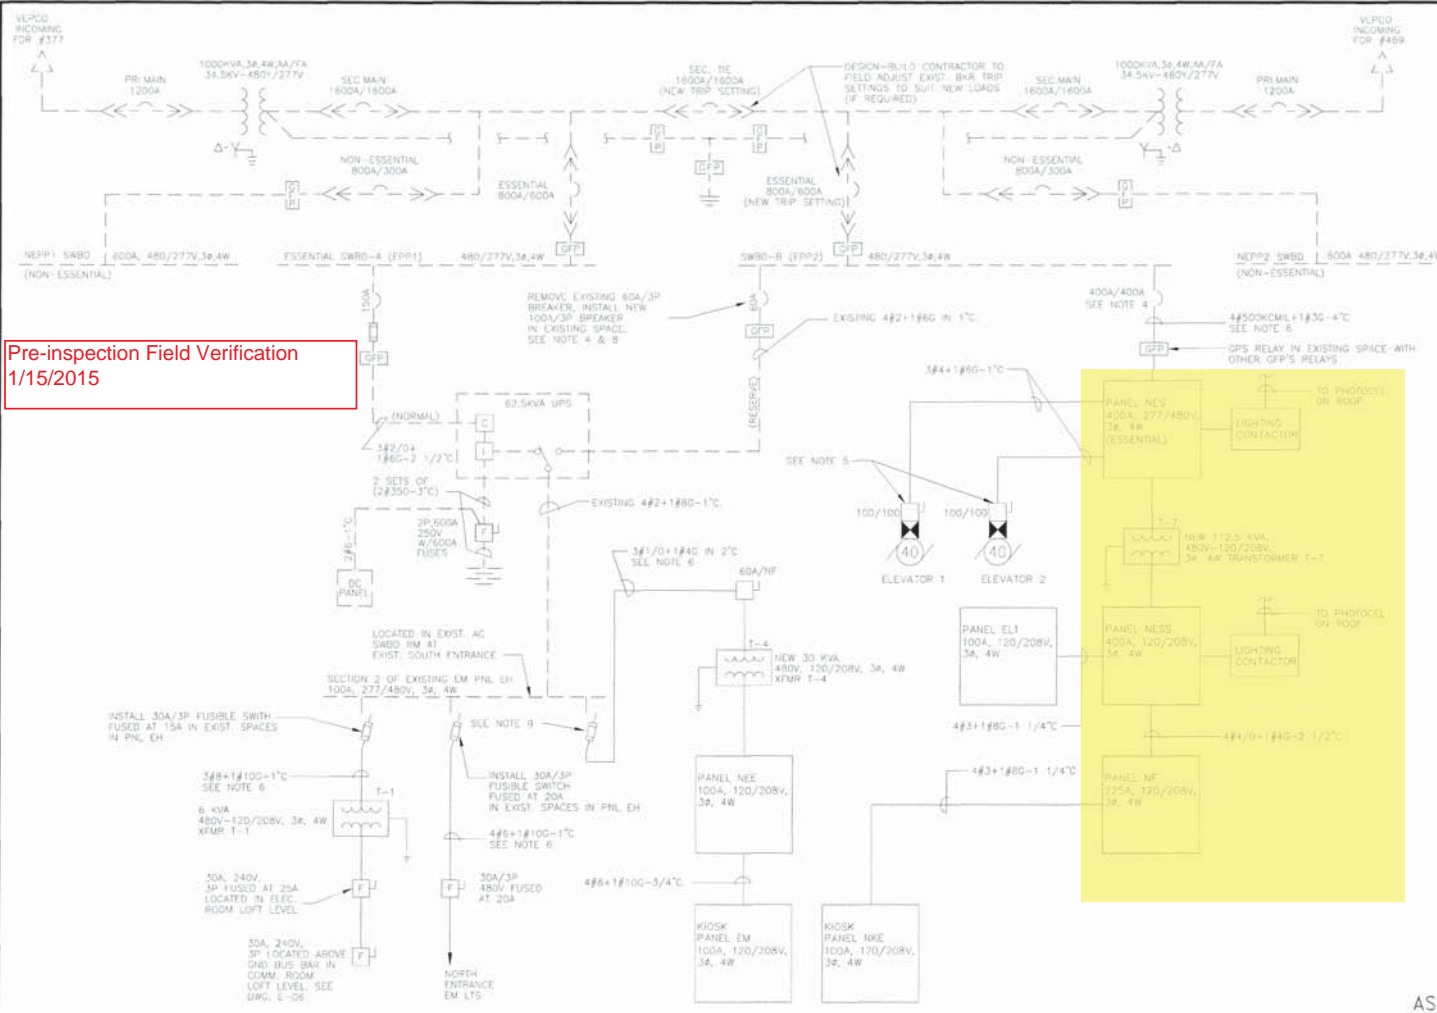

- NOTES
- ALL EXISTING AIL SHOWN IN BROKEN LINE. NEW WORK ARE SHOWN IN HEAVY SOLID LINE.
 - EXISTING SWITCHGEAR INFORMATION MANUFACTURE, GOULD/ITE S.D. 15-8868-535.
 - EXISTING UPS MANUFACTURER INTERNATIONAL POWER MACHINE.
 - ESSENTIAL BREAKER FOR NORTH ENTRANCE. INSTALL 3P MOLDED CASE CIRCUIT BREAKER IN EXISTING BUSSED SPACE. PROVIDE AIC RATING TO MATCH EXISTING.
 - DISCONNECT SWITCH RATING AND FUSE SIZE AS RECOMMENDED BY ELEVATOR SUPPLIER.
 - SEE DWG. E-07 AND INFORMATION DWGS. FOR DETAILS OF FEEDER ROUTING FROM EXISTING SOUTH A.C. SWITCHBOARD ROOM TO NEW NORTH ENTRANCE ELECTRICAL ROOM AND TO LOADS REQUIRING POWER CONNECTIONS.
 - ALL BREAKERS ARE MANUALLY CLOSED EXCEPT FE BREAKER WHICH IS AUTOMATICALLY CLOSED.
 - EXISTING EMERG. SYSTEM IS TO REMAIN OPERATIONAL AT ALL TIMES. CONTRACTOR SHALL DEVELOP AND SUBMIT A WORK PHASING PLAN TO WMATA FOR APPROVAL INDICATING POWER STAGES. INSTALLATION OF BREAKERS, WIRING AND CONDUIT AFTER INSTALLATION OF ELEC. EQUIP. TEST UPS FOR PROPER OPERATION.
 - INSTALL 60A/3P FUSIBLE SWITCH FUSED AT 45A IN EXISTING SPACE.
 - INSTALL HEAT TRACE ON COLD WATER LINE. SEE MECH. DWGS. BRANCH CIRCUIT BREAKER PROTECTION SHALL BE 60A RATED.
 - PNL E1 EQUIPPED WITH MAIN CIRCUIT BREAKER.
 - REMOVE EXISTING 4#4+1#8 CONDUCTORS. ABANDON IN PLACE EXISTING CONDUIT. CUT FLUSH TO FLOOR AND FILL.

AS-BUILT DRAWING
AUGUST 16, 2007

CONTRACT NO.
1C1011

| DESIGNED | J.A. | 7/20/04 | 704P |
|----------|------|---------|------|
| DRAWN | A.P. | 2/20/04 | 04E |
| CHECKED | B.S. | 7/20/04 | 04E |
| APPROVED | K.C. | 7/20/04 | 04E |

| NUMBER | DESCRIPTION | DATE | BY | DESCRIPTION |
|--------|-------------|------|----|-------------|
| | | | | |

| DATE | DESCRIPTION |
|------------|-------------|
| 08/16/2007 | AS-BUILT |

WASHINGTON METROPOLITAN AREA TRANSIT AUTHORITY

2020 K STREET N.W. SUITE 300
WASHINGTON, DC 20006
TELE. 202.872.0277

URS

CRUNLEY-WALSH

11910 Parkview Drive, Suite U
Rockville, MD 20852

HUNTINGTON ROUTE
KING STREET STATION

ELECTRICAL SINGLE LINE DIAGRAM

SCALE: NONE

DRAWING NO.
C10L-E-08

M1121-150

Pre-Inspection Mezzanine Walkthrough Checklist

REVISION 1

| Date: 10/07/2014 | Station Name: C15 Huntington North | Mezzanine #: 050 | Completed By: Tino Sahoo | |
|-------------------------------------|--|---|---------------------------------|--|
| Check | Task | Equipment | Room ID | Notes |
| <input checked="" type="checkbox"/> | Verify that electrical power design matches the field/record. Identify locations of the electrical equipment. | Electrical Source Panel Name/Number: NPOE Source Breaker Name/Number: Breaker #6 Electrical AFC Panel Name/Number: NF | 129 129 129 | Rm 129 is located on platform level |
| <input checked="" type="checkbox"/> | Verify if disconnect switch is connected to the AFC electrical power panel. Low or High voltage SMNT/POWR escorts requirements? | Disconnect Name/Number: N/A SMNT/POWR escorts: HIGH and LOW Voltage | | |
| <input checked="" type="checkbox"/> | Check if there is a shared raceway between AFC Panel and Kiosk and identify additional source panels to be de-energized. | Do AFC Panel loads feed into a shared raceway e.g. trench or trough? If Yes, specify source panels in notes. NO | C106 | |
| <input checked="" type="checkbox"/> | Identify the assumed pathway of duct / conduit, the location of the handholes, manholes and boxes and accessibility or special escort requirement? | PLNT <input checked="" type="checkbox"/> COMM / IT <input type="checkbox"/> ELES <input type="checkbox"/> RAIL <input type="checkbox"/> CMNT <input type="checkbox"/> Other Access/Support: | | |
| <input checked="" type="checkbox"/> | Identify handhole or manhole access requirement. | Required PLNT Mason for handhole/manhole access? YES (see notes) Identified Conduit/Duct Transition to mezzanine level? YES | | Conduit/duct run from platform level to mezzanine level. |

| Emergency Power Verification | | | | |
|-------------------------------------|--|--|---------------------|--|
| Check | Task | Equipment | Room ID | Notes |
| <input checked="" type="checkbox"/> | Verify if AFC electrical panel is connected to an Automatic Transfer Switch (ATS). | ATS Name/Number: | | |
| <input checked="" type="checkbox"/> | Verification of Kiosk Emergency Panel(s) (KE, KES, KESS, etc) | Source Panel Name/Number: NEE Source Breaker Name/Number: Breaker #13 Panel Name/Number: Kiosk Emergency Panel | 129 129 Kiosk | Breaker #38 of AFC Panel (NF) feeds emergency circuits to Kiosk Panels also. |

Notes and Discrepancies: Panel KE (Breaker #3,5) de-energizes emergency power to faregates.

| | | |
|-------------------|---------------------------|-------------------|
| Sign Off | GFP Representative | WMATA PRGM |
| Name: | Tino Sahoo | |
| Signature: | | |
| Date: | 10/07/14 | |

Photo #1: C15 Huntington North – Handholes at Mezzanine



Photo #2: C15 Huntington North – Handholes at Mezzanine



Photo #3: C15 Huntington North – Handholes at Mezzanine

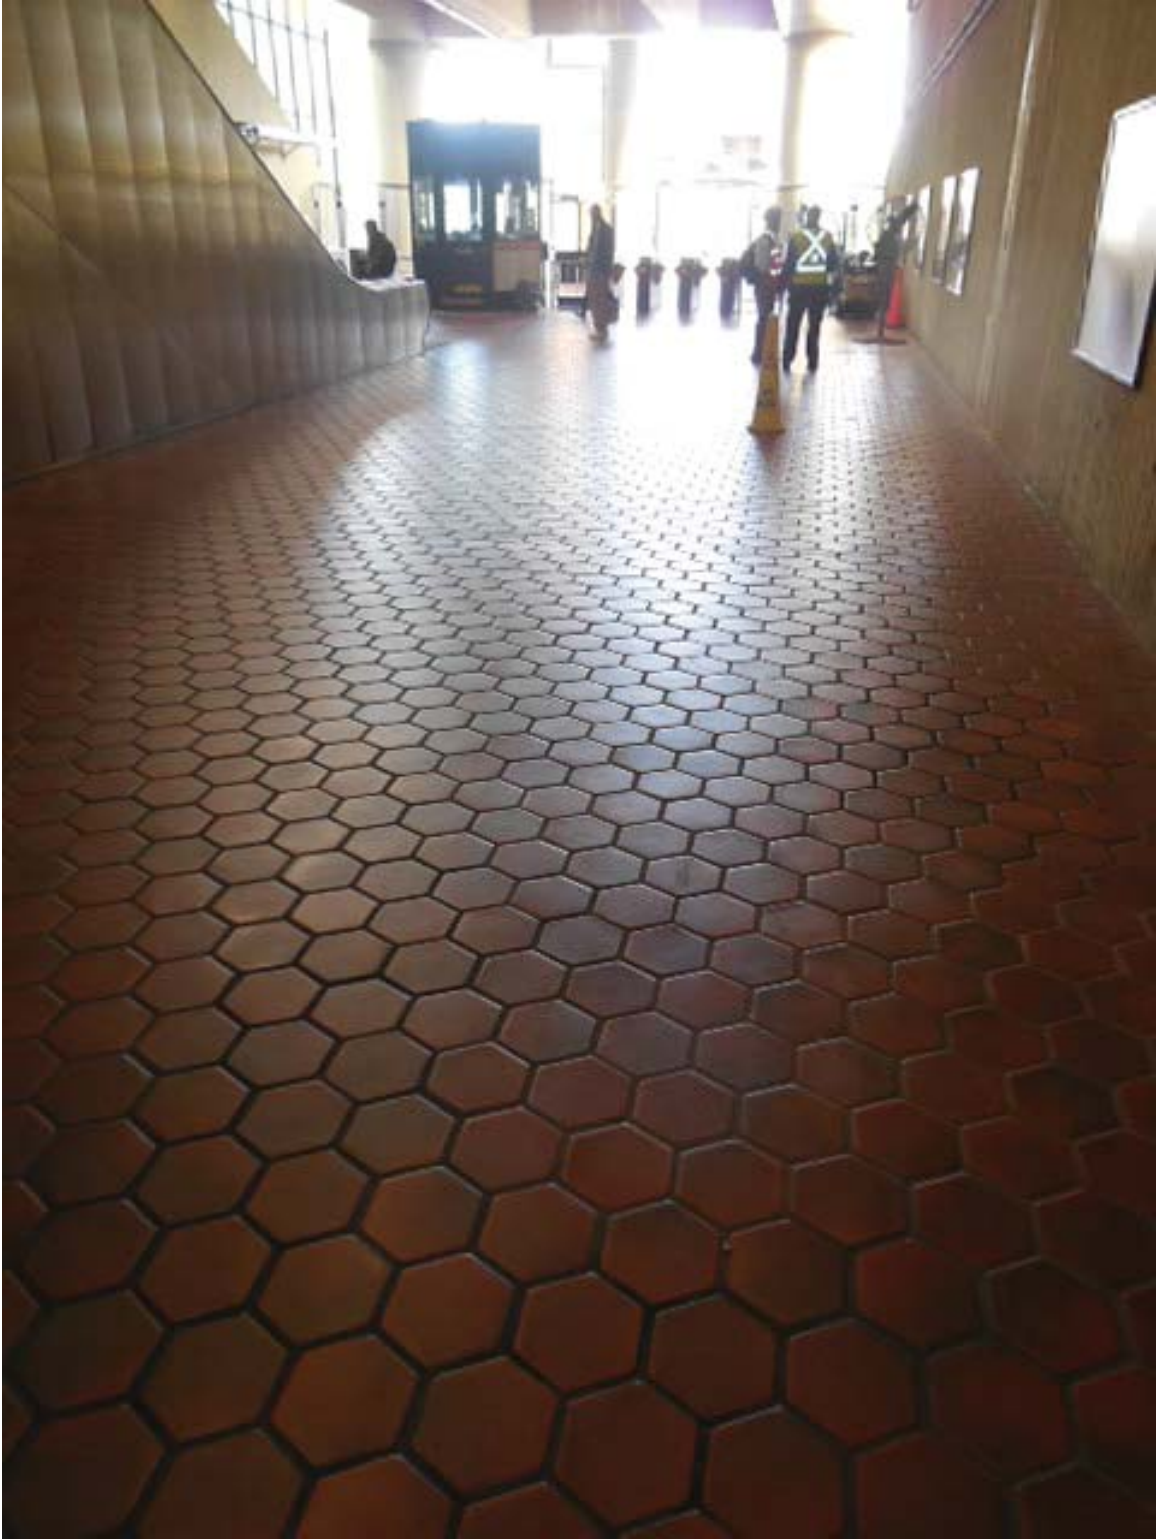


Photo #4 & 5: C15 Huntington North – Panel NPOE in Room 129



Photo #7: C15 Huntington North – Panel NPOE – Circuit #6 to de-energize AFC Panel NF



Photo #8: C15 Huntington North – AFC Panel NF – Ducts below Panel



Photo #9 & 10: C15 Huntington North – AFC Panel NF – Bottom of Panel





NOTES:


1. THE MINIMUM OPERATIONAL MACHINE INVENTORY IS REFERENCED ON THIS DRAWING BY THE "X" DRAWN THROUGH THE MACHINE.
 2. FOR REFERENCE DRAWINGS USED SEE SUPPORT DOCUMENTATION PACKAGE FOR THIS MEZZANINE.
- ⊙ (X) INDICATES POSITION NO. ⊠ (X) INDICATES AISLE NO.

Pre-inspection Field Verification 10/07/2014

50

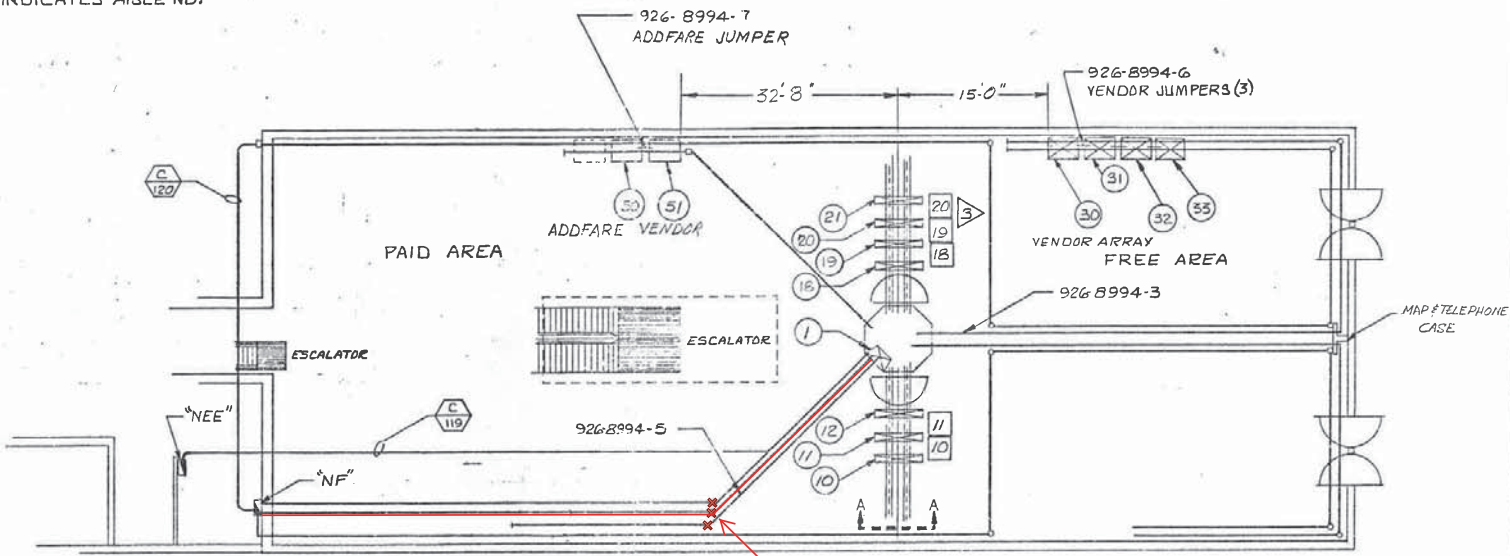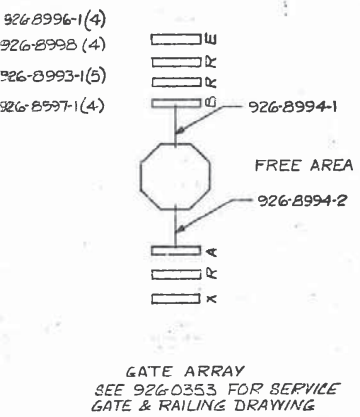

Handholes not seen during Pre-inspection.

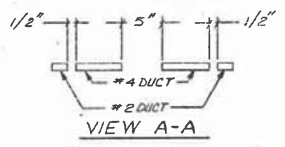

| PANEL N F | | | | | |
|--------------|--------------|------------|---------------------|---------------------|-----------------|
| POSITION NO. | MACHINE TYPE | SERIAL NO. | CIRCUIT BREAKER NO. | BREAKER SIZE (AMPS) | WIRE SIZE (AWG) |
| 1 | DADS | DS8071 | KIOSK | 20 | |
| 10 | EXIT GATE | GX 4075 | 1 | 20 | 8 |
| 11 | REY GATE | GR 7274 | 3 | 20 | 8 |
| 12 | A GATE | GR 5056 | 5 | 20 | 8 |
| 18 | B GATE | GB 6054 | 7 | 20 | 8 |
| 19 | REY GATE | GR 7284 | 9 | 20 | 8 |
| 20 | REY GATE | GR 7273 | 11 | 20 | 8 |
| 21 | ENTRY | GN 3071 | 13 | 20 | 8 |
| 30 | VENDOR | FV 1347 | 2 | 20 | 6 |
| 31 | VENDOR | FV 1344 | 4 | 20 | 6 |
| 32 | VENDOR | FV 1348 | 6 | 20 | 6 |
| 33 | VENDOR | FV 1292 | 8 | 20 | 6 |
| 50 | ADDFARE | AM 2130 | 10 | 20 | 6 |
| 51 | ADDFARE | AM 2131 | 12 | 20 | 6 |

- 1 INSTALLATION PLAN NORTH
AS BUILT DRAWING

DO NOT SCALE DRAWING

UNLESS OTHERWISE SPECIFIED DIMENSIONS ARE IN INCHES TOLERANCES ON DIMENSIONS ON ANGLE: ± 0.5 DEG. ± 0.5 THRU 1.5" ± 0.04 ± 0.01 ± 0.5 THRU 1.5" ± 0.08 ± 0.01 ± 1.5" THRU 10.00" ± 0.10 ± 0.00

CONTRACT NUMBER: D B1

DRAWING NUMBER: 926-0417

SHEET 1 OF 2

TITLE: INSTALLATION PLAN NORTH

CUBIC WESTERN DATA

CODE IDENT NO. 94987

DRIVER: J. BERENSON


DESIGNER: J. BERENSON

ENGR: J. BERENSON

REGION: NORTH

ACTIVITY APPROVAL

926-0417

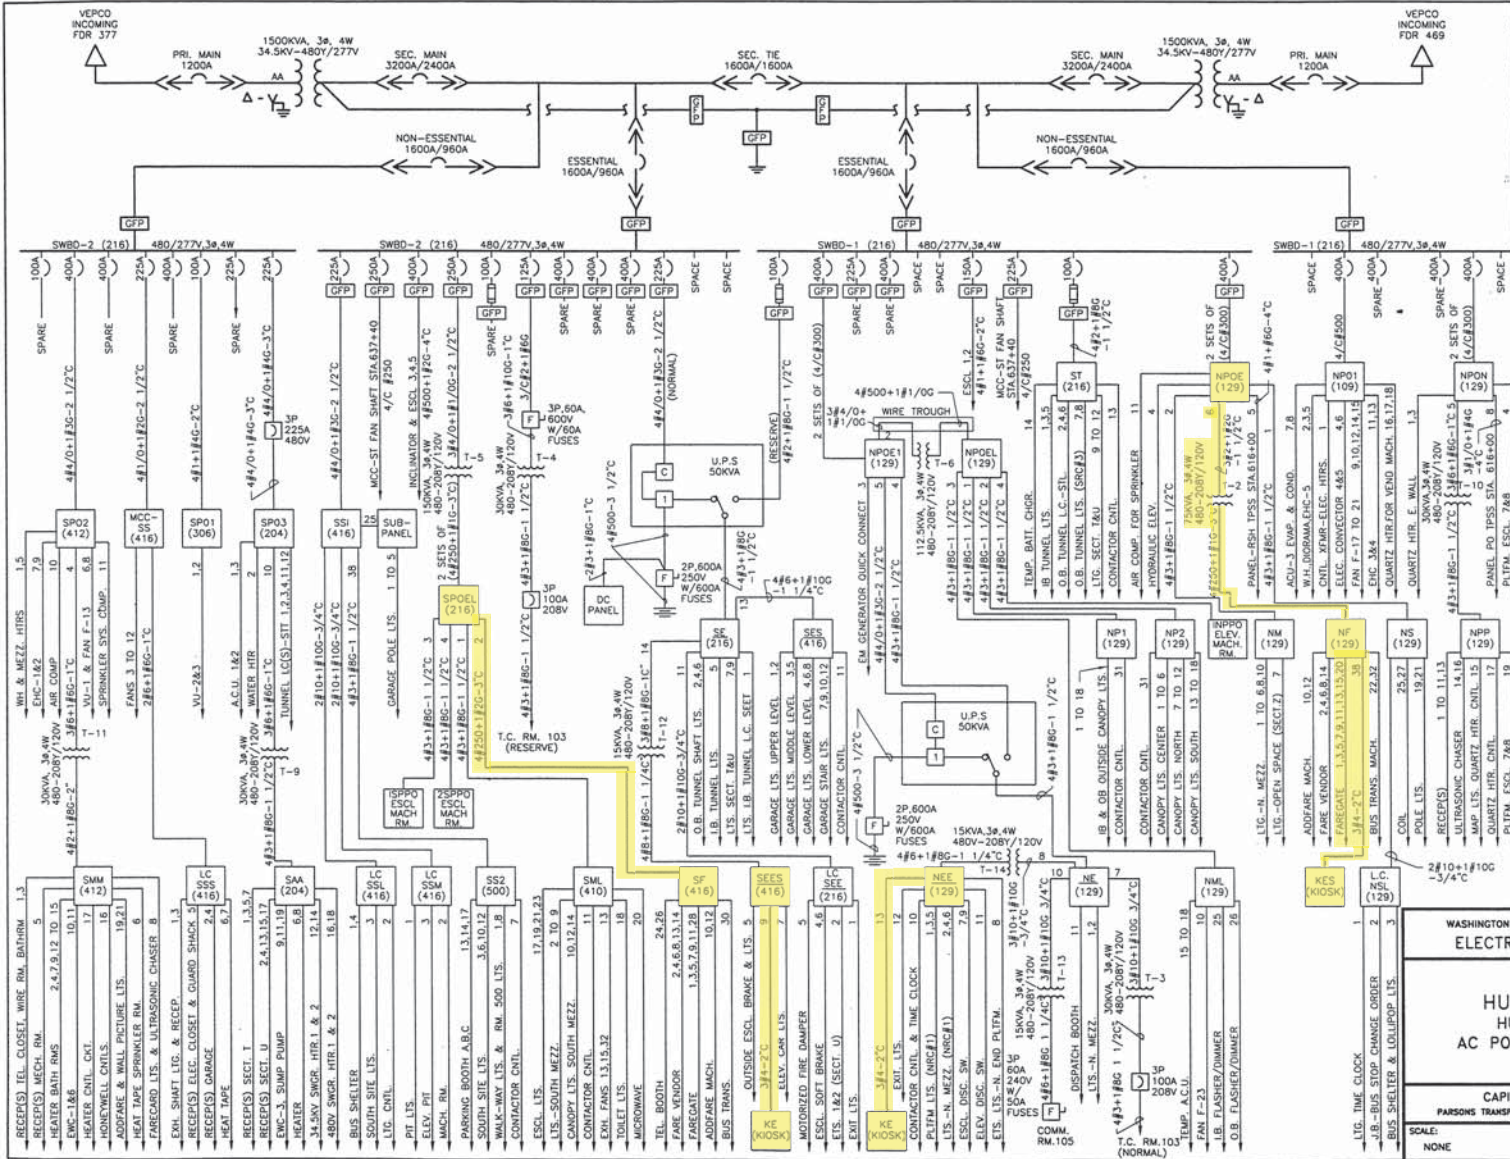

- NOTES:
1. PANEL DESIGNATION
WEA (205)
(LIGHTING)
ROOM NUMBER
TYPE OF DISTRIBUTION
8 (CIRCUIT NUMBER)
* WHEN NO CKTS SHOWN
 2. 3/2. 2" CONDUIT SIZE
AWG OR KCMIL CIRCUIT WIRES
* AS TAKEN FROM AS BUILT DWGS.
 3. CIRCUIT BREAKERS
DRAW OUT TO 1600A/1200A
MOULDED CASE
FRAME SIZE
CONTINUOUS CURRENT
SETTING
 4. SWITCHGEAR INFORMATION
MANUFACTURER:
GENERAL ELECTRIC
JOB No. 182-89460
 5. UPS MANUFACTURER
INTERNATIONAL POWER MACHINES
 6. ROOM DESIGNATIONS
NORTH MEZZANINE
103 TRAIN CONTROL
105 COMMUNICATION
107 OPERATIONS
109 MECHANICAL ROOM
113 ELEV. MACH. ROOM
127 BATTERY ROOM
129 ELECTRIC EQUIP. ROOM
LOWER LEVEL ANCILLARY (PLATFORM)
204 CLEANERS ROOM
214 BATTERY ROOM
216 AC SWBD ROOM
UPPER LEVEL ANCILLARY
300 TRANSFORMER VAULT
304 TRANSFORMER VAULT
306 MECHANICAL ROOM
SOUTH MEZZANINE
410 ELECTRIC CLOSET
412 CLEANERS ROOM
GARAGE
416 ELECTRIC CLOSET
500 ELECTRIC CLOSET

| DATE | BY | DESCRIPTION |
|------|----|-------------|
| | | |
| | | |
| | | |

WASHINGTON METROPOLITAN AREA TRANSIT AUTHORITY
ELECTRICAL MAINTENANCE MAP

HUNTINGTON ROUTE
HUNTINGTON STATION
AC POWER ONE LINE DIAGRAM

CAPITAL IMPROVEMENT PROGRAM
PARSONS TRANSPORTATION GROUP - CAPITAL TRANSIT CONSULTANTS

| | |
|----------------|-------------------------|
| SCALE: NONE | DRAWING NO. MM-C-E37 |
|----------------|-------------------------|

Pre-inspection Field
Verification 10/07/2014

Pre-Inspection Mezzanine Walkthrough Checklist

| Date: 10/07/2014 | Station Name: C15 Huntington South | Mezzanine # 051 | Completed By: Tino Sahoo | |
|-------------------------------------|--|--|---|---|
| Check | Task | Equipment | Room ID | Notes |
| <input checked="" type="checkbox"/> | Verify electrical power design matches the field/record. Identify locations of the electrical equipment. | Electrical Source Panel Name/Number: SPOEL SEES Source Breaker Name/Number: Circuit #2, 3PH Circuit #9, (Panel SEES) Electrical AFC Panel Name/Number: SF, KE (Kiosk) | 216 416 216 416 416,Kiosk | Rm 216 is located on platform level Track 1 wayside. Rm 416 is located in Parking Garage. Emergency circuit is Circuit #9 on Source Panel 'SEES' for KE (Kiosk Panel). |
| <input checked="" type="checkbox"/> | Is there a disconnect switch connected to the AFC electrical power panel? Low or High voltage SMNT/POWR escorts required? | Disconnect Name/Number: N/A SMNT/POWR escorts: LOW Voltage | | Source Panels: SPOEL (Rm 216) AFC Source SEES (RM 416) KE (Kiosk) Source Breakers: Circuit #2 of Panel SPOEL Circuit #9 of Panel SEES Affected Panels: SF (416) AFC Panel KE (Kiosk) Panel located in Kiosk |
| <input checked="" type="checkbox"/> | Check if there is a shared raceway between AFC Panel and Kiosk and identify additional source panels to de-energize | Do AFC Panel loads feed into a shared raceway e.g. trench or trough? If Yes, specify source panels in notes. NO | C106 | |
| <input checked="" type="checkbox"/> | Identify the assumed pathway of the duct, the location of the handholes, manholes and boxes and accessibility or special escort requirement? | PLNT <input type="checkbox"/> COMM / IT <input type="checkbox"/> ELES <input type="checkbox"/> RAIL <input type="checkbox"/> CMNT <input type="checkbox"/> Other Access/Support: AFC | | Need AFC manhole access under machine. Hard to fish. |
| <input checked="" type="checkbox"/> | Identify handhole or manhole access requirement. | Required PLNT Support for handhole/manhole access? NO Identified Conduit/Duct Transition to mezzanine level? NO | | Conduit/duct run on multiple levels. Junction box located under fare-card vending machine. Over 150' run from AFC Panel (SF) to Kiosk. |

Emergency Power Verification

| Check | Task | YES | NO | NA | Comments |
|-------------------------------------|--|--------------------------|--------------------------|-------------------------------------|----------|
| <input checked="" type="checkbox"/> | Verification of the electrical plan to the existing schematic if the AFC electrical panel is connected to a Automatic Transfer Switch (ATS) / emergency power source | <input type="checkbox"/> | <input type="checkbox"/> | <input checked="" type="checkbox"/> | |

Notes and Discrepancies:

| | | |
|-------------------|---------------------------|-------------------|
| Sign Off | GFP Representative | WMATA PRGM |
| Name: | Tino Sahoo | |
| Signature: | | |
| Date: | 10/07/14 | |

Photo 2: C15 Huntington South – Panel SPOEL in Rm 216 – Circuit #2






NOTES:

1. THE MINIMUM OPERATIONAL MACHINE INVENTORY IS REFERENCED ON THIS DRAWING BY THE "X" DRAWN THROUGH THE MACHINE.
2. FOR REFERENCE DRAWINGS USED SEE SUPPORT DOCUMENTATION PACKAGE FOR THIS MEZZANINE.

⊕ INDICATES POSITION NO. ⊗ INDICATES AISLE NO.

Pre-inspection Field Verification 10/07/2014

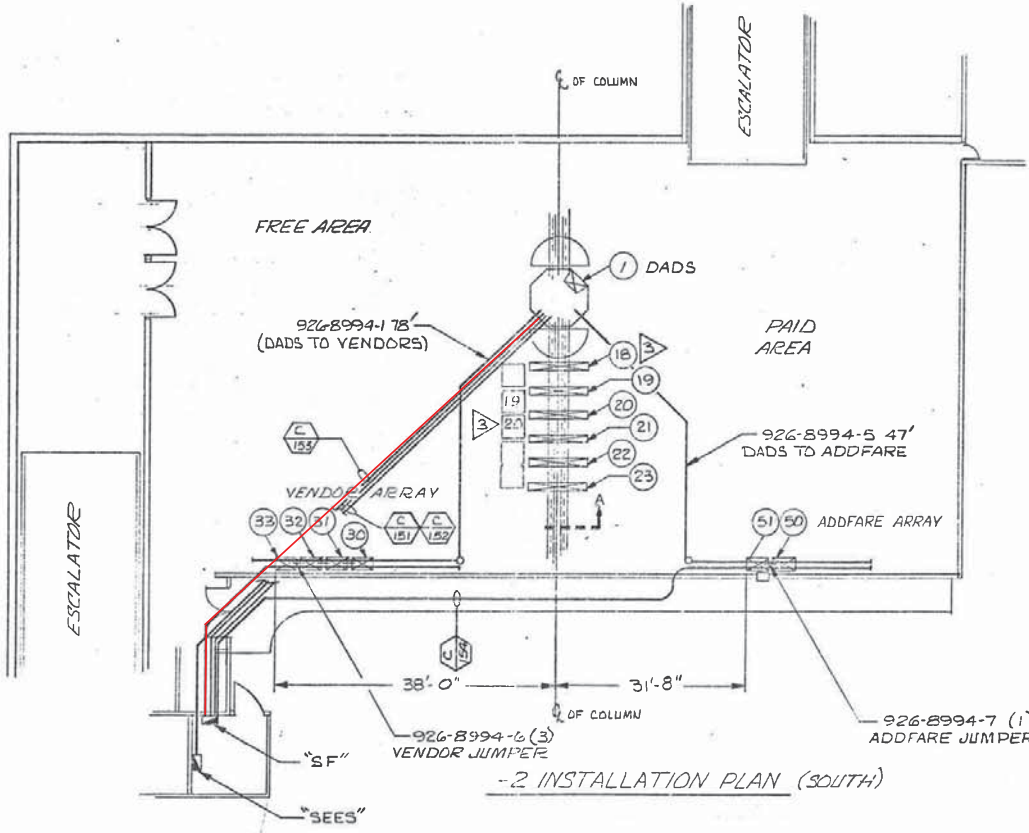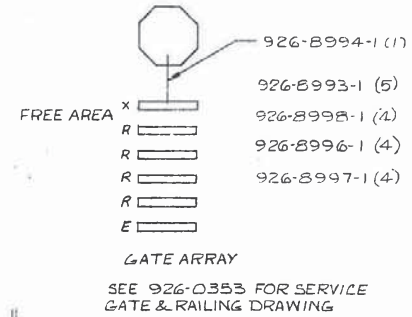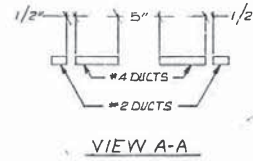

| POSITION NO. | MACHINE TYPE | SERIAL NO. | PANEL SF | | |
|--------------|--------------|------------|---------------------|---------------------|-----------------|
| | | | CIRCUIT BREAKER NO. | BREAKER SIZE (AMPS) | WIRE SIZE (AWG) |
| 1 | DADS | DS 8067 | KIOSK | 20 | |
| 18 | EXIT GATE | GX 4030 | 1 | 20 | 6 |
| 19 | REV GATE | GR 7275 | 3 | 20 | 6 |
| 20 | REV GATE | GR 7260 | 5 | 20 | 6 |
| 21 | REV GATE | GR 7258 | 7 | 20 | 6 |
| 22 | REV GATE | GR 7253 | 9 | 20 | 6 |
| 23 | ENTRY GATE | GN 3001 | 11 | 20 | 6 |
| 30 | VENDOR | FV 1354 | 2 | 20 | 8 |
| 31 | VENDOR | FV 1346 | 4 | 20 | 8 |
| 32 | VENDOR | FV 1339 | 6 | 20 | 8 |
| 33 | VENDOR | FV 1345 | 8 | 20 | 8 |
| 50 | ADDFARE | AM 2129 | 10 | 20 | 8 |
| 51 | ADDFARE | AM 2127 | 12 | 20 | 8 |

DO NOT SCALE DRAWING

UNLESS OTHERWISE SPECIFIED DIMENSIONS ARE IN INCHES. DIMENSIONS IN PARENTHESIS ARE MAXIMUMS.

DATE: 11/13/14 11:00 AM
 DRAWN BY: J. J. J. J. J.
 CHECKED BY: J. J. J. J. J.
 APPROVED BY: J. J. J. J. J.


CONTRACT NUMBER: D B1
 DRAWING NUMBER: 926-0417
 SHEET 2 OF 2

TITLE: CUBIC WESTERN DATA

CODE IDENT NO.: 94987

DATE: 11/13/14
 TIME: 11:00 AM

51

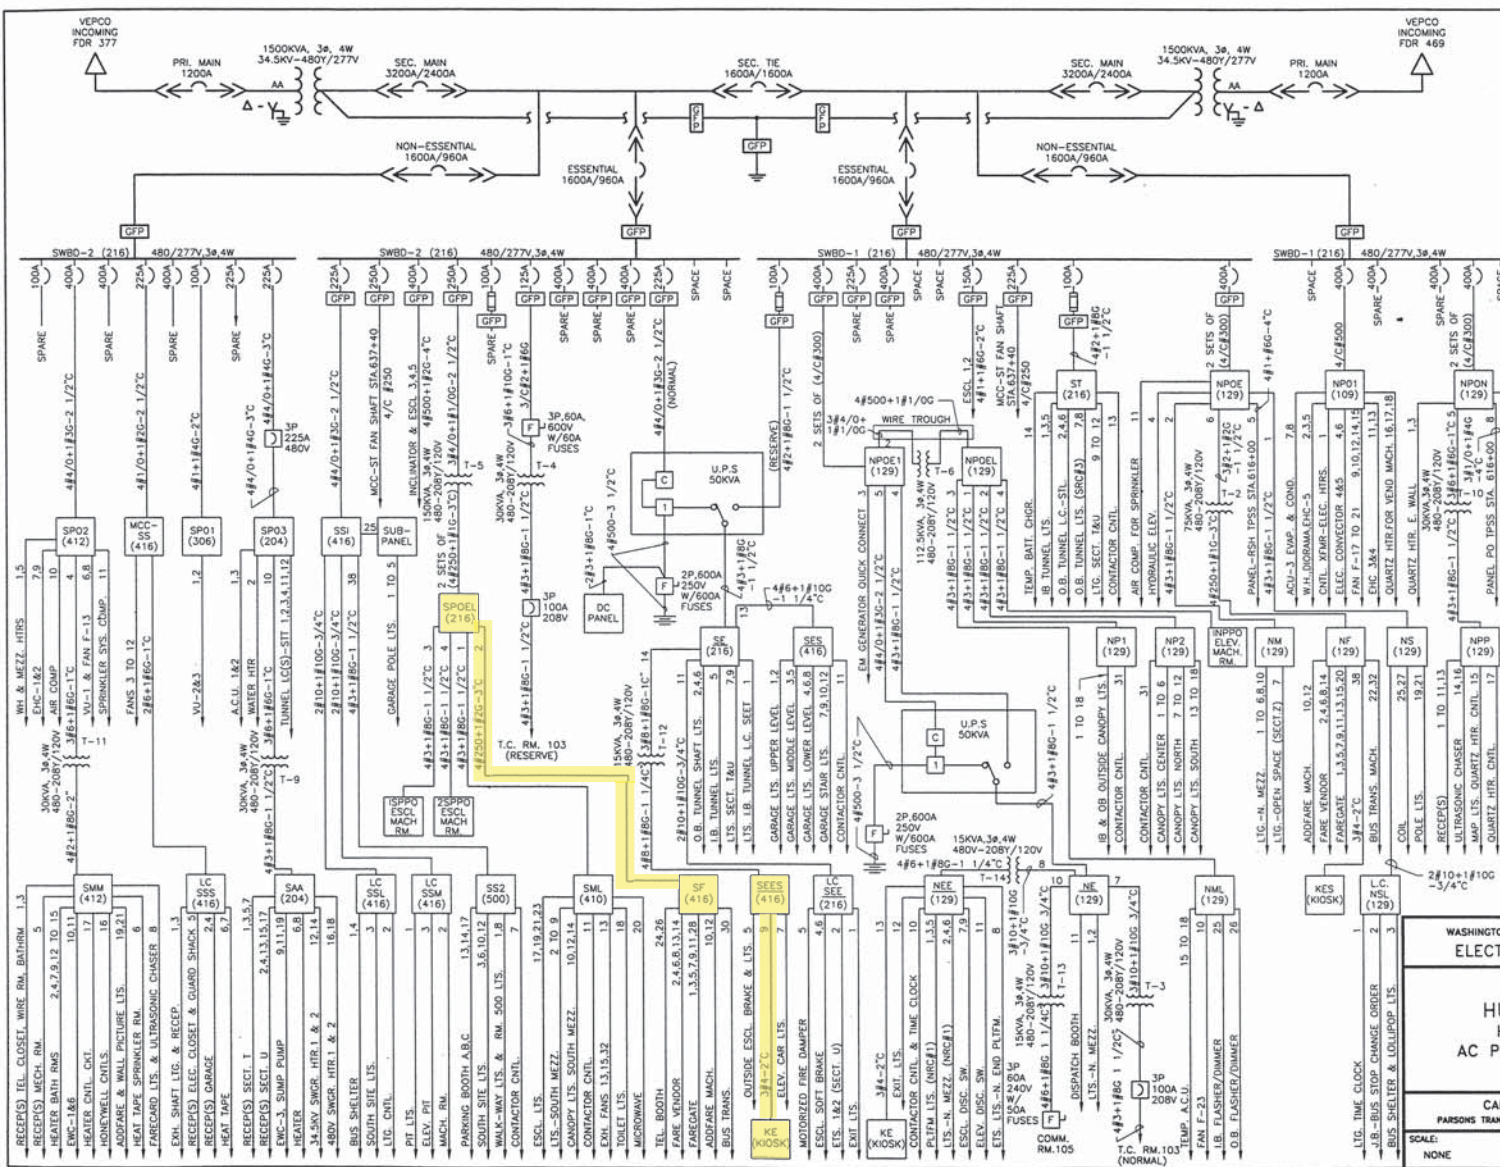

NOTES:

- PANEL DESIGNATION

WEA (205) PANEL DESIGNATION WHEN UNDERLINED IS EMERGENCY

(LIGHTING) ROOM NUMBER

8 (CIRCUIT NUMBER) TYPE OF DISTRIBUTION

* WHEN NO CKTS SHOWN
- 3/2, 2" CONDUIT SIZE

AWG OR KCMIL CIRCUIT WIRES

* AS TAKEN FROM AS BUILT DWGS.
- CIRCUIT BREAKERS

DRAW OUT OR MOLDED CASE

1600A/1200A

FRAME SIZE CONTINUOUS CURRENT SETTING
- SWITCHGEAR INFORMATION

MANUFACTURER: GENERAL ELECTRIC

JOB No. 182-89460
- UPS MANUFACTURER

INTERNATIONAL POWER MACHINES
- ROOM DESIGNATIONS

NORTH MEZZANINE

 - 103 TRAIN CONTROL
 - 105 COMMUNICATION
 - 107 OPERATIONS
 - 109 MECHANICAL ROOM
 - 113 ELEV. MACH. ROOM
 - 127 BATTERY ROOM
 - 129 ELECTRIC EQUIP. ROOM

LOWER LEVEL ANCILLARY (PLATFORM)

 - 204 CLEANERS ROOM
 - 214 BATTERY ROOM
 - 216 AC SWBD ROOM

UPPER LEVEL ANCILLARY

 - 300 TRANSFORMER VAULT
 - 304 TRANSFORMER VAULT
 - 306 MECHANICAL ROOM

SOUTH MEZZANINE

 - 410 ELECTRIC CLOSET
 - 412 CLEANERS ROOM

GARAGE

 - 416 ELECTRIC CLOSET
 - 500 ELECTRIC CLOSET

| REVISIONS | |
|-----------|-------------|
| DATE | DESCRIPTION |
| | |
| | |

WASHINGTON METROPOLITAN AREA TRANSIT AUTHORITY
ELECTRICAL MAINTENANCE MAP

**HUNTINGTON ROUTE
HUNTINGTON STATION
AC POWER ONE LINE DIAGRAM**

CAPITAL IMPROVEMENT PROGRAM
PARSONS TRANSPORTATION GROUP - CAPITAL TRANSIT CONSULTANTS

SCALE: NONE DRAWING No. **MM-C-E37**

Pre-inspection Field Verification 10/07/2014

Pre-Inspection Mezzanine Walkthrough Checklist


| | | | |
|-------------------------|--|------------------------|---------------------------------|
| Date: 08/28/2014 | Station Name: Mt. Vernon Square | Mezzanine # 070 | Completed By: Tino Sahoo |
|-------------------------|--|------------------------|---------------------------------|

| Check | Task | Equipment | Room ID | Notes |
|-------------------------------------|--|--|------------------------------|---|
| <input checked="" type="checkbox"/> | Verify electrical power design matches the field/record. Identify locations of the electrical equipment. | Electrical Source Panel Name/Number: MPPE Source Breaker Name/Number: Circuit #4, 3PH Electrical AFC Panel Name/Number: F | C207 C207 C207 | C207 is Electrical Equipment Room located on Mezzanine Level. Room C207 is located inside of room C204. |
| <input checked="" type="checkbox"/> | Is there a disconnect switch connected to the AFC electrical power panel? Low or High voltage SMNT/POWR escorts required? | Disconnect Name/Number: SMNT/POWR escorts: LOW Voltage | | |
| <input checked="" type="checkbox"/> | Check if there is a shared raceway between AFC Panel and Kiosk and identify additional source panels to de-energize | Do AFC Panel loads feed into a shared raceway e.g. trench or trough? If Yes, specify source panels in notes. NO | | |
| <input checked="" type="checkbox"/> | Identify the assumed pathway of the duct, the location of the handholes, manholes and boxes and accessibility or special escort requirement? | PLNT <input checked="" type="checkbox"/> COMM / IT <input type="checkbox"/> ELES <input type="checkbox"/> RAIL <input type="checkbox"/> CMNT <input type="checkbox"/> Other Access/Support: | | |
| <input checked="" type="checkbox"/> | Identify handhole or manhole access requirement. | Required PLNT Support for handhole/manhole access? YES (see notes) Identified Conduit/Duct Transition to mezzanine level? YES | | All conduits/duct on same level (Mezzanine) |


Emergency Power Verification

| Check | Task | YES | NO | NA | Comments |
|-------------------------------------|--|--------------------------|--------------------------|-------------------------------------|----------|
| <input checked="" type="checkbox"/> | Verification of the electrical plan to the existing schematic if the AFC electrical panel is connected to a Automatic Transfer Switch (ATS) / emergency power source | <input type="checkbox"/> | <input type="checkbox"/> | <input checked="" type="checkbox"/> | |

Notes and Discrepancies:

| | | |
|-------------------|---|-------------------|
| Sign Off | GFP Representative | WMATA PRGM |
| Name: | Tino Sahoo | |
| Signature: |  | |
| Date: | 08/28/2014 | |

Mt. Vernon Photo #1 – AFC Panel (F) - Room C207 (Mezzanine Level)

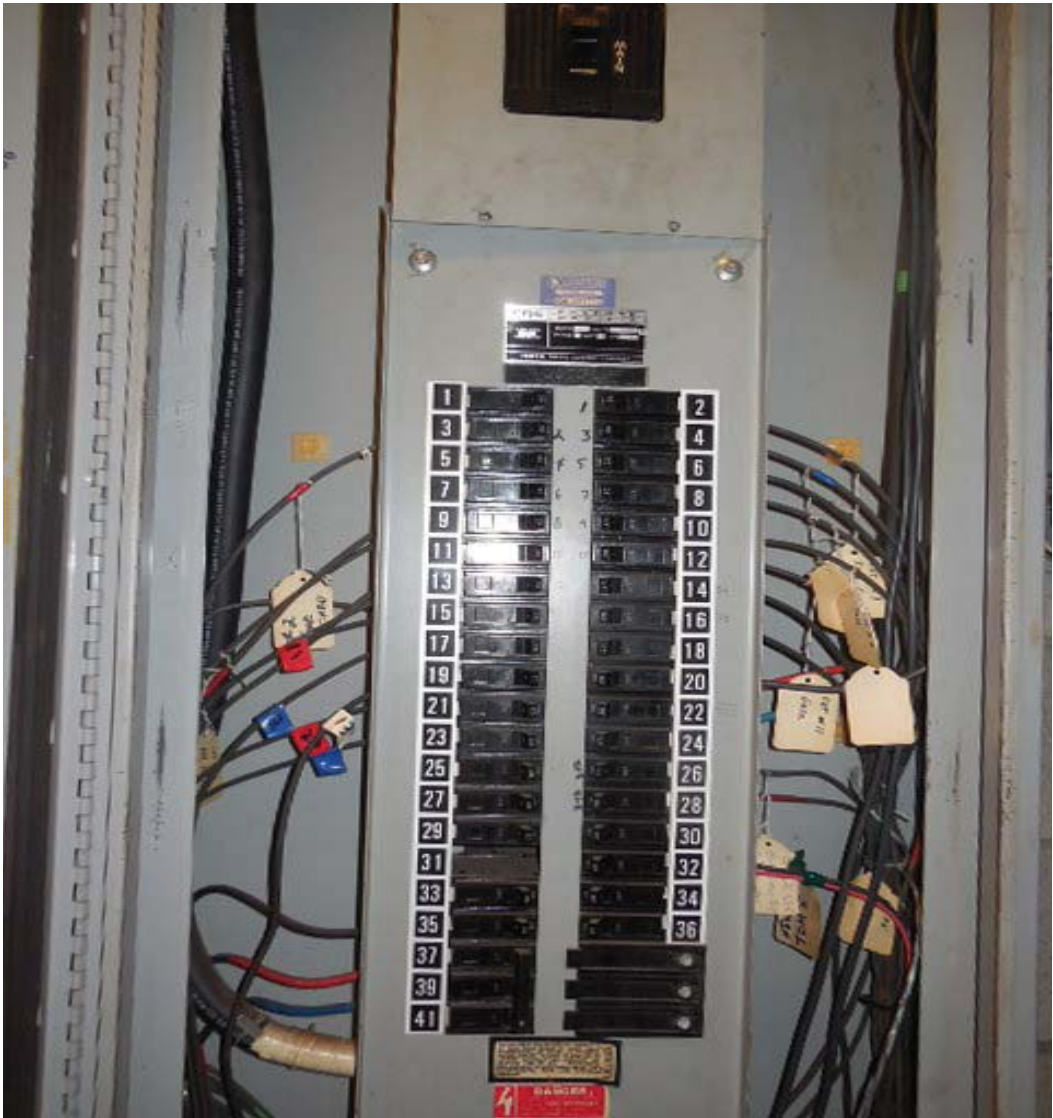

Mt. Vernon Photo #2 – AFC Panel (F) Panel Schedule

PANEL DIRECTOR

- | | |
|--------------------|-------------------------------|
| 1. KIOSK ESSENTIA | 2. FV 1541 (32) |
| 3. FV 1544 (33) | 4. FV 1845 (34) |
| 5. FV 1832 (35) | 6. AF 2814 (51) |
| 7. AF 2815 (50) | 8. NG 3810 (18) |
| 9. RG 7844 (17) | 10. RG 7843 (16) |
| 11. RG 7824 (15) | 12. RG 7822 (14) |
| 13. RG 7492 (13) | 14. FV 1851 (30) |
| 15. RG 7485 (10) | 16. FV 1810 (31) |
| 17. RG 7494 (11) | 18. |
| 19. RG 7483 (12) | 20. CCTV AXIS CAMERAS HERE |
| 21. RG 7489 (19) X | 22. |
| 23. NG 5143 (19) N | 24. |
| 25. | 26. SPARE |
| 27. | 28. SPARE |

Mt. Vernon Photo #3 – AFC Panel (F) Walker Duct to transition to Mezzanine Floor



Mt. Vernon Photo #4-- AFC Source Panel (MPPE) located in Room #C207 on Mezzanine Level. Source Breaker (Circuit #4, 3PH) for AFC Panel (F)



Mt. Vernon Photo #5 - AFC Source Panel (MPPE) located in Room #C207 on Mezzanine Level Panel Schedule

PANEL BOARD: MPPE

FED FROM:

| CIR. | LOAD DESCRIPTION |
|------|--|
| 1 | PANEL 'MEL' |
| 2 | FUT. ENTRANCE ESC. PANEL <i>Lights alongside</i> |
| 3 | PASSAGEWAY LIGHTING <i>ESC</i> |
| 4 | PANEL 'F' |
| 5 | SPARE |
| 6 | SPACE |
| 7 | SPARE |
| 8 | SPACE |
| 9 | SPARE <i>PIDS MEZZ SIGN</i> |
| 10 | SPACE <i>ROLL UP DOOR</i> |
| 11 | SPACE <i>PUMP</i> |
| 12 | |
| 13 | SPACE |
| 14 | |
| 15 | |
| 16 | |
| 17 | |
| 18 | |
| 19 | |


Mt. Vernon Photo #6 – Manhole located in hallway of C204 in which walker duct runs through to another manhole in mezzanine area by kiosk. About 81’ from AFC Panel (F).



Mt. Vernon Photo #7 – Handholes located in mezzanine area by kiosk. About 75' from Kiosk.



| ITEM | QTY | NO. | PANEL | TYPE |
|------------------|-----|--------|-------|------|
| 1 VENDOR | | FV1851 | F | 2 |
| 2 VENDOR | | FV1810 | F | 3 |
| 3 VENDOR | | FV1845 | F | 4 |
| 4 VENDOR | | FV1832 | F | 5 |
| 5 ACCESS | | AF2814 | F | 6 |
| 6 ACCESS | | AF2815 | F | 7 |
| 7 ENTRY GATE | | EG3810 | F | 8 |
| 8 REV. GATE | | RG7844 | F | 9 |
| 9 REV. GATE | | RG7843 | F | 10 |
| 10 REV. GATE | | RG7824 | F | 11 |
| 11 REV. GATE | | RG7822 | F | 12 |
| 12 EXIT GATE | | XG4807 | | |
| 13 SMADS | | SM8808 | KE | 1 |
| 14 CLOCK | | 98911 | KES | 8 |
| Emergency Lights | | | KE | 4 |

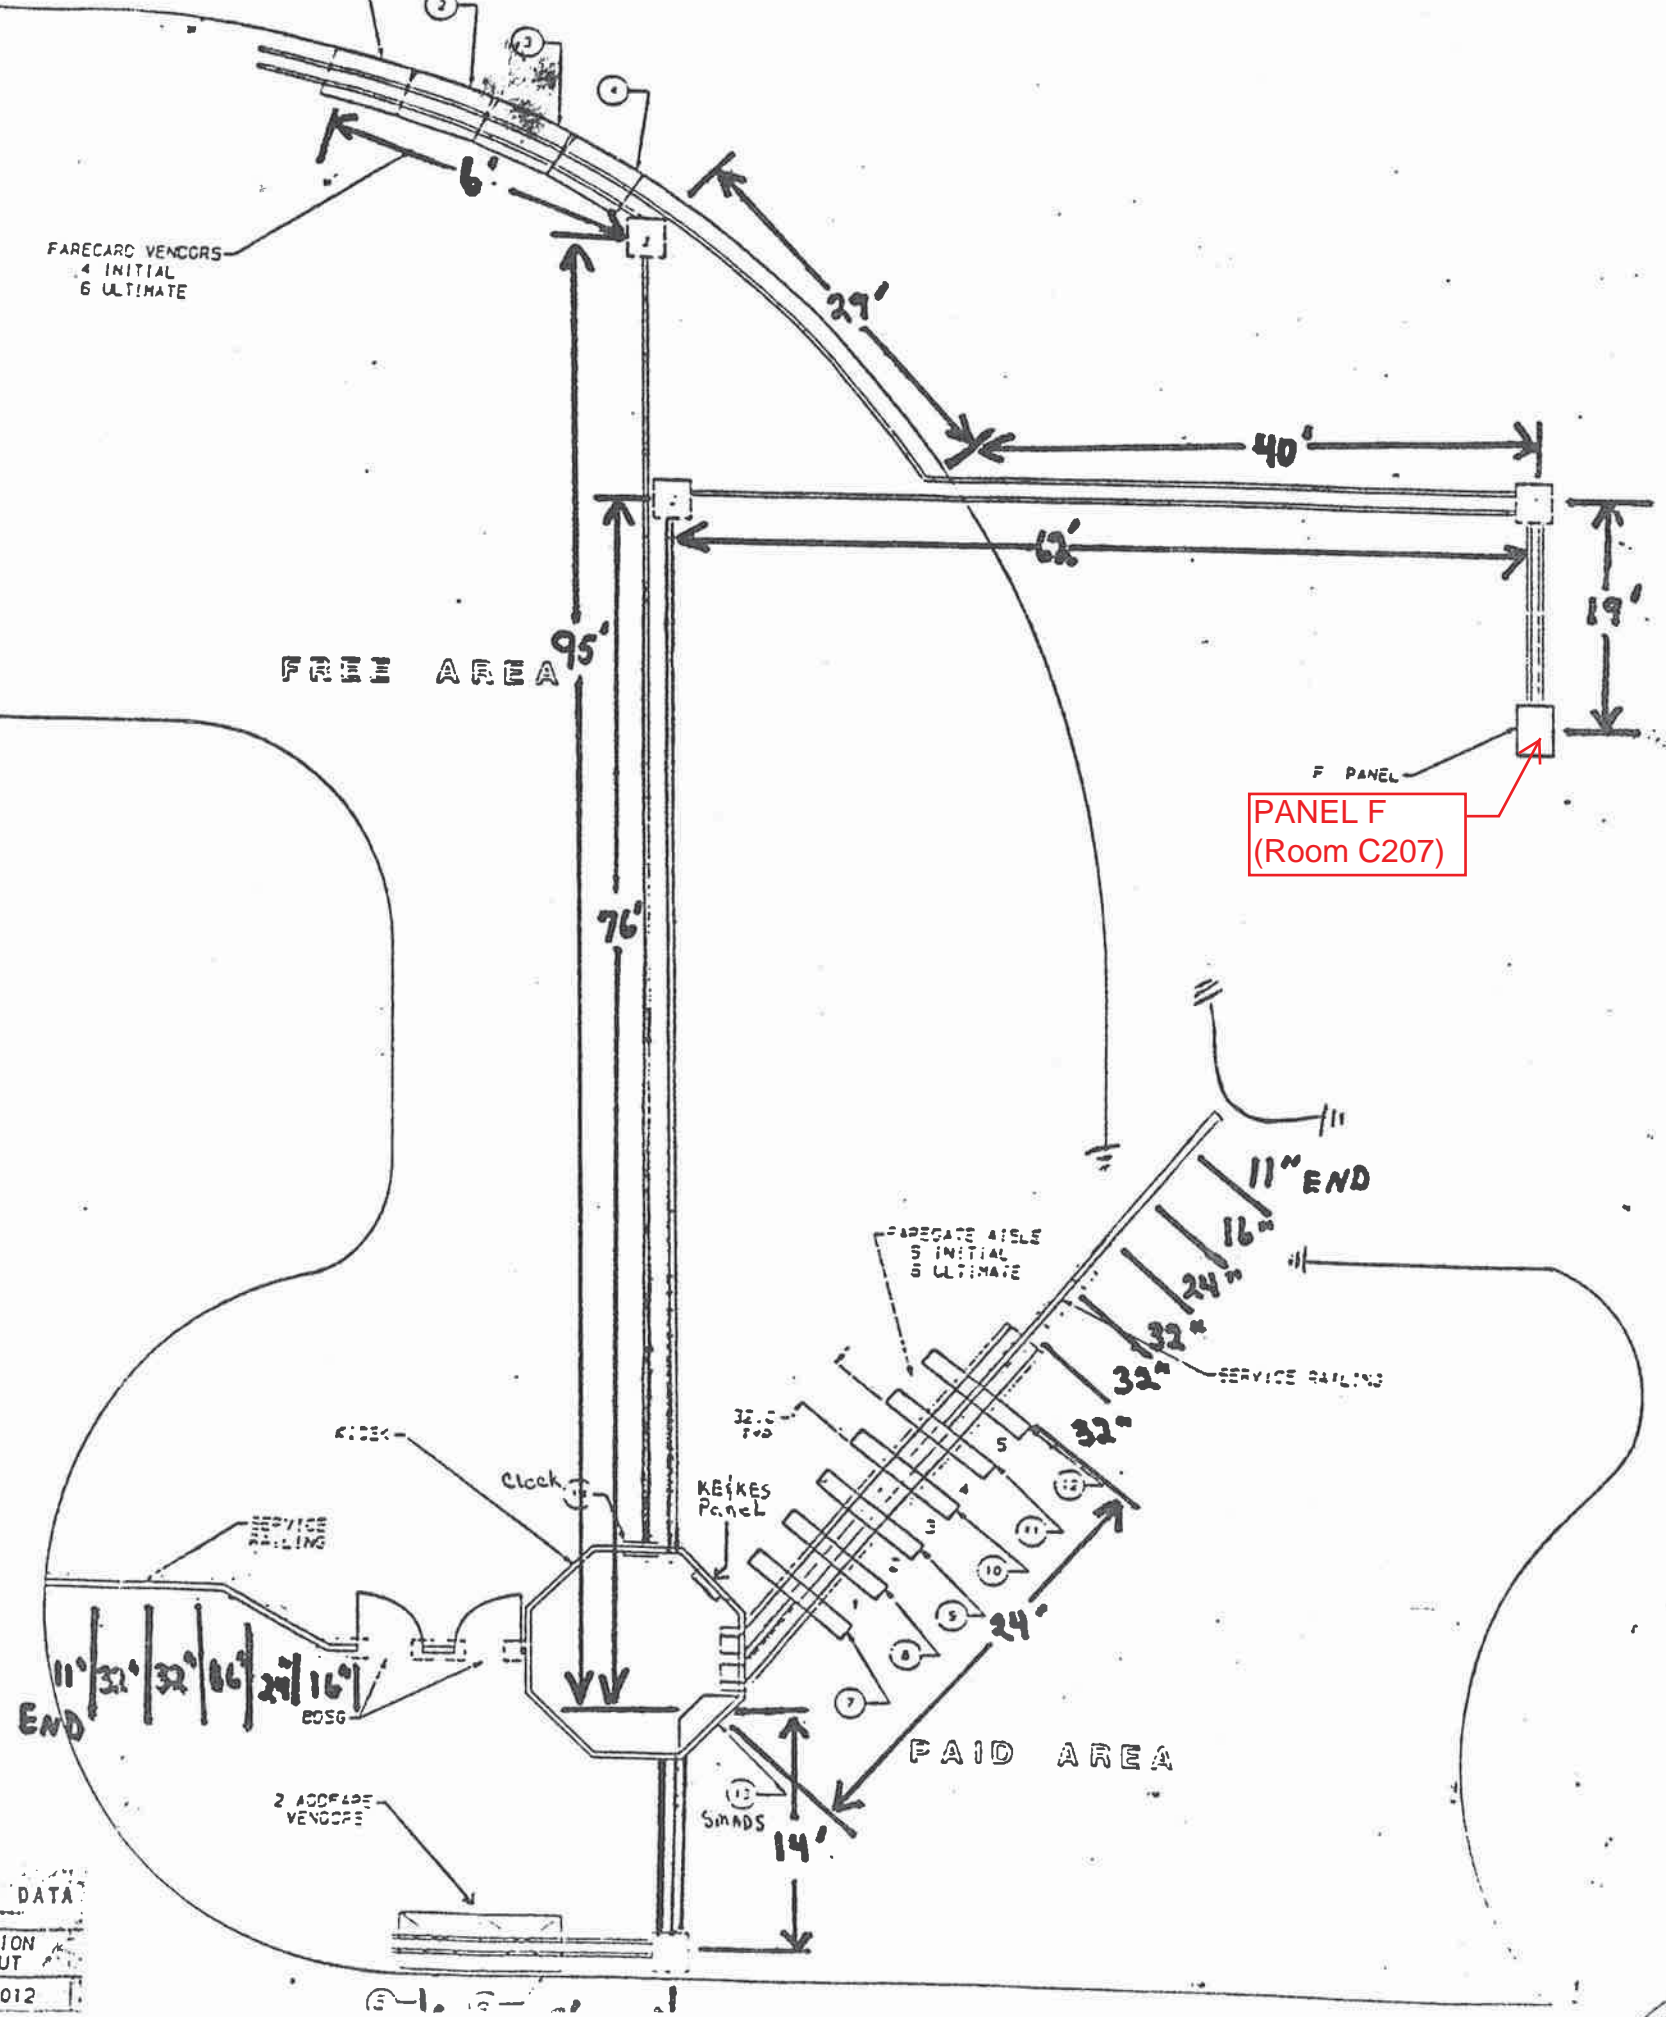

SEE SEPARATE PL. WHEN ITEM NUMBERS ARE USED THE DESIGNATOR MAY BE USED IN LIEU OF ITEM NUMBERS.


| NO. | QTY | NO. | TYPE |
|-----|-----|-----|------|
| 1 | 1 | 1 | 1 |
| 2 | 1 | 2 | 2 |
| 3 | 1 | 3 | 3 |
| 4 | 1 | 4 | 4 |
| 5 | 1 | 5 | 5 |
| 6 | 1 | 6 | 6 |
| 7 | 1 | 7 | 7 |
| 8 | 1 | 8 | 8 |
| 9 | 1 | 9 | 9 |
| 10 | 1 | 10 | 10 |
| 11 | 1 | 11 | 11 |
| 12 | 1 | 12 | 12 |
| 13 | 1 | 13 | 13 |
| 14 | 1 | 14 | 14 |

DATE: 12/07/1993
 CUBIC WESTERN DATA
 MT. VERNON STATION
 MEZZANINE LAYOUT
 931-4012

| ZONE REV | DESCRIPTION | DATE | APPROVED |
|----------|-------------------------|----------|----------|
| A | INITIAL RELEASE | 01/10/52 | R. KUIE |
| B | DCN 028898 BJC 04/03/52 | | |

NOTES:

1. FOR VENDOR AND ADDFARE INSTALLATION SEE 931-4002.
2. FOR SMADS INSTALLATION SEE 931-4001.
3. FOR ENTRY, EXIT AND REVERSIBLE GATE INSTALLATION SEE 931-4003.
4. FOR BI-DIRECTIONAL SERVICE GATE INSTALLATION SEE 931-4005.
5. FOR A TYPICAL MEZZANINE INSTALLATION SEE 931-4000.
6. CIRCUIT BREAKERS WITH COMMON NEUTRAL:
2, 3 & 4; 6 & 7; 8, 9 & 10; 11 & 12.

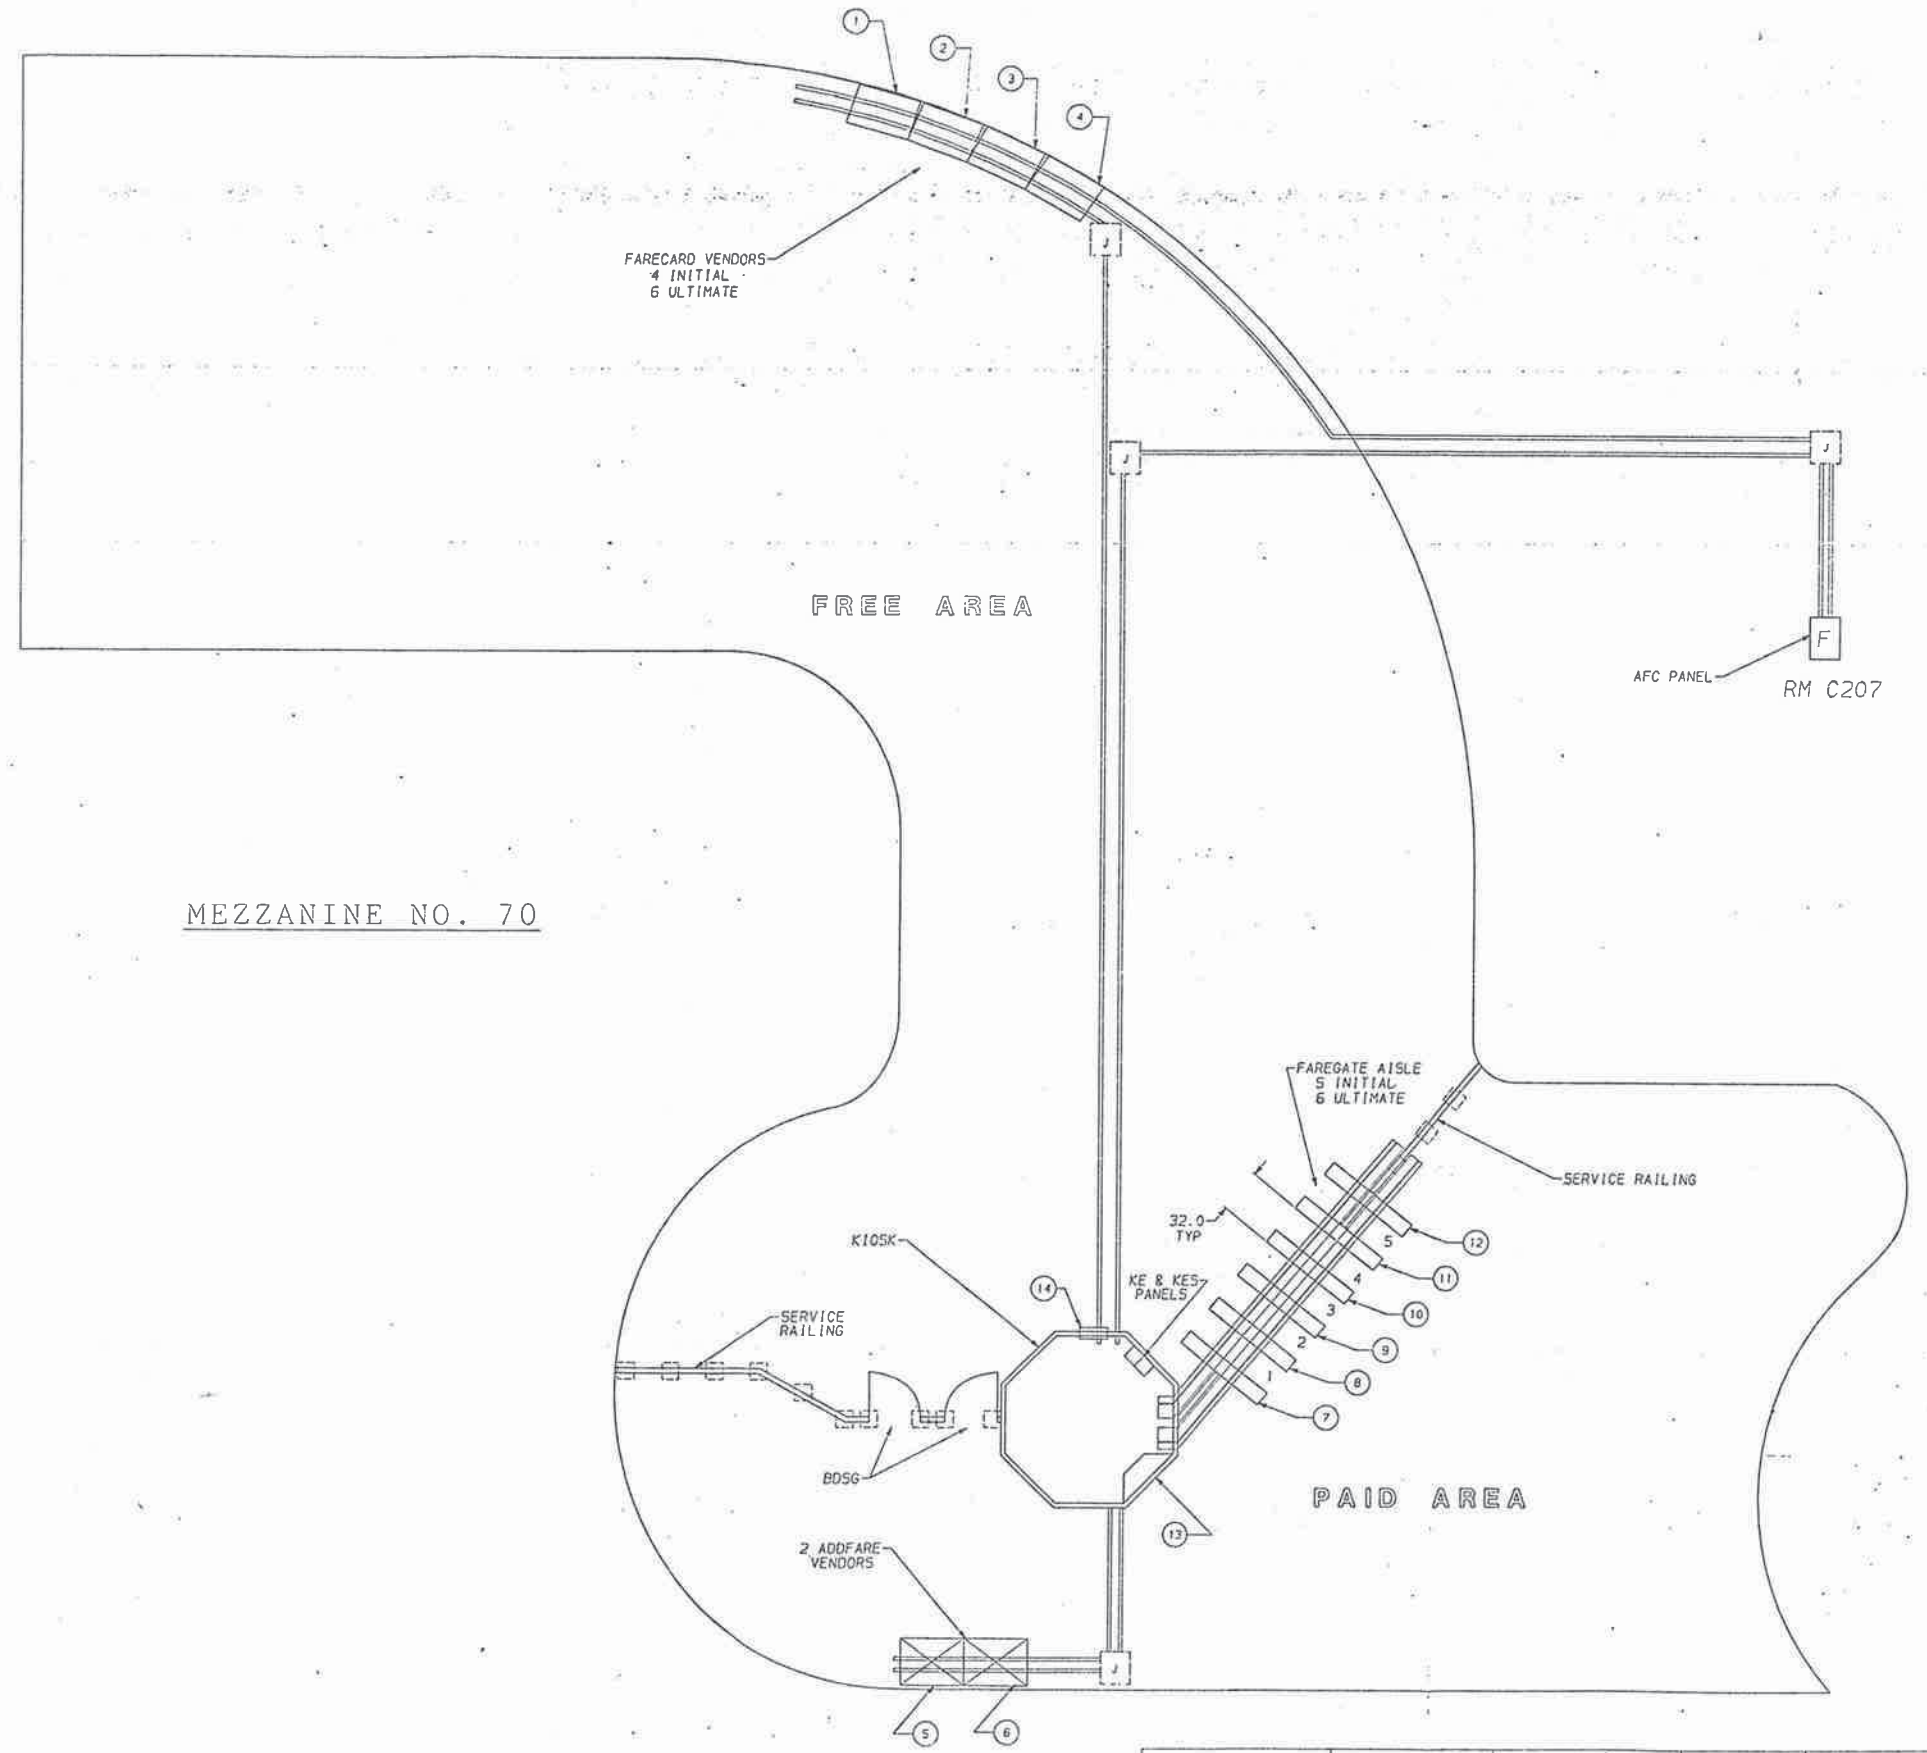

MEZZANINE NO. 70

| ITEM | NAME | S/N | PANEL AFC | KIOSK EMERGENCY BREAKER |
|------|--------------|-------|-----------|-------------------------|
| 1 | VENDOR | 1851 | F | 2 |
| 2 | VENDOR | 1810 | F | 3 |
| 3 | VENDOR | 1845 | F | 4 |
| 4 | VENDOR | 1832 | F | 5 |
| 5 | ADDFARE | 2814 | F | 6 |
| 6 | ADDFARE | 2815 | F | 7 |
| 7 | ENTRY GATE | 3810 | F | 8 |
| 8 | REV. GATE | 7844 | F | 9 |
| 9 | REV. GATE | 7843 | F | 10 |
| 10 | REV. GATE | 7809 | F | 11 |
| 11 | REV. GATE | 7807 | F | 12 |
| 12 | EXIT GATE | 4807 | F | N/A |
| 13 | SMADS | 8808 | KE | 1 |
| 14 | CLOCK | 58911 | KES | 8 |
| 15 | EMERGENCY LT | | KE | 4 |

| SEE SEPARATE PL WHEN ITEM NUMBERS ARE USED (REF DESIGNATOR MAY BE USED IN LIEU OF ITEM NUMBERS) | <table border="1"> <thead> <tr> <th>HOLE DIA</th> <th>TOLERANCES</th> </tr> </thead> <tbody> <tr><td>.0125 thru .125</td><td>+ .004 - .001</td></tr> <tr><td>.126 thru .250</td><td>+ .002 - .001</td></tr> <tr><td>.251 thru .500</td><td>+ .001 - .001</td></tr> <tr><td>.501 thru .750</td><td>+ .001 - .001</td></tr> <tr><td>.751 thru 1.000</td><td>+ .001 - .001</td></tr> </tbody> </table> | HOLE DIA | TOLERANCES | .0125 thru .125 | + .004 - .001 | .126 thru .250 | + .002 - .001 | .251 thru .500 | + .001 - .001 | .501 thru .750 | + .001 - .001 | .751 thru 1.000 | + .001 - .001 | <table border="1"> <thead> <tr> <th>UNLESS OTHERWISE SPECIFIED DIMENSIONS ARE IN INCHES</th> <th>TOLERANCES</th> </tr> </thead> <tbody> <tr><td>LENGTH</td><td>+ .004 - .004</td></tr> <tr><td>ANGLE</td><td>+ .010 - .010</td></tr> <tr><td>RADIUS</td><td>+ .004 - .004</td></tr> <tr><td>DIAMETER</td><td>+ .004 - .004</td></tr> </tbody> </table> | UNLESS OTHERWISE SPECIFIED DIMENSIONS ARE IN INCHES | TOLERANCES | LENGTH | + .004 - .004 | ANGLE | + .010 - .010 | RADIUS | + .004 - .004 | DIAMETER | + .004 - .004 | <table border="1"> <thead> <tr> <th>FILE NO.</th> <th>DATE</th> <th>APPROVALS</th> </tr> </thead> <tbody> <tr> <td>931-4000</td> <td></td> <td></td> </tr> </tbody> </table> | FILE NO. | DATE | APPROVALS | 931-4000 | | | <table border="1"> <thead> <tr> <th>DATE</th> <th>BY</th> <th>CHKD</th> <th>APP'D</th> </tr> </thead> <tbody> <tr> <td></td> <td>R. KUIE</td> <td></td> <td></td> </tr> </tbody> </table> | DATE | BY | CHKD | APP'D | | R. KUIE | | | <table border="1"> <tr> <td> </td> <td> MT. VERNON STATION MEZZANINE LAYOUT </td> <td> SHEET NO. 37800 </td> <td> OF 1 </td> </tr> </table> | | MT. VERNON STATION MEZZANINE LAYOUT | SHEET NO. 37800 | OF 1 |
|---|
| HOLE DIA | TOLERANCES | | | | | | | | | | | | | | | | | | | | | | | | | | | | | | | | | | | | | | | | | | | | |
| .0125 thru .125 | + .004 - .001 | | | | | | | | | | | | | | | | | | | | | | | | | | | | | | | | | | | | | | | | | | | | |
| .126 thru .250 | + .002 - .001 | | | | | | | | | | | | | | | | | | | | | | | | | | | | | | | | | | | | | | | | | | | | |
| .251 thru .500 | + .001 - .001 | | | | | | | | | | | | | | | | | | | | | | | | | | | | | | | | | | | | | | | | | | | | |
| .501 thru .750 | + .001 - .001 | | | | | | | | | | | | | | | | | | | | | | | | | | | | | | | | | | | | | | | | | | | | |
| .751 thru 1.000 | + .001 - .001 | | | | | | | | | | | | | | | | | | | | | | | | | | | | | | | | | | | | | | | | | | | | |
| UNLESS OTHERWISE SPECIFIED DIMENSIONS ARE IN INCHES | TOLERANCES | | | | | | | | | | | | | | | | | | | | | | | | | | | | | | | | | | | | | | | | | | | | |
| LENGTH | + .004 - .004 | | | | | | | | | | | | | | | | | | | | | | | | | | | | | | | | | | | | | | | | | | | | |
| ANGLE | + .010 - .010 | | | | | | | | | | | | | | | | | | | | | | | | | | | | | | | | | | | | | | | | | | | | |
| RADIUS | + .004 - .004 | | | | | | | | | | | | | | | | | | | | | | | | | | | | | | | | | | | | | | | | | | | | |
| DIAMETER | + .004 - .004 | | | | | | | | | | | | | | | | | | | | | | | | | | | | | | | | | | | | | | | | | | | | |
| FILE NO. | DATE | APPROVALS | | | | | | | | | | | | | | | | | | | | | | | | | | | | | | | | | | | | | | | | | | | |
| 931-4000 | | | | | | | | | | | | | | | | | | | | | | | | | | | | | | | | | | | | | | | | | | | | | |
| DATE | BY | CHKD | APP'D | | | | | | | | | | | | | | | | | | | | | | | | | | | | | | | | | | | | | | | | | | |
| | R. KUIE | | | | | | | | | | | | | | | | | | | | | | | | | | | | | | | | | | | | | | | | | | | | |
| | MT. VERNON STATION MEZZANINE LAYOUT | SHEET NO. 37800 | OF 1 | | | | | | | | | | | | | | | | | | | | | | | | | | | | | | | | | | | | | | | | | | |

EXISTING PANEL "F"

| | | |
|-----------------|----------------|--|
| AMPERES: 225 | VOLTS: 120/208 | MOUNTING: SURFACE |
| MAINS: 225A MCB | PHASE: 3 | LOCATION: ELECTRICAL EQUIPMENT ROOM C207 |
| RATING: 10K AIC | WIRE: 4 | SECTION: 1 OF 1 |

| LOAD DESCRIPTION | KVA | CKT BKRS | | CKT. NO. | | CKT. NO. | CKT BKRS | | KVA | LOAD DESCRIPTION |
|---------------------------------|-----|----------|------|----------|-------|----------|----------|-----|-----|------------------|
| | | AMP | POLE | | | | POLE | AMP | | |
| SPARE | 0.0 | 20 | 1 | 1 | A - - | 2 | 1 | 20 | 0.8 | EXISTING VENDOR |
| EXISTING VENDOR | 0.8 | 20 | 1 | 3 | - B - | 4 | 1 | 20 | 0.8 | EXISTING VENDOR |
| SPARE | 0.0 | 20 | 1 | 5 | - - C | 6 | 1 | 20 | 0.8 | EXISTING VENDOR |
| EXISTING VENDOR | 0.8 | 20 | 1 | 7 | A - - | 8 | 1 | 20 | 0.8 | EXISTING VENDOR |
| EXISTING VENDOR | 0.8 | 20 | 1 | 9 | - B - | 10 | 1 | 20 | 0.8 | EXISTING VENDOR |
| EXISTING VENDOR | 0.8 | 20 | 1 | 11 | - - C | 12 | 1 | 20 | 0.8 | EXISTING VENDOR |
| EXISTING VENDOR | 0.8 | 20 | 1 | 13 | A - - | 14 | 1 | 20 | 0.8 | EXISTING VENDOR |
| EXISTING VENDOR | 0.8 | 20 | 1 | 15 | - B - | 16 | 1 | 20 | 0.8 | EXISTING VENDOR |
| EXISTING VENDOR | 0.8 | 20 | 1 | 17 | - - C | 18 | 1 | 20 | 0.0 | SPARE |
| EXISTING VENDOR | 0.8 | 20 | 1 | 19 | A - - | 20 | 1 | 20 | 0.8 | EXISTING VENDOR |
| EXISTING VENDOR | 0.8 | 20 | 1 | 21 | - B - | 22 | 1 | 20 | 0.8 | EXISTING VENDOR |
| EXISTING VENDOR | 0.8 | 20 | 1 | 23 | - - C | 24 | 1 | 20 | 0.8 | EXISTING VENDOR |
| 1 NEW KIOSK RECEPT. (IT & NEPP) | 0.8 | 20 | 1 | 25 | A - - | 26 | 1 | 20 | 0.8 | EXISTING VENDOR |
| 1&2 SPARE (KIOSK) | 0.0 | 20 | 1 | 27 | - B - | 28 | 1 | 20 | 0.8 | EXISTING VENDOR |
| SPARE | 0.0 | 20 | 1 | 29 | - - C | 30 | 1 | 20 | 0.0 | SPARE |
| SPACE | 0.0 | 20 | 1 | 31 | A - - | 32 | 1 | 20 | 0.8 | EXISTING VENDOR |
| EXISTING VENDOR | 0.8 | 20 | 1 | 33 | - B - | 34 | 1 | 20 | 0.8 | EXISTING VENDOR |
| EXISTING VENDOR | 0.8 | 20 | 1 | 35 | - - C | 36 | 1 | 20 | 0.0 | SPARE |
| EXIST. KIOSK LOAD CENTER "KES" | 3.3 | 40 | 3 | 37 | A - - | 38 | - | - | 0.0 | SPACE |
| | 2.5 | - | - | 39 | - B - | 40 | - | - | 0.0 | SPACE |
| | 2.5 | - | - | 41 | - - C | 42 | - | - | 0.0 | SPACE |
| | 0.0 | - | - | 43 | A - - | 44 | - | - | 0.0 | - |

NOTES: 1. CONNECT NEW FEEDER TO EXISTING SPARE 20A, 1P CB
2. CB TO BE RESERVED FOR FUTURE AFC

LOAD SUMMARY

| | | |
|-------------------------------------|-----------------|------------------------------------|
| LIGHTS | 0.0 x 125% | 0.0 KVA |
| RECEPTACLES, FIRST 10 KVA | 10.0 x 100% | 10.0 KVA |
| RECEPTACLES | 13.2 x 50% | 6.6 KVA |
| MISC. APPLIANCES | 0.0 x 100% | 0.0 KVA |
| LARGEST MOTOR | 0.0 x 125% | 0.0 KVA |
| MOTORS | 0.0 x 100% | 0.0 KVA |
| HEAT | 3.0 x 125% | 3.8 KVA |
| AC | 4.5 x 100% | 4.5 KVA |
| WATER HEATING | 0.0 x 125% | 0.0 KVA |
| TOTAL CONNECTED LOAD | 30.7 KVA | TOTAL DEMAND KVA 24.9 KVA |
| | | TOTAL DEMAND AMPS 69.0 AMPS |
| CONNECTED LOAD PHASE SUMMARY | | |
| PHASE A: | 11.3 KVA | |
| PHASE B: | 11.3 KVA | |
| PHASE C: | 5.6 KVA | |

NOTES: A. EXISTING PANEL "F" IS FED FROM 120/208V, 3Ø, 4W EXISTING PANEL "MPPE" LOCATED IN ELECTRICAL EQUIPMENT RM. C207, #4-225/3P (SEE ATTACHED DWG. MM-E-E06).
 B. EXISTING WIRING FED FROM TOP OF PANEL BY:
 * 1-4" C. TO PANEL "MPPE" (WIRING FILL >40%).
 EXISTING WIRING FED FROM BOTTOM OF PANEL BY:
 * 2-6 1/2" x 1 1/2" FLOOR DUCT (WIRING FILL >40%).
 * 2-3/4" C. (WIRING FILL >40%).

CONTRACT NO
14-FQ10060-CENI-24

| | | | | | |
|---|---------------|--------------------|-------------|-----------|----|
| DESIGNED C. MOO DRAWN C. MOO CHECKED B. DEB APPROVED J/A | 06-14 DATE | REFERENCE DRAWINGS | | REVISIONS | |
| | 08-14 DATE | NUMBER | DESCRIPTION | DATE | BY |
| | 08-14 DATE | | | | |
| | 08-14 DATE | | | | |

WASHINGTON METROPOLITAN AREA TRANSIT AUTHORITY

DEPARTMENT OF TRANSIT INFRASTRUCTURE AND ENGINEERING SERVICES
OFFICE OF INFRASTRUCTURE RENEWAL PROGRAM


A Goodall Fleming/Parsons
JOINT VENTURE

APPROVED _____ SUBMITTED _____ PROJECT MANAGER

**NEW ELECTRONIC PAY PROGRAM (NEPP)
IN METRORAIL STATIONS**

MT VERNON SQUARE
PANEL SCHEDULE

SCALE: NOT TO SCALE DRAWING NO: E01-E-102

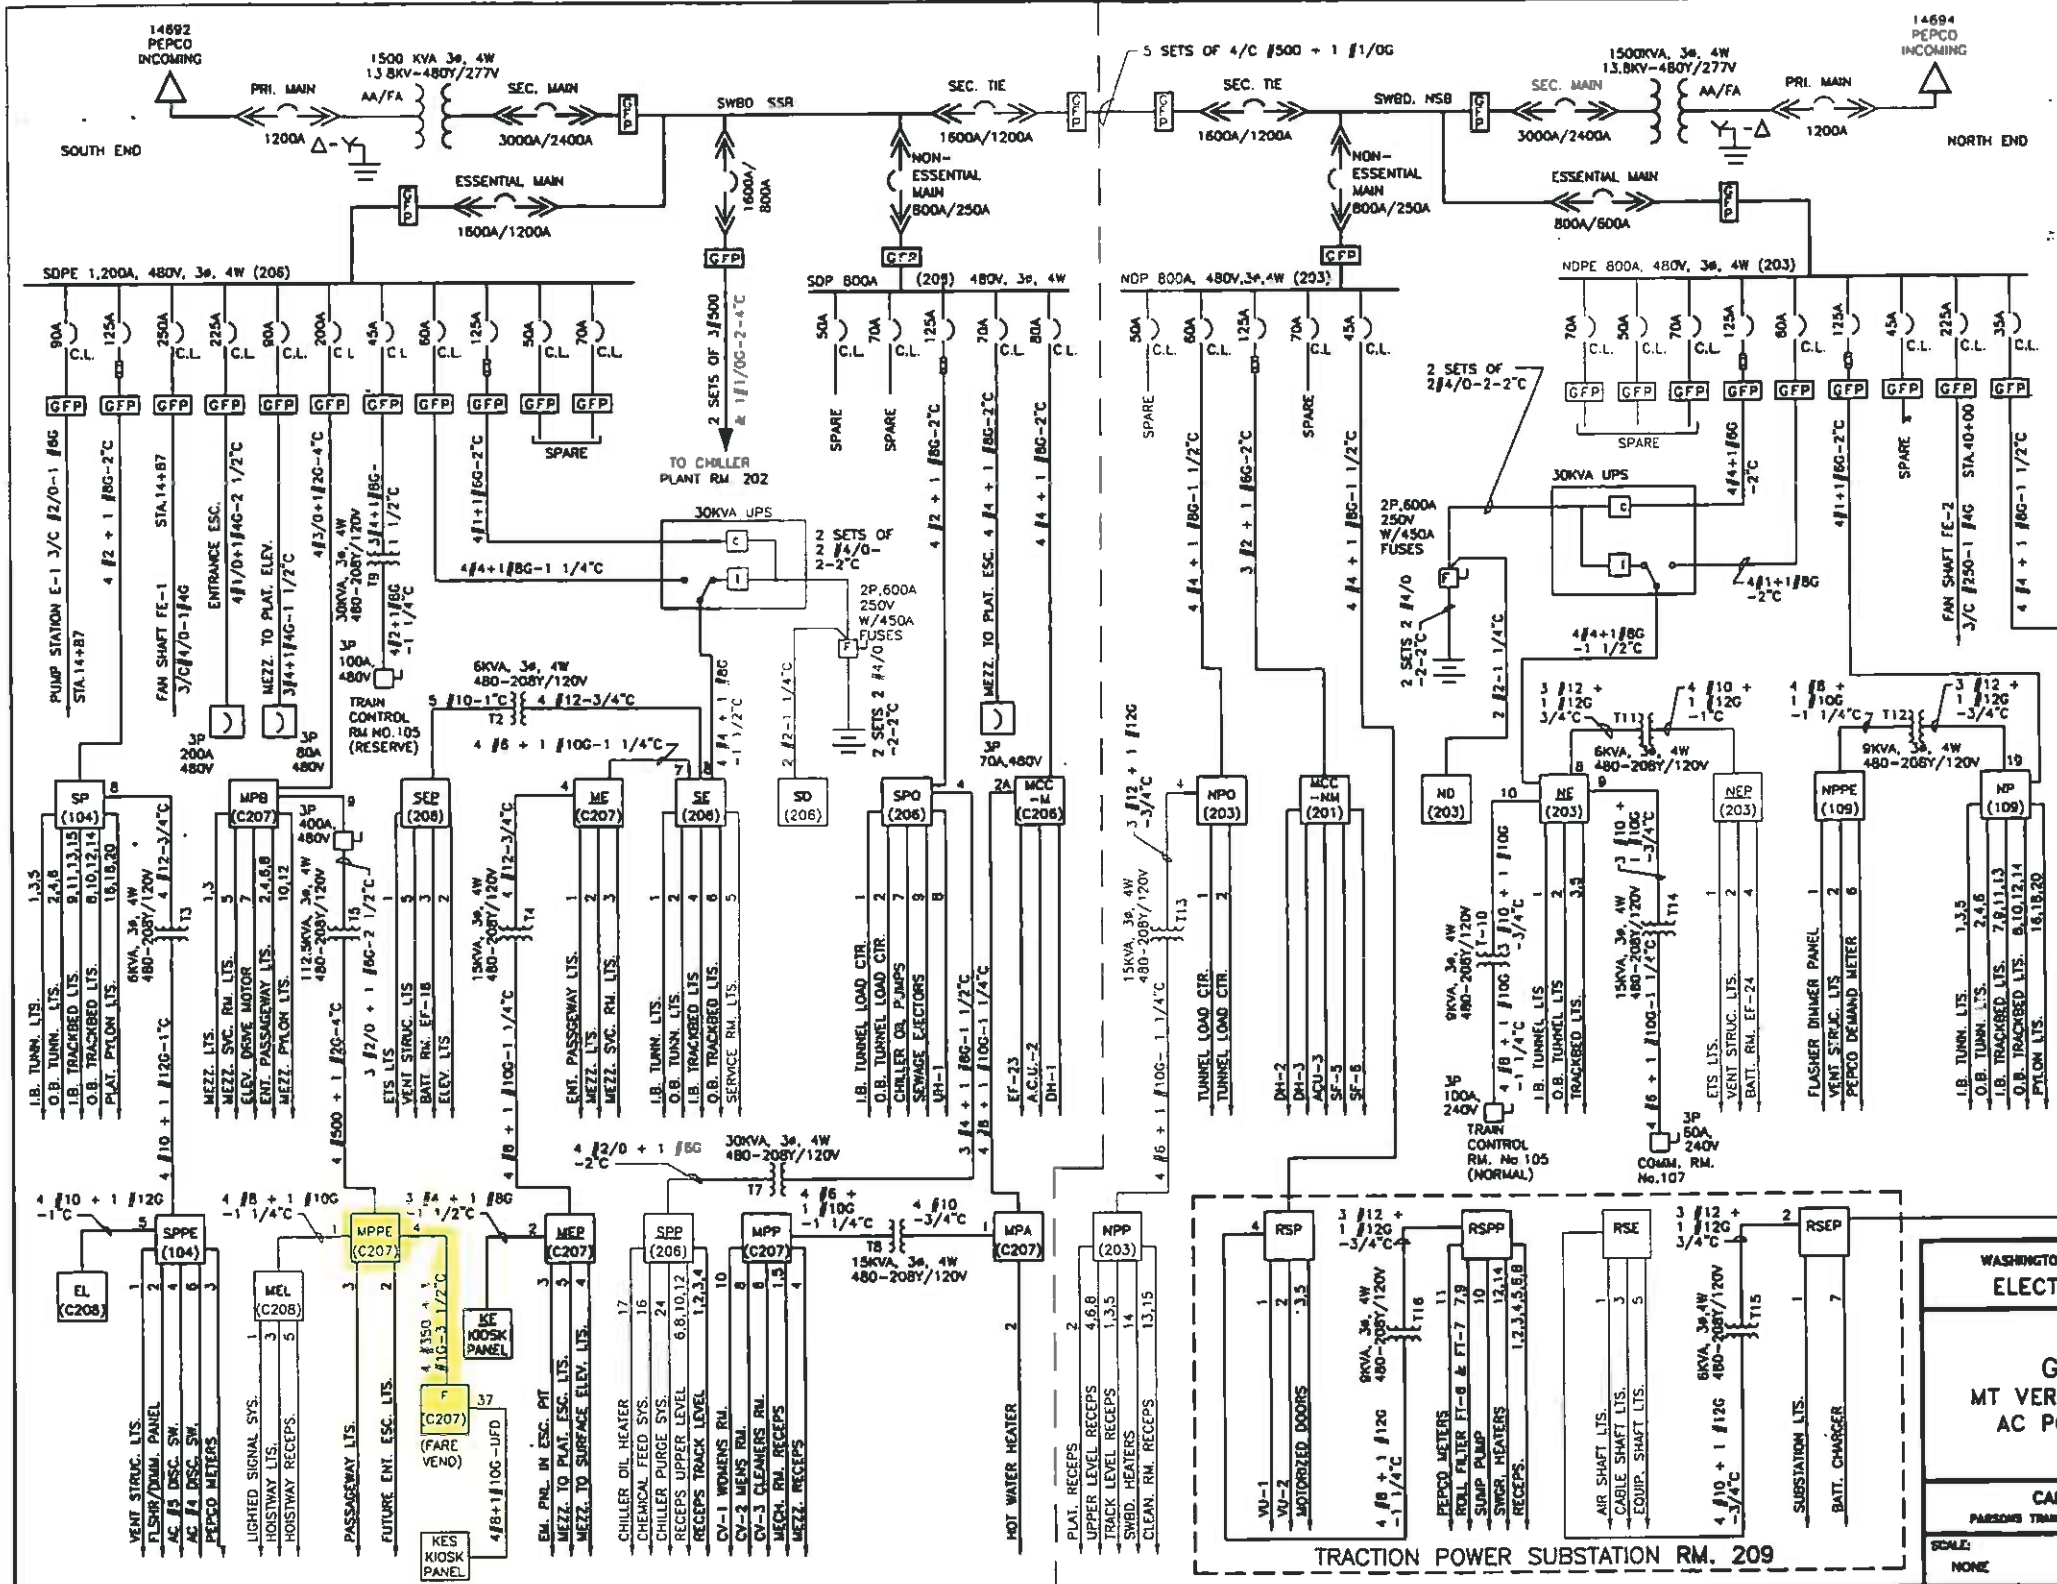

NOTES:

1. PANEL DESIGNATION WHEN UNDERLINED IS EMERGENCY

WEA (205) (LIGHTING)

B (CIRCUIT NUMBER)

* WHEN NO CXTS SHOWN
2. 3#2. 2" CONDUIT SIZE

AWG OR KCMIL CIRCUIT WIRES

* AS TAKEN FROM AS BUILT DWGS.
3. CIRCUIT BREAKERS

DRAW OUT 1600A/1200A MOLDED CASE

FRAME SIZE CONTINUOUS CURRENT SETTING
4. 4/C # 4/0

INDICATES MULTICONDUCTOR CABLE WITH 4 CONDUCTORS AND SIZE OF EACH 4/0
5. [] INDICATES FUSE CURRENT LIMITER AT BREAKER

C.L. INDICATES FUSELESS CURRENT LIMITING
6. SWITCHGEAR INFORMATION:

a. MANUFACTURER: FEDERAL PACIFIC

b. SERVICE ORDER NUMBER:

(1) NORTH A.C. RM.: 085-06-089-2

(2) SOUTH A.C. RM.: 085-06-089-1
7. UPS MANUFACTURER: HDR POWER SYSTEMS
8. ROOM DESIGNATIONS:

| ROOM | DESCRIPTION |
|------|---------------------------|
| 105 | TRAIN CONTROL RM. |
| 107 | COMM. RM. |
| 109 | OPERATIONS RM. |
| 201 | N. MECH. RM. |
| 202 | CHILLER PLANT |
| 203 | N. A.C. SWBD. RM. |
| 206 | S. A.C. SWBD. RM. |
| 209 | TRACTION POWER SUBSTATION |
| C206 | MEZZ. MECH. RM. |
| C207 | MEZZ. ELEC. RM. |
| C208 | MEZZ. ELEV. MACH. RM. |

REVISIONS

| DATE | BY | DESCRIPTION |
|------|----|-------------|
| | | |

WASHINGTON METROPOLITAN AREA TRANSIT AUTHORITY
ELECTRICAL MAINTENANCE MAP

GREENBELT ROUTE
MT VERNON SQUARE/UDC STATION
AC POWER ONE LINE DIAGRAM

CAPITAL IMPROVEMENT PROGRAM
PARSONS TRANSPORTATION GROUP - CAPITAL TRANSIT CONSULTANTS

SCALE: NONE
DRAWING No. MM-E-E06

Pre-Inspection Mezzanine Walkthrough Checklist

Date: 09/30/2014 **Station Name:** E02 Shaw-Howard U (S) **Mezzanine #** 071 **Completed By:** Tino Sahoo

| Check | Task | Equipment | Room ID | Notes |
|-------------------------------------|--|---|---------------------------|--|
| <input checked="" type="checkbox"/> | Verify electrical power design matches the field/record. Identify locations of the electrical equipment. | Electrical Source Panel Name/Number: Essential SWBD LOAD Source Breaker Name/Number: "PANEL SF" Circuit #5 Electrical AFC Panel Name/Number: SF | 220 220 208 | AC Switchboard room is located on platform level, Track 2 wayside. |
| <input checked="" type="checkbox"/> | Is there a disconnect switch connected to the AFC electrical power panel? Low or High voltage SMNT/POWR escorts required? | Disconnect Name/Number: N/A SMNT/POWR escorts: HIGH Voltage | | Kiosk Emergency Panel is Panel SKE (Kiosk). Source Panel is Panel SMEP (Rm. 208) and circuit #6. |
| <input checked="" type="checkbox"/> | Check if there is a shared raceway between AFC Panel and Kiosk and identify additional source panels to de-energize | Do AFC Panel loads feed into a shared raceway e.g. trench or trough? If Yes, specify source panels in notes. NO | | |
| <input checked="" type="checkbox"/> | Identify the assumed pathway of the duct, the location of the handholes, manholes and boxes and accessibility or special escort requirement? | PLNT <input checked="" type="checkbox"/> COMM / IT <input type="checkbox"/> ELES <input type="checkbox"/> RAIL <input type="checkbox"/> CMNT <input type="checkbox"/> Other Access/Support: | | |
| <input checked="" type="checkbox"/> | Identify handhole or manhole access requirement. | Required PLNT Support for handhole/manhole access? YES (see notes) Identified Conduit/Duct Transition to mezzanine level? YES | | Access to multiple handholes are required. |

Emergency Power Verification

| Check | Task | YES | NO | NA | Comments |
|-------------------------------------|--|--------------------------|--------------------------|-------------------------------------|----------|
| <input checked="" type="checkbox"/> | Verification of the electrical plan to the existing schematic if the AFC electrical panel is connected to a Automatic Transfer Switch (ATS) / emergency power source | <input type="checkbox"/> | <input type="checkbox"/> | <input checked="" type="checkbox"/> | |

Notes and Discrepancies:


| | | |
|-------------------|---|-------------------|
| Sign Off | GFP Representative | WMATA PRGM |
| Name: | Tino Sahoo | |
| Signature: |  | |
| Date: | 9/30/14 | |

Photo #1: E02 Shaw-Howard U (South) – Panel SF in Room 208

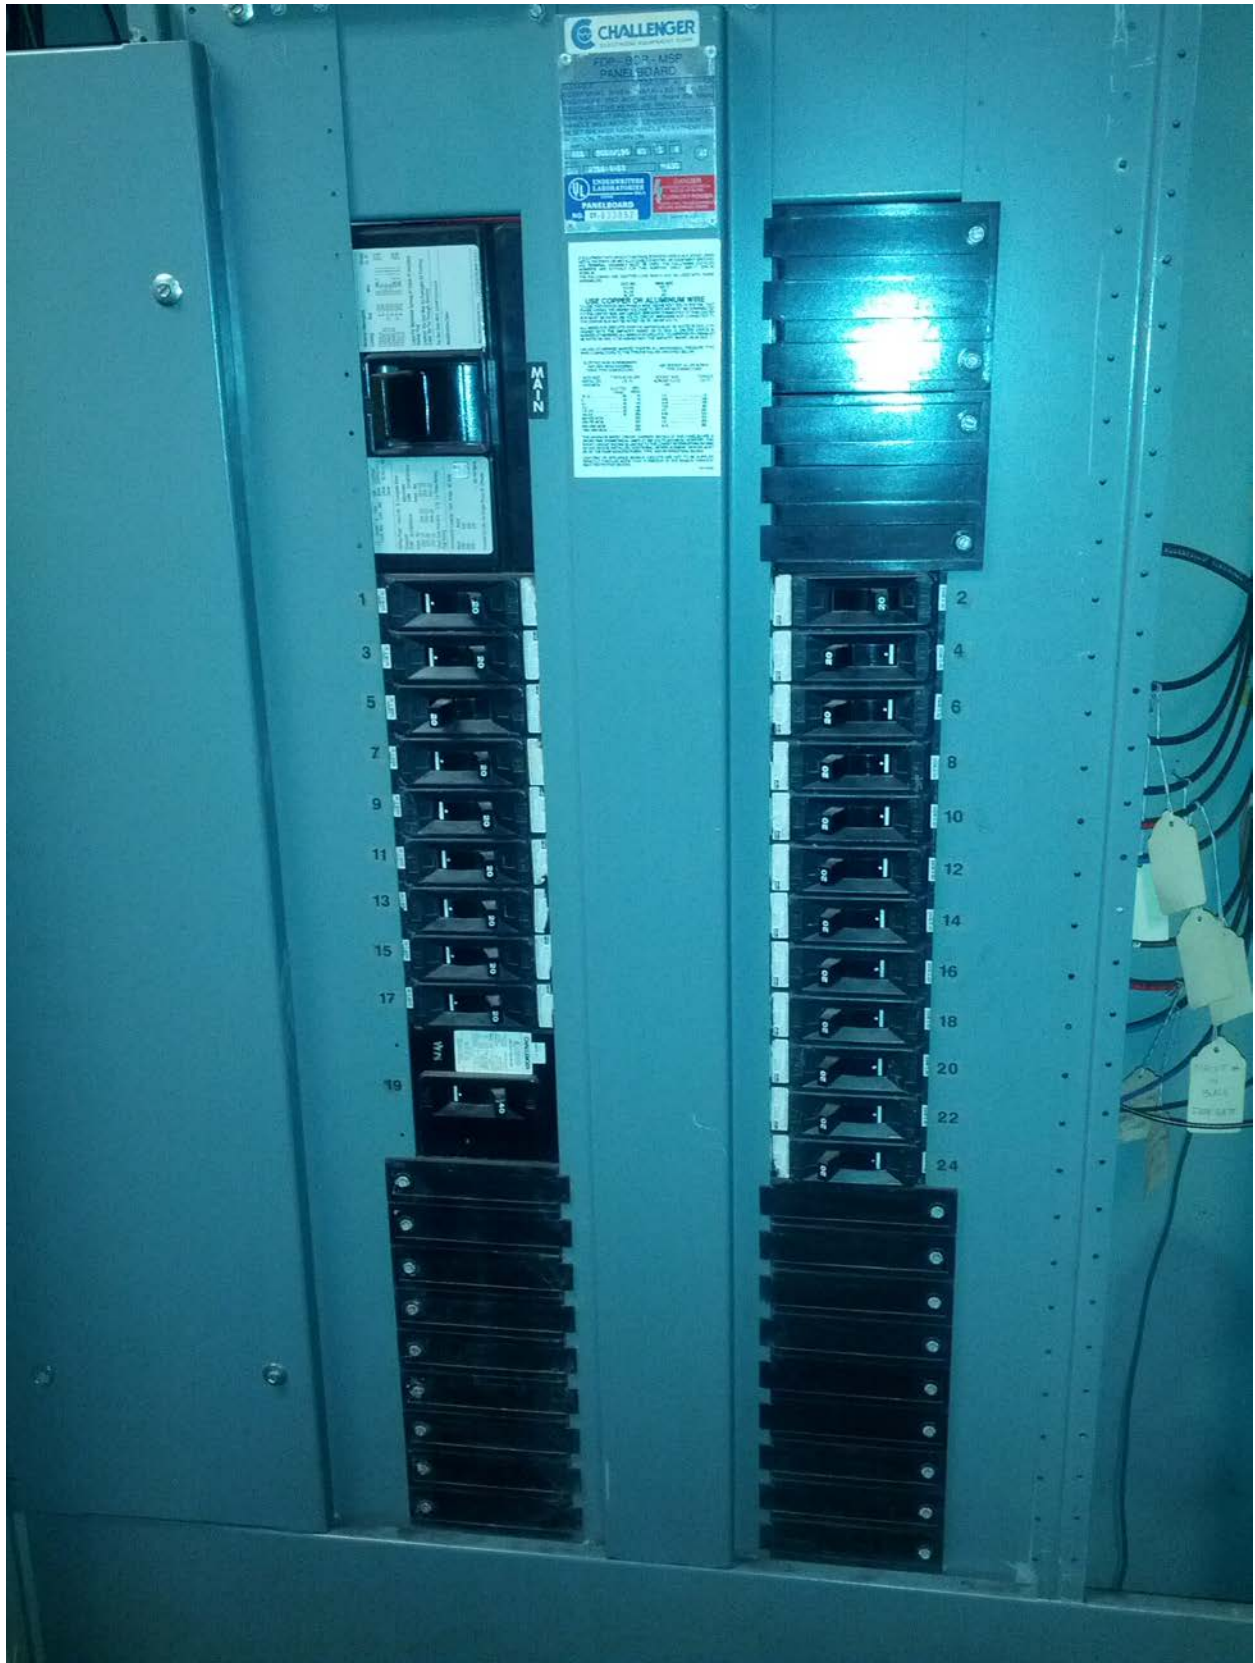


Photo #2: E02 Shaw-Howard U (South) – Top of Panel SF in Room 208

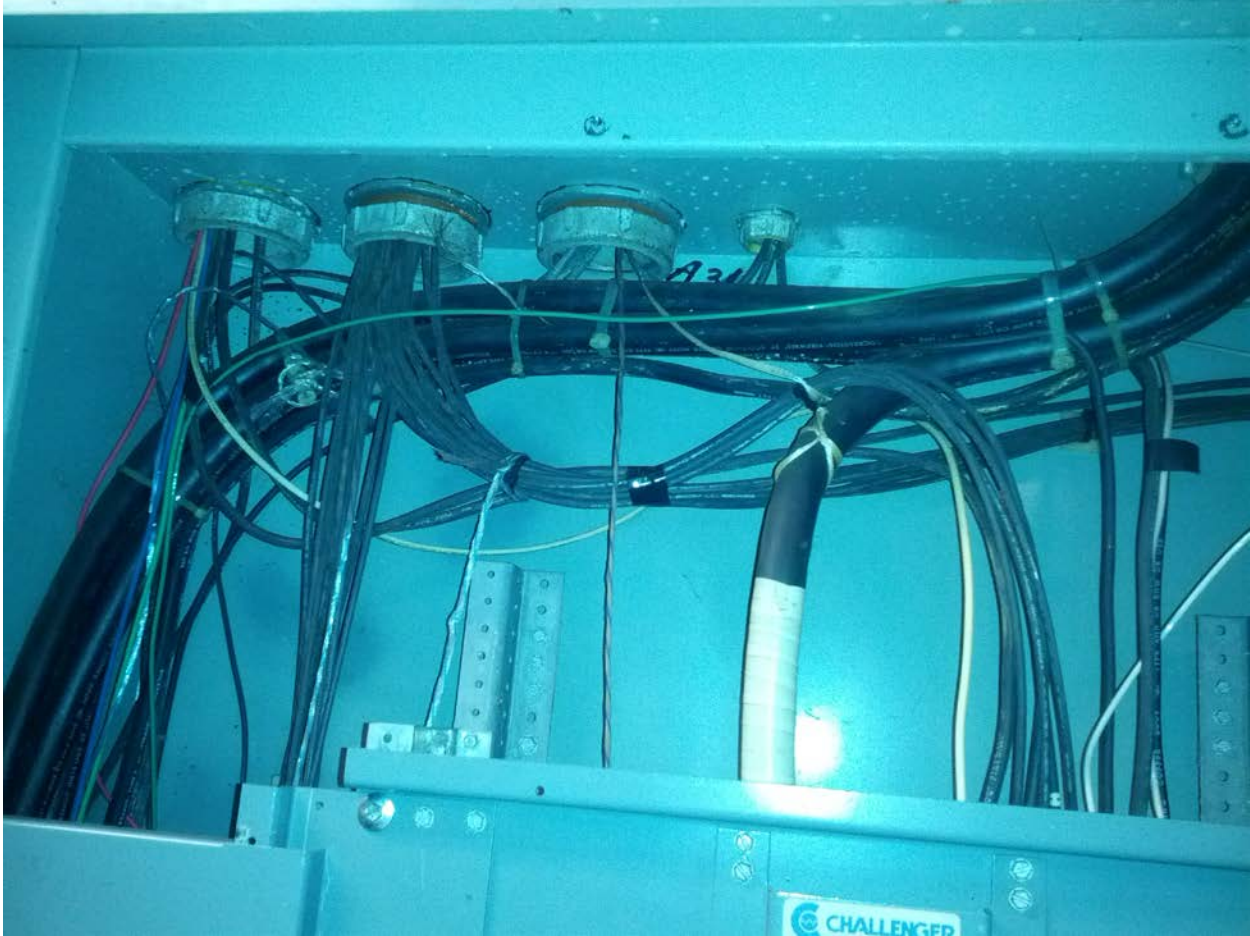


Photo #3: E02 Shaw-Howard U (South) – Junction box and drop to Panel SF in Room 208



Photo #4: E02 Shaw-Howard U (South) – Junction Box and Riser near Room 208



Photo #5: E02 Shaw-Howard U (South) – Junction Box, riser, and walker duct near Room 208



Photo #6: E02 Shaw-Howard U (South) – Conduit Riser near Room 208



Photo #7: E02 Shaw-Howard U (South) – Mezzanine level handhole opposite Room 208



Photo #8: E02 Shaw-Howard U (South) – Mezzanine level handhole



Photo #9: E02 Shaw-Howard U (South) – Mezzanine level handholes



Photo #10: E02 Shaw-Howard U (South) – Mezzanine level handholes

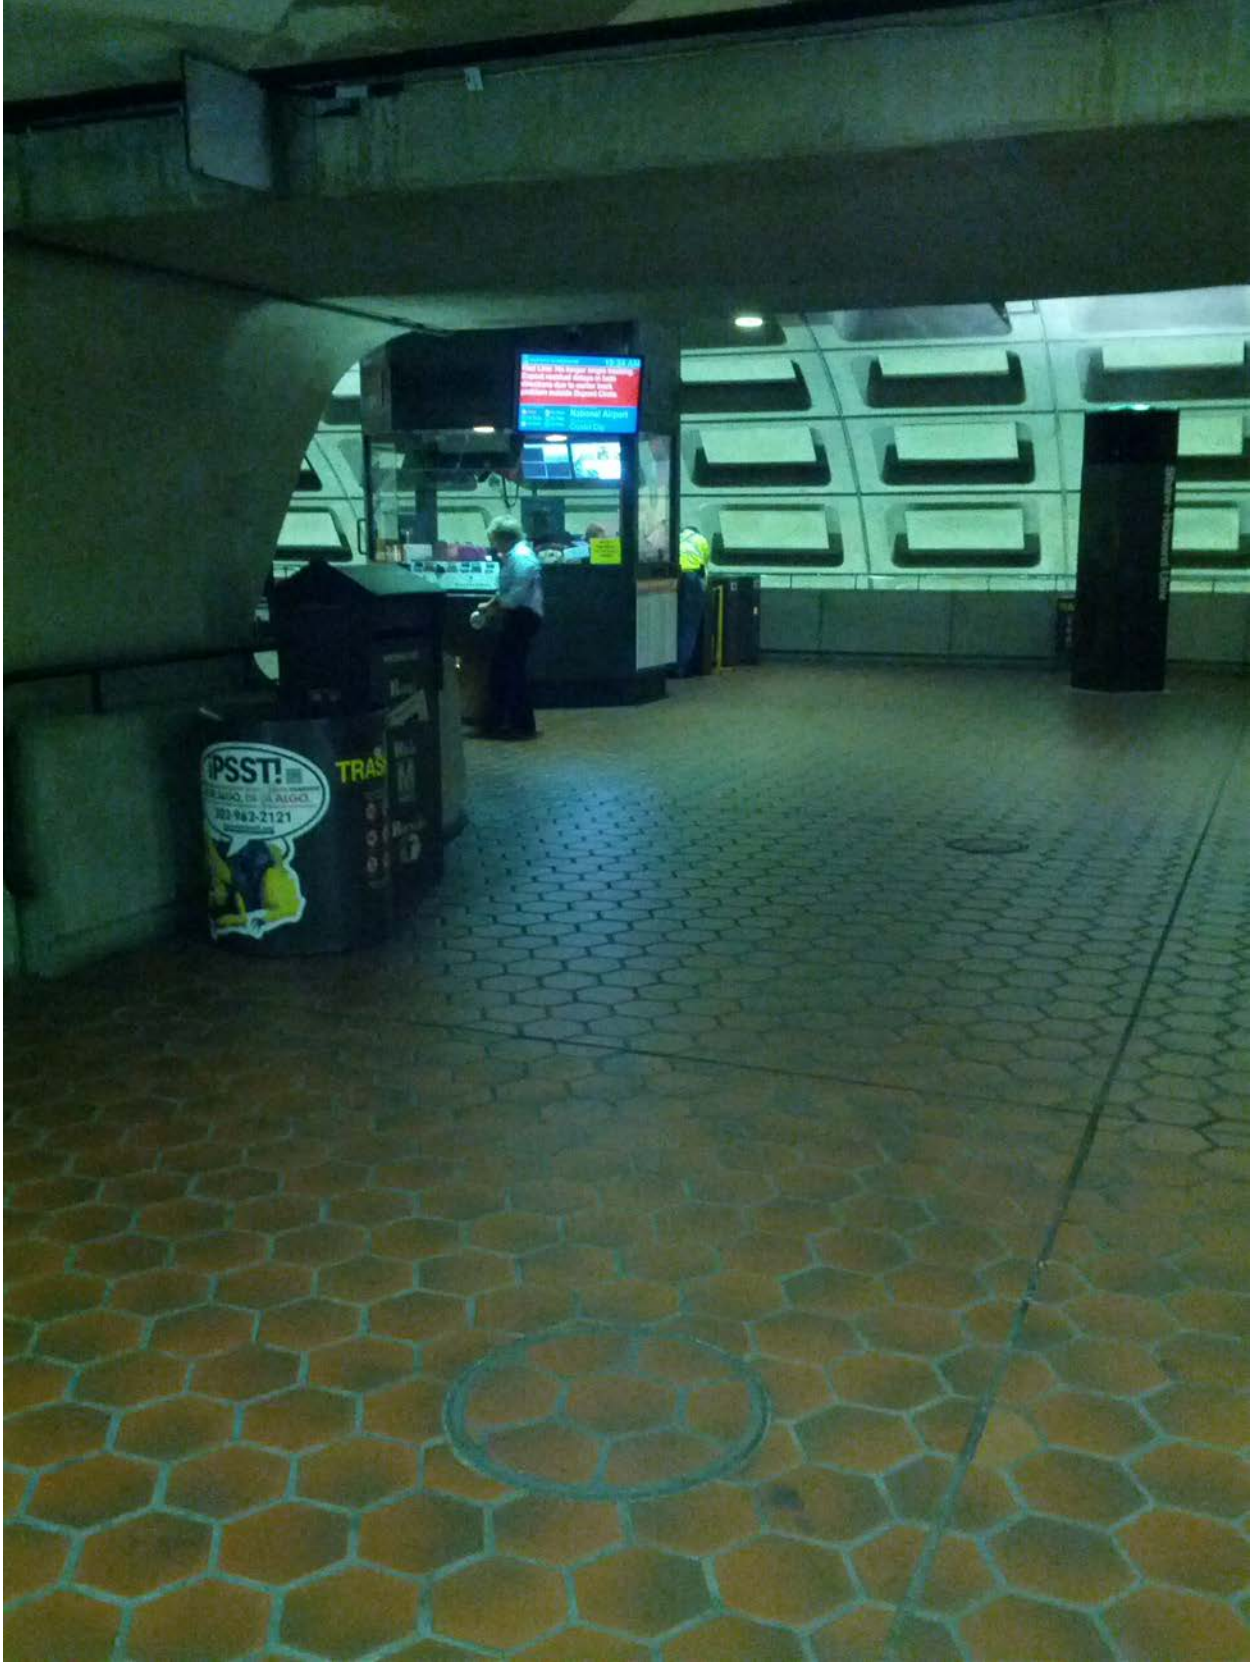


Photo #11: E02 Shaw-Howard U (South) – SWBD Breaker for panel SF



Pre-inspection Field Verification
9/30/2014

| EXISTING PANEL "NF" | | | | | | | | | | |
|---------------------------------|-----|---------------|------|---|---------|----------|------|-----|-----|------------------|
| AMPERES 400 | | VOLTS 120/208 | | MOUNTING: SURFACE | | | | | | |
| MAINS: 250AMCB | | PHASE: 3 | | LOCATION: ELECTRICAL EQUIPMENT ROOM 205 | | | | | | |
| RATING: 10K AIC | | WIRE 4 | | SECTION: 1 OF 1 | | | | | | |
| LOAD DESCRIPTION | KVA | CKT BKRS | | | CKT NO. | CKT BKRS | | | KVA | LOAD DESCRIPTION |
| | | AMP | POLE | NO. | | AMP | POLE | NO. | | |
| EXISTING VENDOR | 0.8 | 20 | 1 | 1 | A | 2 | 1 | 20 | 0.8 | EXISTING VENDOR |
| EXISTING VENDOR | 0.8 | 20 | 1 | 3 | B | 4 | 1 | 20 | 0.8 | EXISTING VENDOR |
| 1 NEW KIOSK RECEPT. (IT & NEPP) | 0.8 | 20 | 1 | 5 | C | 6 | 1 | 20 | 0.8 | EXISTING VENDOR |
| EXISTING VENDOR | 0.8 | 20 | 1 | 7 | A | 8 | 1 | 20 | 0.8 | EXISTING VENDOR |
| EXISTING VENDOR | 0.8 | 20 | 1 | 9 | B | 10 | 1 | 20 | 0.8 | EXISTING VENDOR |
| EXISTING VENDOR | 0.8 | 20 | 1 | 11 | C | 12 | 1 | 20 | 0.8 | EXISTING VENDOR |
| EXISTING VENDOR | 0.8 | 20 | 1 | 13 | A | 14 | 1 | 20 | 0.8 | EXISTING VENDOR |
| 1&2 SPARE (KIOSK) | 0.0 | 20 | 1 | 15 | B | 16 | 1 | 20 | 0.8 | EXISTING VENDOR |
| EXISTING VENDOR | 3.3 | 40 | 3 | 17 | C | 18 | 1 | 20 | 0.8 | EXISTING VENDOR |
| - | 2.5 | - | - | 19 | A | 20 | 1 | 20 | 0.8 | EXISTING VENDOR |
| - | 2.5 | - | - | 21 | B | 22 | 1 | 20 | 0.8 | EXISTING VENDOR |
| SPACE | 0.0 | - | - | 23 | C | 24 | 1 | 20 | 0.8 | EXISTING VENDOR |
| SPACE | 0.0 | - | - | 25 | A | 26 | - | - | 0.0 | SPACE |
| SPACE | 0.0 | - | - | 27 | B | 28 | - | - | 0.0 | SPACE |
| SPACE | 0.0 | - | - | 29 | C | 30 | - | - | 0.0 | SPACE |
| SPACE | 0.0 | - | - | 31 | A | 32 | - | - | 0.0 | SPACE |
| SPACE | 0.0 | - | - | 33 | B | 34 | - | - | 0.0 | SPACE |
| SPACE | 0.0 | - | - | 35 | C | 36 | - | - | 0.0 | SPACE |
| SPACE | 0.0 | - | - | 37 | A | 38 | - | - | 0.0 | SPACE |
| SPACE | 0.0 | - | - | 39 | B | 40 | - | - | 0.0 | SPACE |
| SPACE | 0.0 | - | - | 41 | C | 42 | - | - | 0.0 | SPACE |

NOTES: 1. CONNECT NEW FEEDER TO EXISTING SPARE 20A, 1P CB
2. CB TO BE RESERVED FOR FUTURE AFC

LOAD SUMMARY

| | | |
|-------------------------------------|-----------------|------------------------------------|
| LIGHTS | 0.0 x 125% | 0.0 KVA |
| RECEPTACLES, FIRST 10 KVA | 10.0 x 100% | 10.0 KVA |
| RECEPTACLES | 6.0 x 50% | 3.0 KVA |
| MISC APPLIANCES | 0.0 x 100% | 0.0 KVA |
| LARGEST MOTOR | 0.0 x 125% | 0.0 KVA |
| MOTORS | 0.0 x 100% | 0.0 KVA |
| HEAT | 3.0 x 125% | 3.8 KVA |
| AC | 4.5 x 100% | 4.5 KVA |
| WATER HEATING | 0.0 x 125% | 0.0 KVA |
| TOTAL CONNECTED LOAD | 23.5 KVA | TOTAL DEMAND KVA 21.3 KVA |
| | | TOTAL DEMAND AMPS 59.0 AMPS |
| CONNECTED LOAD PHASE SUMMARY | | |
| PHASE A | 8.1 KVA | |
| PHASE B | 7.3 KVA | |
| PHASE C | 8.1 KVA | |

NOTES: A. EXISTING PANEL "NF" IS FED FROM 277/480V, 3Ø, 4W EXISTING SWITCHBOARD "NSB" LOCATED IN AC SWBD. ROOM 223, #6-125/3P VIA 75KVA TRANSFORMER (SEE ATTACHED DWG. MM-E-E08).

- B. EXISTING WIRING FED FROM TOP OF PANEL BY:
 * 1-4" C. TO TRANSFORMER (1-WIRING FILL >40%).
 * 3-3" C. (1-EMPTY & 2-WIRING FILL >40%).
 * 2-3/4" C. (WIRING FILL >40%).

Rm 220 - Track 2 Wayside
Essential Circuit #5

| EXISTING PANEL "SF" ✓ | | | | | | | | | | |
|---------------------------------|-----|---------------|------|---|---------|----------|------|-----|-----|------------------|
| AMPERES 400 | | VOLTS 120/208 | | MOUNTING: SURFACE | | | | | | |
| MAINS: 250AMCB | | PHASE: 3 | | LOCATION: ELECTRICAL EQUIPMENT ROOM 208 ✓ | | | | | | |
| RATING: 10K AIC | | WIRE 4 | | SECTION: 1 OF 1 | | | | | | |
| LOAD DESCRIPTION | KVA | CKT BKRS | | | CKT NO. | CKT BKRS | | | KVA | LOAD DESCRIPTION |
| | | AMP | POLE | NO. | | AMP | POLE | NO. | | |
| EXISTING VENDOR | 0.8 | 20 | 1 | 1 | A | 2 | 1 | 20 | 0.8 | EXISTING VENDOR |
| EXISTING VENDOR | 0.8 | 20 | 1 | 3 | B | 4 | 1 | 20 | 0.8 | EXISTING VENDOR |
| EXISTING VENDOR | 0.8 | 20 | 1 | 5 | C | 6 | 1 | 20 | 0.8 | EXISTING VENDOR |
| EXISTING VENDOR | 0.8 | 20 | 1 | 7 | A | 8 | 1 | 20 | 0.8 | EXISTING VENDOR |
| EXISTING VENDOR | 0.8 | 20 | 1 | 9 | B | 10 | 1 | 20 | 0.8 | EXISTING VENDOR |
| EXISTING VENDOR | 0.8 | 20 | 1 | 11 | C | 12 | 1 | 20 | 0.8 | EXISTING VENDOR |
| EXISTING VENDOR | 0.8 | 20 | 1 | 13 | A | 14 | 1 | 20 | 0.8 | EXISTING VENDOR |
| EXISTING VENDOR | 0.8 | 20 | 1 | 15 | B | 16 | 1 | 20 | 0.8 | EXISTING VENDOR |
| EXISTING VENDOR | 0.8 | 20 | 1 | 17 | C | 18 | 1 | 20 | 0.8 | EXISTING VENDOR |
| EXIST LOAD CENTER "KES" | 3.3 | 40 | 3 | 19 | A | 20 | 1 | 20 | 0.8 | EXISTING VENDOR |
| - | 2.5 | - | - | 21 | B | 22 | 1 | 20 | 0.8 | EXISTING VENDOR |
| - | 2.5 | - | - | 23 | C | 24 | 1 | 20 | 0.8 | EXISTING VENDOR |
| 1 NEW KIOSK RECEPT. (IT & NEPP) | 0.8 | 20 | 1 | 25 | A | 26 | - | - | 0.0 | SPACE |
| 1&2 SPARE (KIOSK) | 0.0 | 20 | 1 | 27 | B | 28 | - | - | 0.0 | SPACE |
| SPACE | 0.0 | - | - | 29 | C | 30 | - | - | 0.0 | SPACE |
| SPACE | 0.0 | - | - | 31 | A | 32 | - | - | 0.0 | SPACE |
| SPACE | 0.0 | - | - | 33 | B | 34 | - | - | 0.0 | SPACE |
| SPACE | 0.0 | - | - | 35 | C | 36 | - | - | 0.0 | SPACE |
| SPACE | 0.0 | - | - | 37 | A | 38 | - | - | 0.0 | SPACE |
| SPACE | 0.0 | - | - | 39 | B | 40 | - | - | 0.0 | SPACE |
| SPACE | 0.0 | - | - | 41 | C | 42 | - | - | 0.0 | SPACE |

NOTES: 1. PROVIDE 2-NEW 20A, 1P CB IN AVAILABLE SPACES (NEW CB'S SHALL MATCH EXISTING CB'S)
AND CONNECT NEW FEEDER TO 2-NEW CB
2. CB TO BE RESERVED FOR FUTURE AFC

LOAD SUMMARY

| | | |
|-------------------------------------|-----------------|------------------------------------|
| LIGHTS | 0.0 x 125% | 0.0 KVA |
| RECEPTACLES, FIRST 10 KVA | 10.0 x 100% | 10.0 KVA |
| RECEPTACLES | 8.4 x 50% | 4.2 KVA |
| MISC APPLIANCES | 0.0 x 100% | 0.0 KVA |
| LARGEST MOTOR | 0.0 x 125% | 0.0 KVA |
| MOTORS | 0.0 x 100% | 0.0 KVA |
| HEAT | 3.0 x 125% | 3.8 KVA |
| AC | 4.5 x 100% | 4.5 KVA |
| WATER HEATING | 0.0 x 125% | 0.0 KVA |
| TOTAL CONNECTED LOAD | 25.9 KVA | TOTAL DEMAND KVA 22.5 KVA |
| | | TOTAL DEMAND AMPS 62.4 AMPS |
| CONNECTED LOAD PHASE SUMMARY | | |
| PHASE A | 9.7 KVA | |
| PHASE B | 8.1 KVA | |
| PHASE C | 8.1 KVA | |

NOTES: A. EXISTING PANEL "SF" IS FED FROM 277/480V, 3Ø, 4W EXISTING SWITCHBOARD "SSB" LOCATED IN AC SWBD. ROOM 220, #6-125/3P VIA 75KVA TRANSFORMER (SEE ATTACHED DWG. MM-E-E08).

- B. EXISTING WIRING FED FROM TOP OF PANEL BY:
 * 1-4" C. TO TRANSFORMER (1-WIRING FILL >40%).
 * 3-3" C. (1-EMPTY & 2-WIRING FILL >40%).
 * 2-3/4" C. (WIRING FILL >40%).

CONTRACT NO
14-FQ10060-CENI-24

| DESIGNED | C. NDO | 08-14 | REFERENCE DRAWINGS | | REVISIONS | |
|----------|--------|-------|--------------------|-------------|-----------|----|
| | | | NUMBER | DESCRIPTION | DATE | BY |
| DATE | | | | | | |
| DRAWN | C. NDO | 08-14 | | | | |
| DATE | | | | | | |
| CHECKED | B. DLB | 08-14 | | | | |
| DATE | | | | | | |
| APPROVED | N/A | | | | | |
| DATE | | | | | | |

WASHINGTON METROPOLITAN AREA TRANSIT AUTHORITY

DEPARTMENT OF TRANSIT INFRASTRUCTURE
AND ENGINEERING SERVICES
OFFICE OF INFRASTRUCTURE RENEWAL PROGRAM

GFP A Gambro Fleming/Parsons
JOINT VENTURE



APPROVED _____

SUBMITTED _____
PROJECT MANAGER

NEW ELECTRONIC PAY PROGRAM (NEPP)
IN METRORAIL STATIONS
SHAW - NORTH & SOUTH
PANEL SCHEDULES

SCALE
NOT TO SCALE

DRAWING NO.
E02-E-102

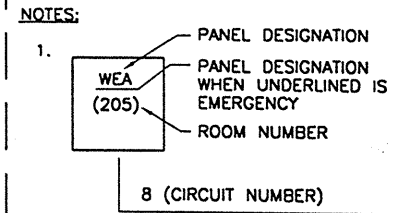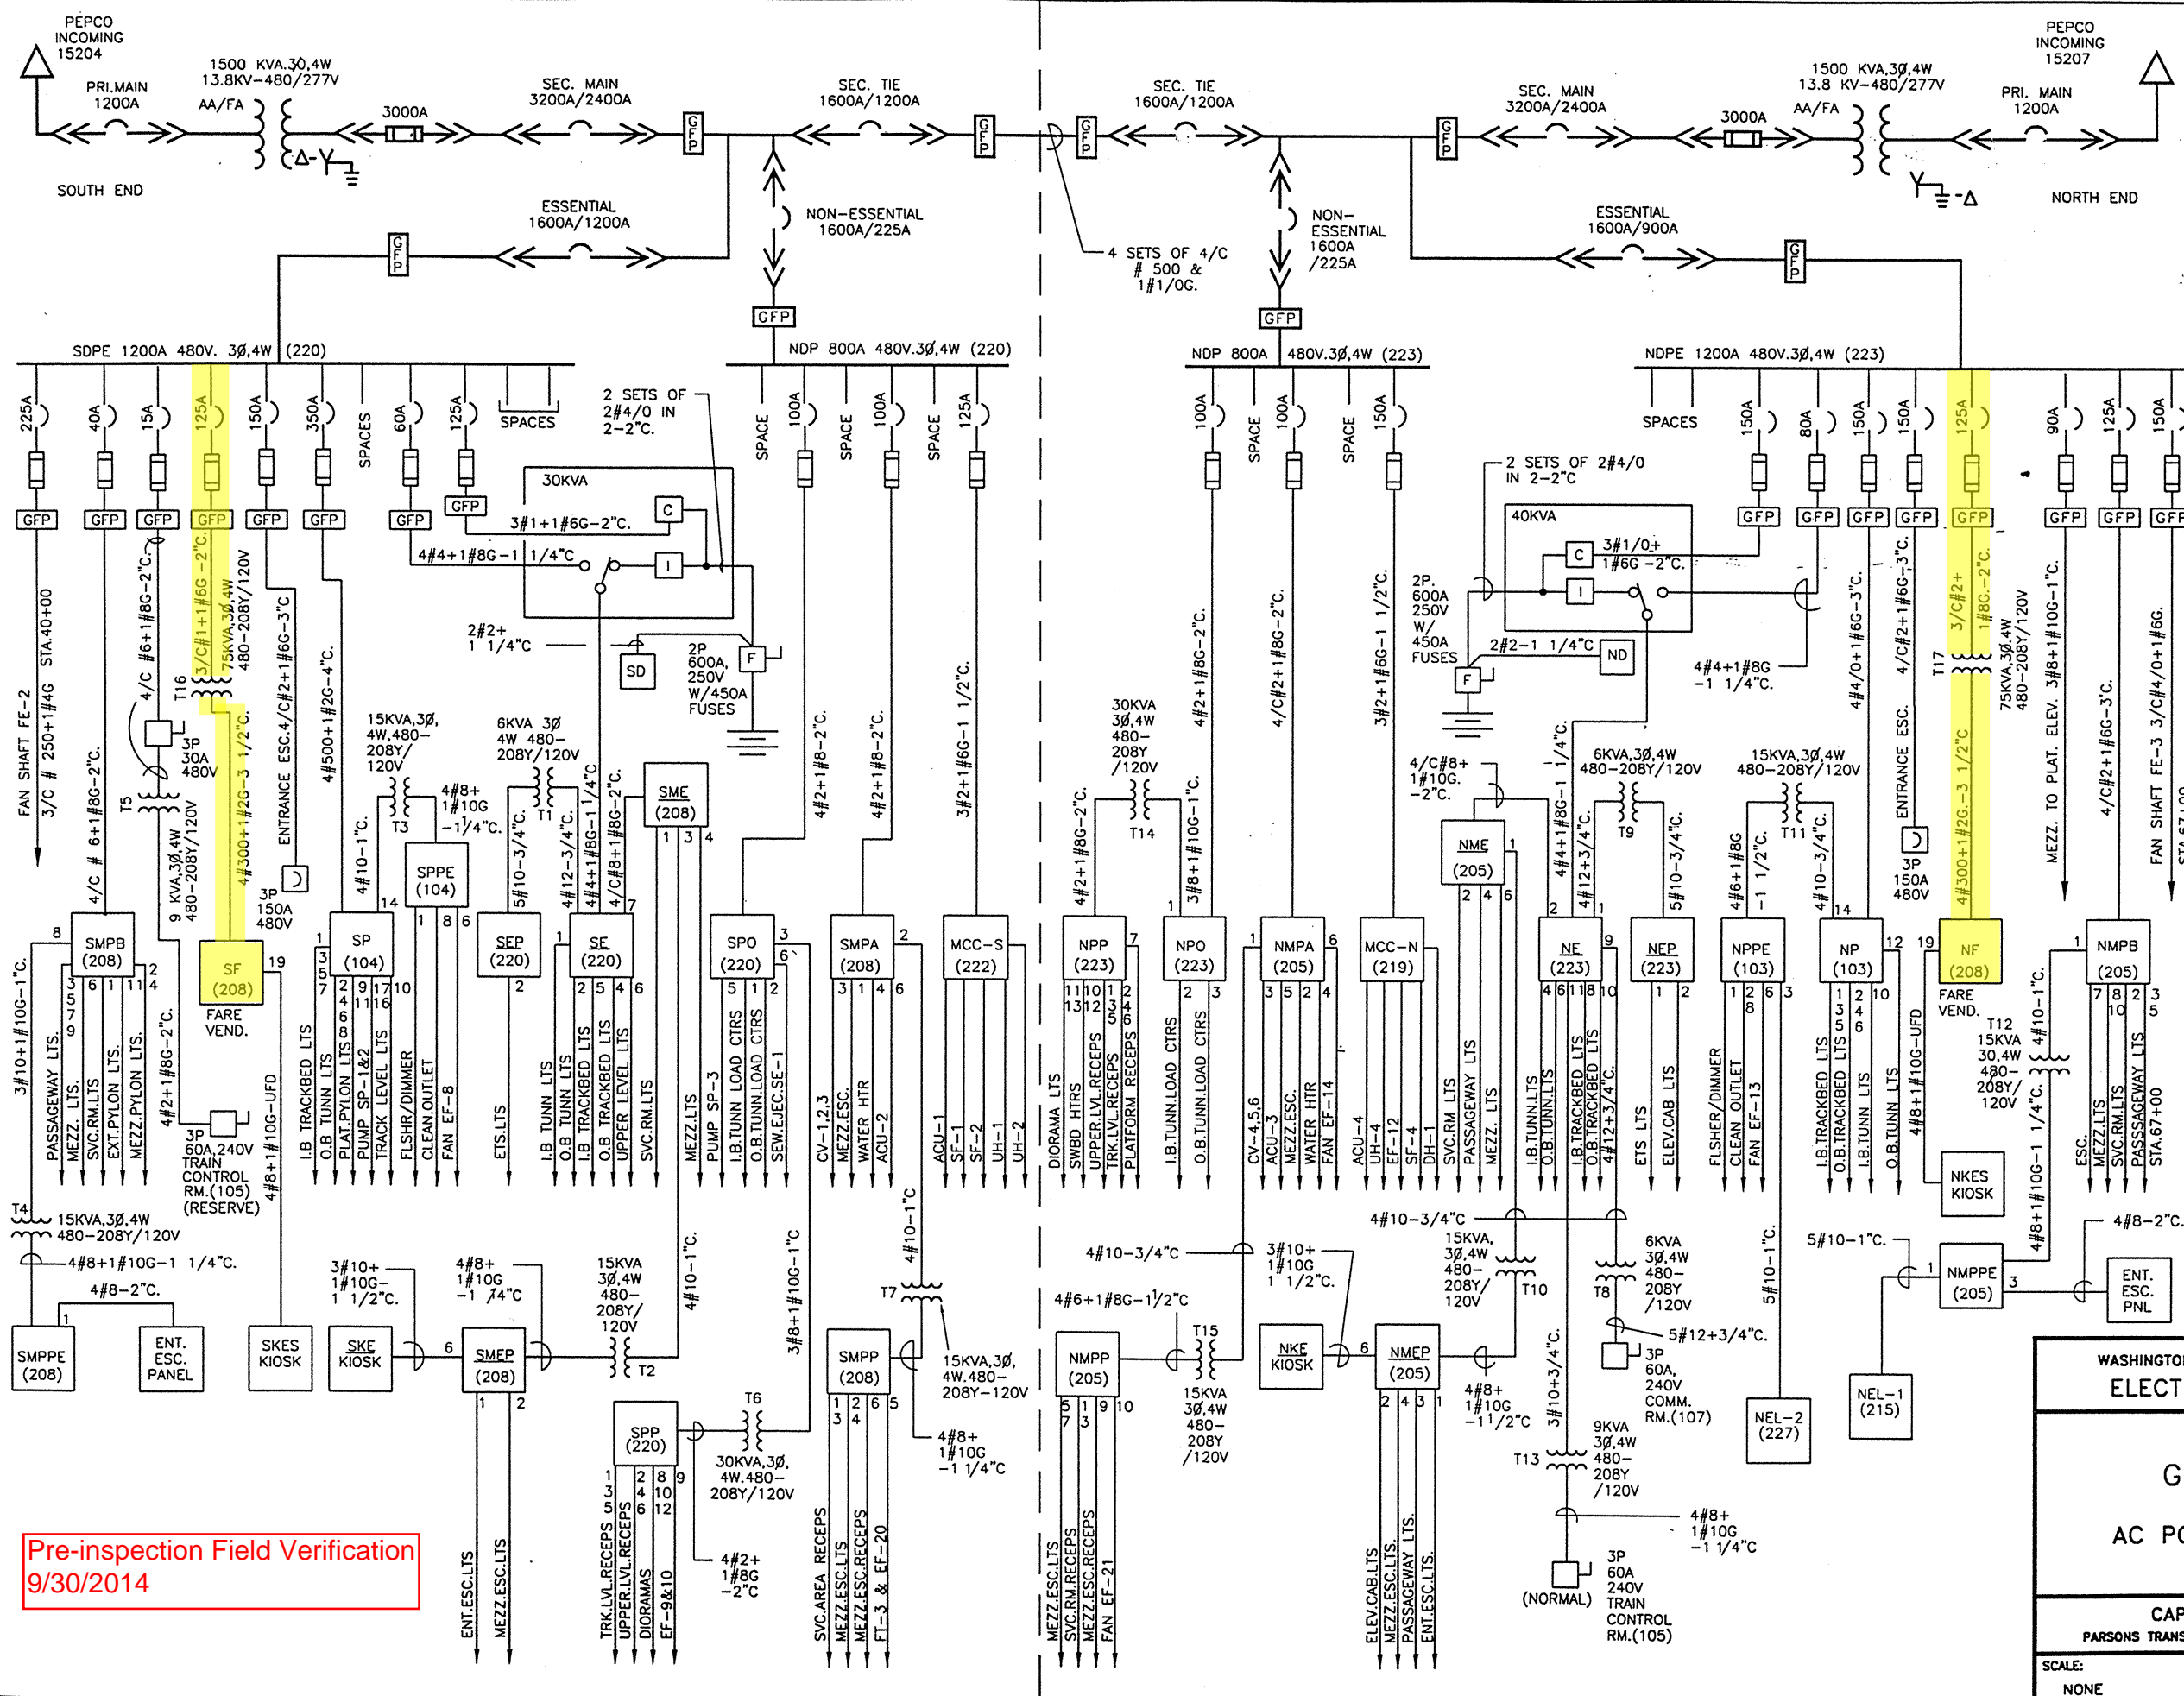

- NOTES:**
1. PANEL DESIGNATION WHEN UNDERLINED IS EMERGENCY
ROOM NUMBER
 2. 3#2, 2" CONDUIT SIZE
AWG OR KCMIL CIRCUIT WIRES
AS TAKEN FROM AS BUILT DWGS.
 3. CIRCUIT BREAKERS
DRAW OUT ←→ 1600A/1200A
FRAME SIZE CONTINUOUS CURRENT SETTING
 4. 4/C # 4/0
INDICATES MULTICONDUCTOR CABLE WITH 4 CONDUCTORS AND SIZE OF EACH 4/0
 5. INDICATES FUSE CURRENT LIMITER AT BREAKER
 6. SWITCHGEAR INFORMATION:
MANUFACTURER—WESTINGHOUSE
ORDER NO.—VN-10001
DWG. NO.—ST88D1360 (NORTH)
DWG. NO.—ST88D1361 (SOUTH)
 7. UPS MANUFACTURER:
HDR POWER SYSTEMS
 8. ROOM DESIGNATIONS:

| ROOM | DESCRIPTION |
|------|----------------------------|
| 103 | N. MECH.RM.(TRACK LEVEL) |
| 104 | S. MECH.RM.(TRACK LEVEL) |
| 105 | TRAIN CONTROL RM. |
| 107 | COMM.RM. |
| 205 | ELEC.RM.(S. ENT.MEZZ.) |
| 208 | ELEC.RM.(N. ENT.MEZZ.) |
| 215 | N. ENT. ELEV.MACH. RM. |
| 219 | MECH.RM.(N. UPPER LEVEL) |
| 220 | S. A.C.RM.(S. UPPER LEVEL) |
| 222 | MECH.RM.(S. UPPER LEVEL) |
| 223 | N. A.C.RM.(N. UPPER LEVEL) |
| 227 | S. SVC. AREA ELEV.MACH.RM. |

| REVISIONS | | |
|-----------|----|-------------|
| DATE | BY | DESCRIPTION |
| | | |
| | | |
| | | |

WASHINGTON METROPOLITAN AREA TRANSIT AUTHORITY
ELECTRICAL MAINTENANCE MAP

GREENBELT ROUTE
SHAW STATION
AC POWER ONE LINE DIAGRAM

CAPITAL IMPROVEMENT PROGRAM
PARSONS TRANSPORTATION GROUP - CAPITAL TRANSIT CONSULTANTS

| | |
|----------------|-------------------------|
| SCALE: NONE | DRAWING No. MM-E-E08 |
|----------------|-------------------------|

Pre-inspection Field Verification
9/30/2014